10-7 00011
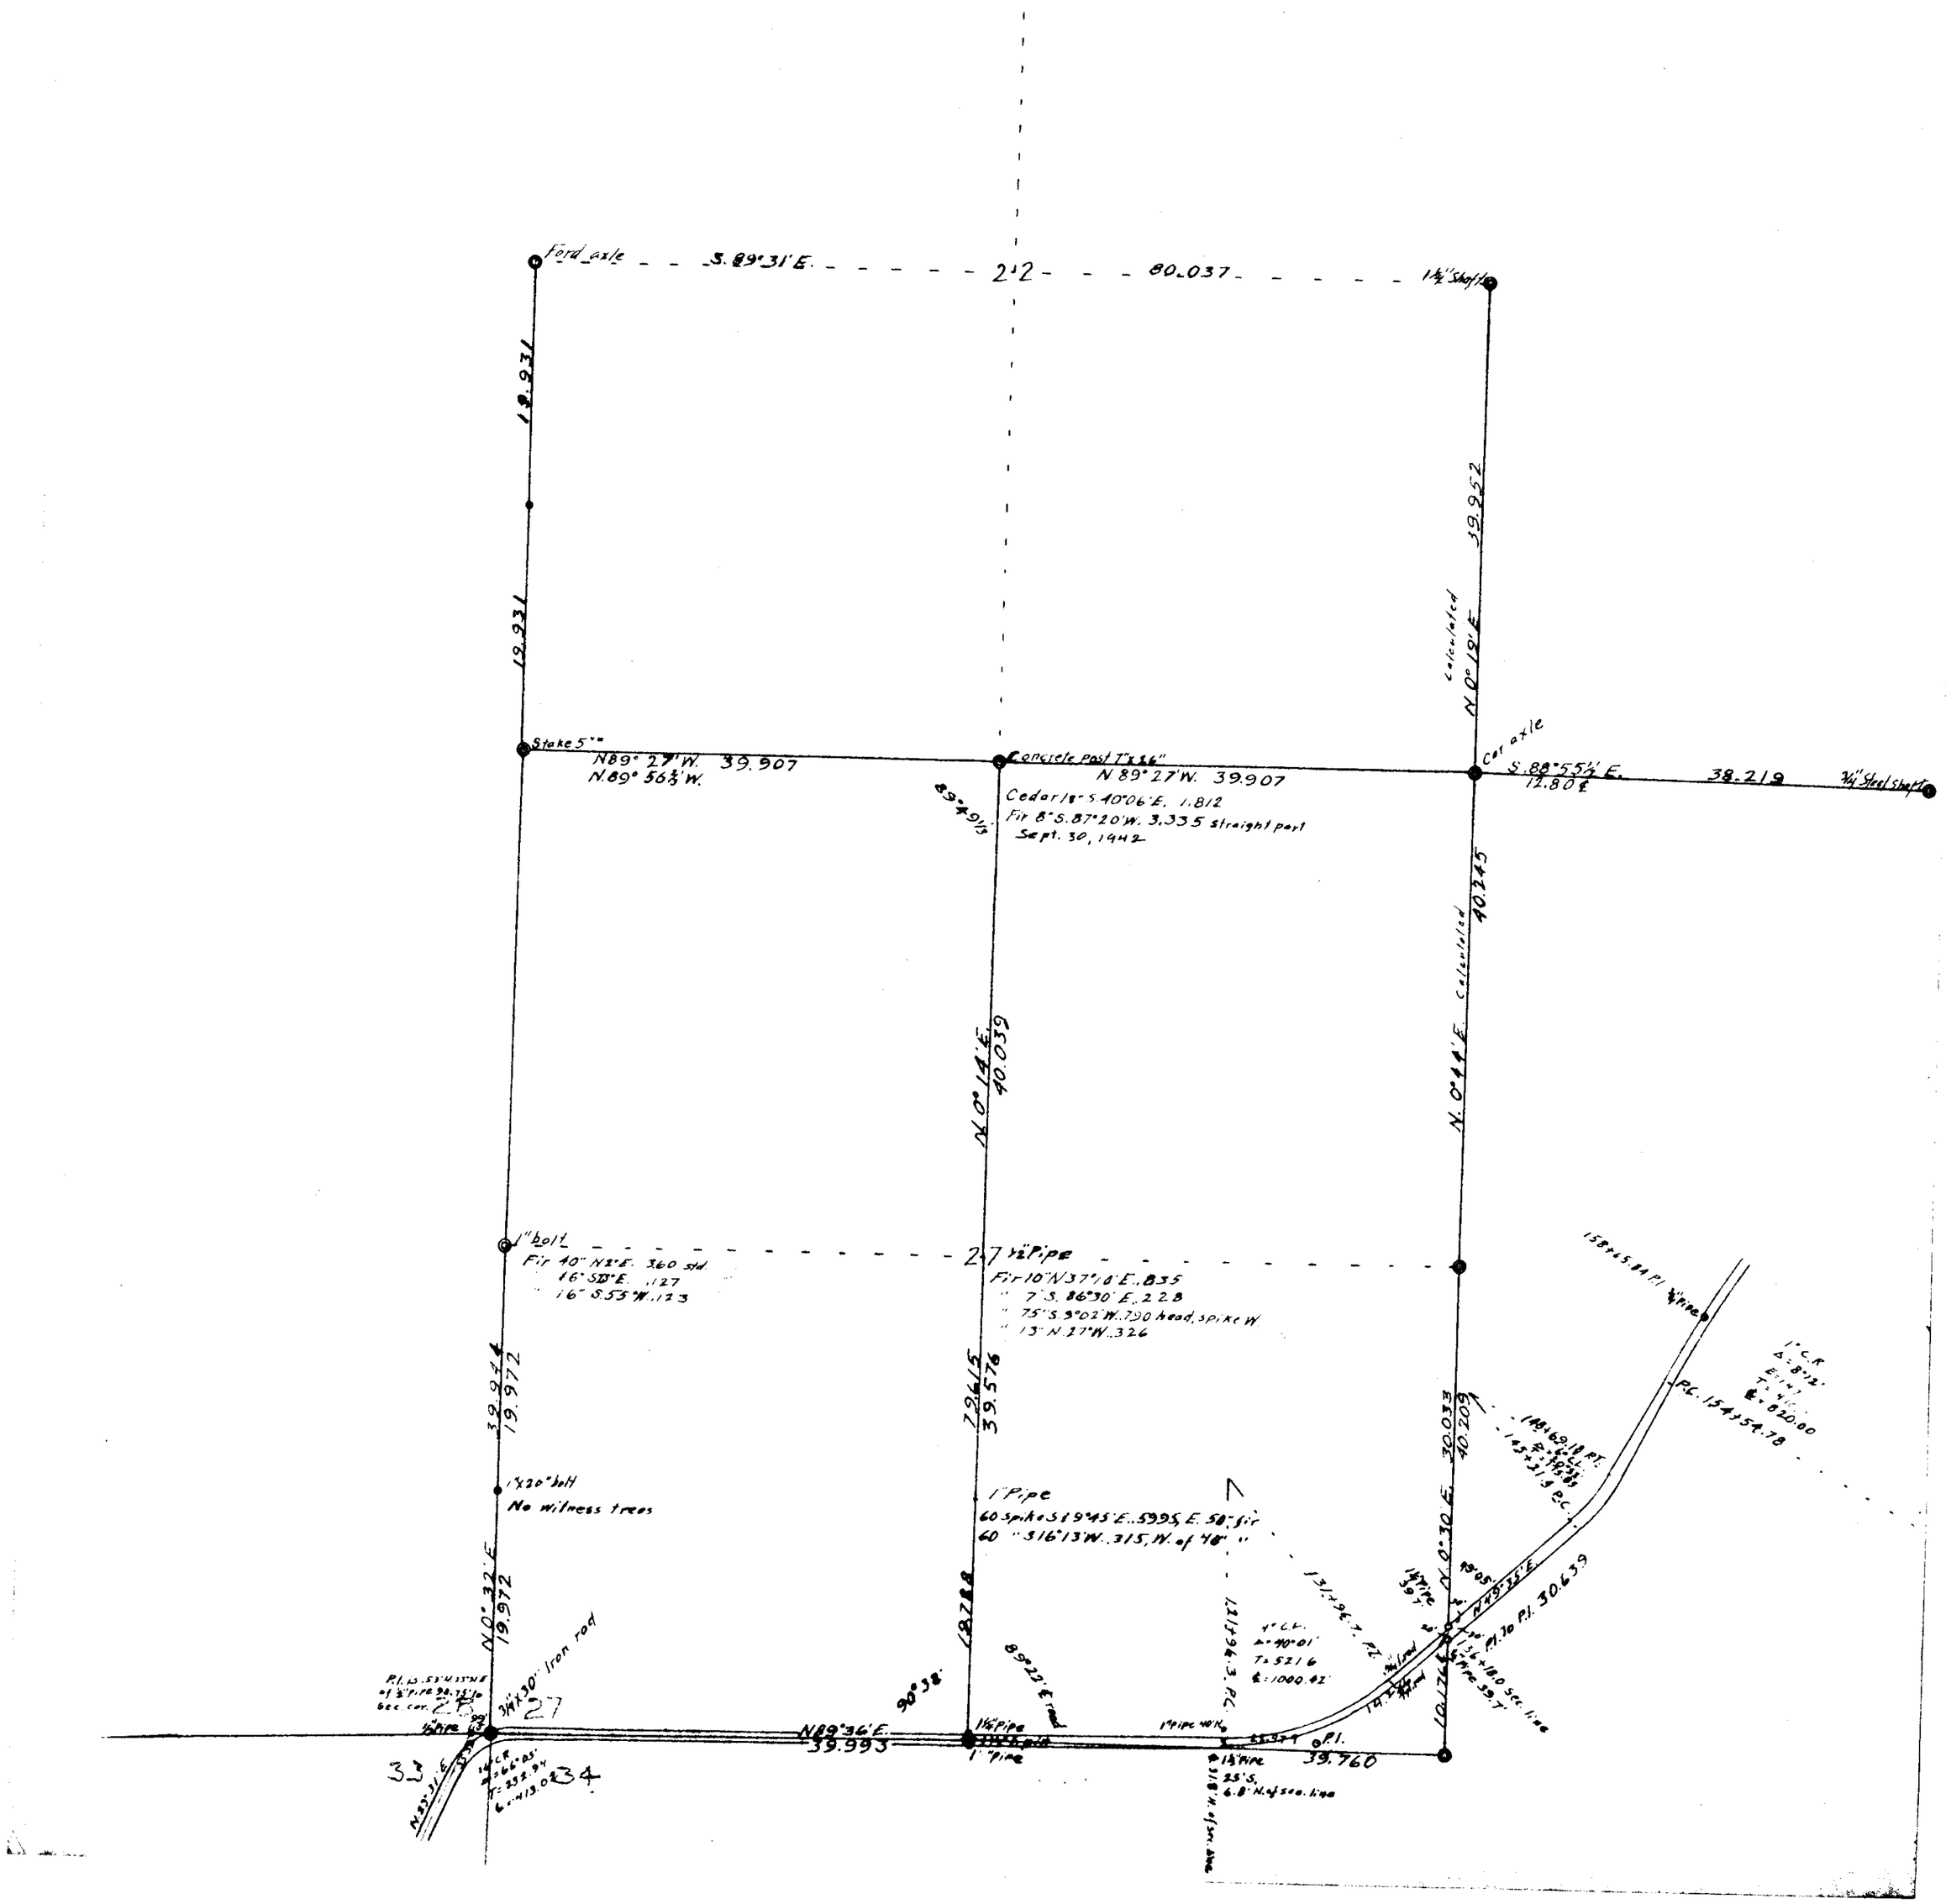
22-27