10-7
25 00013

ROAD #626

SCALE 1" = 200'
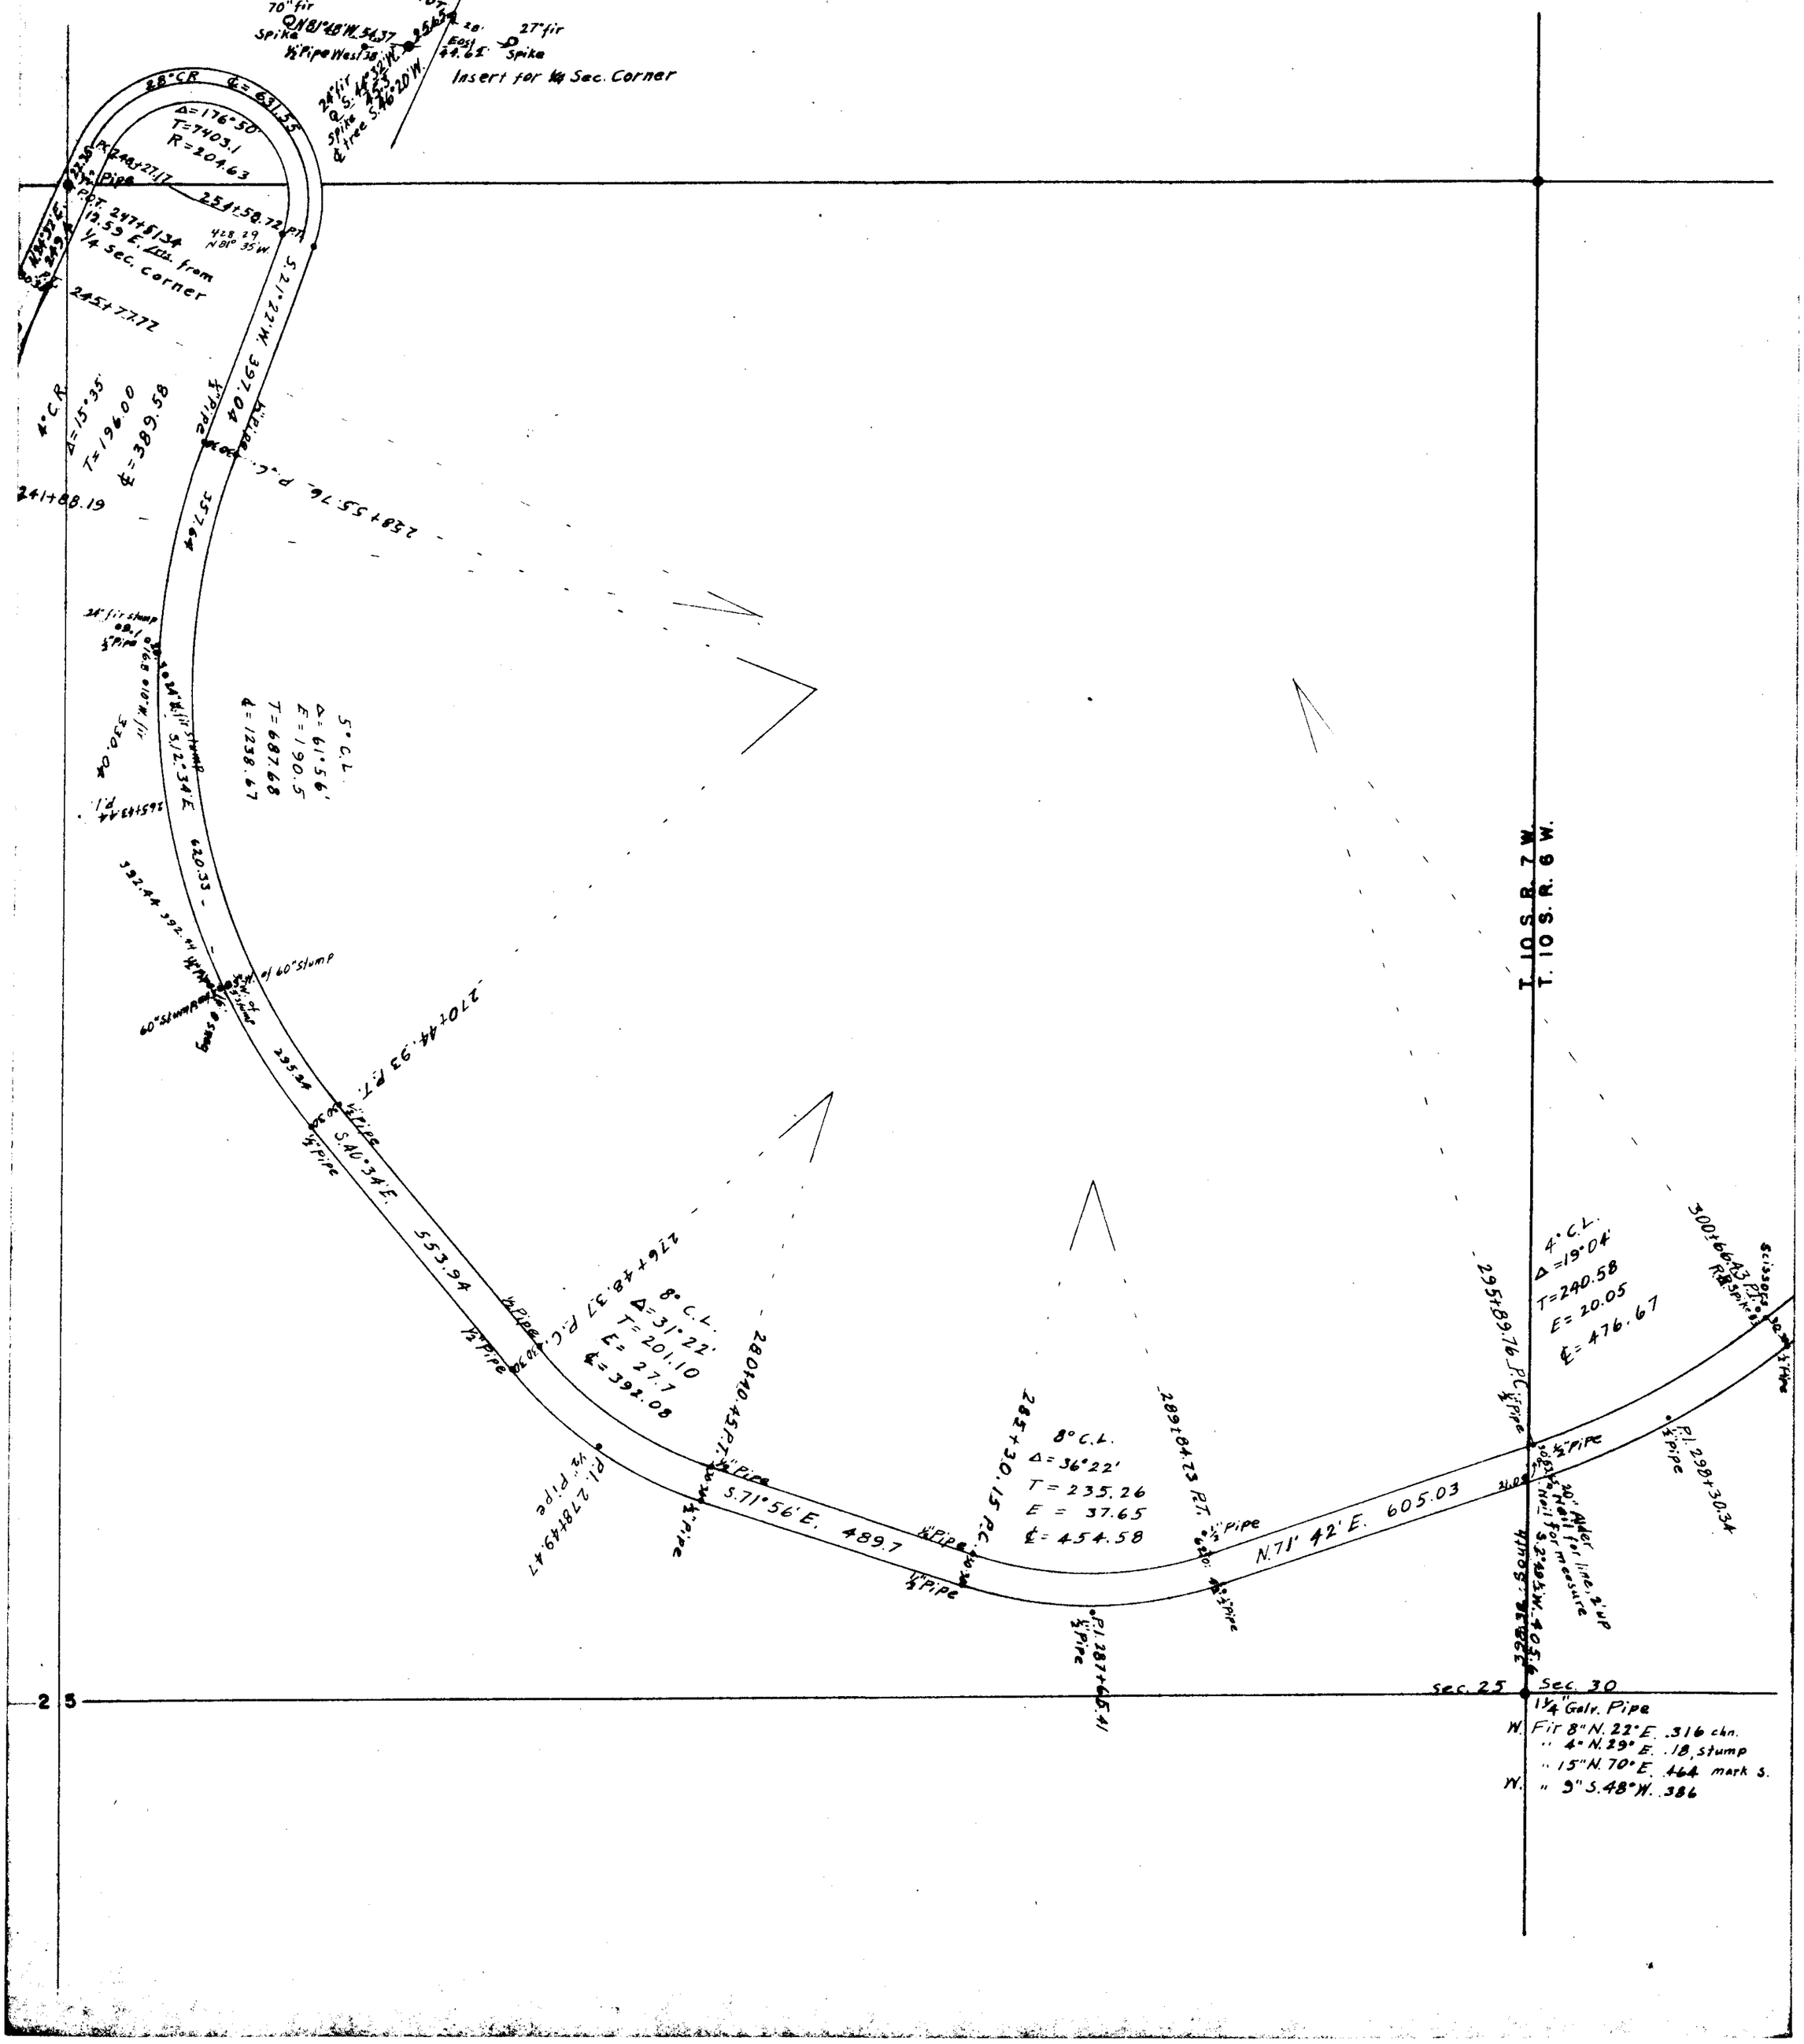
W.C. Galloway Co. Engr.
Dec. 9, 1947.