


11-3+4 11-3&4-00003
1+6
1" = 264 ft

C.S. 277

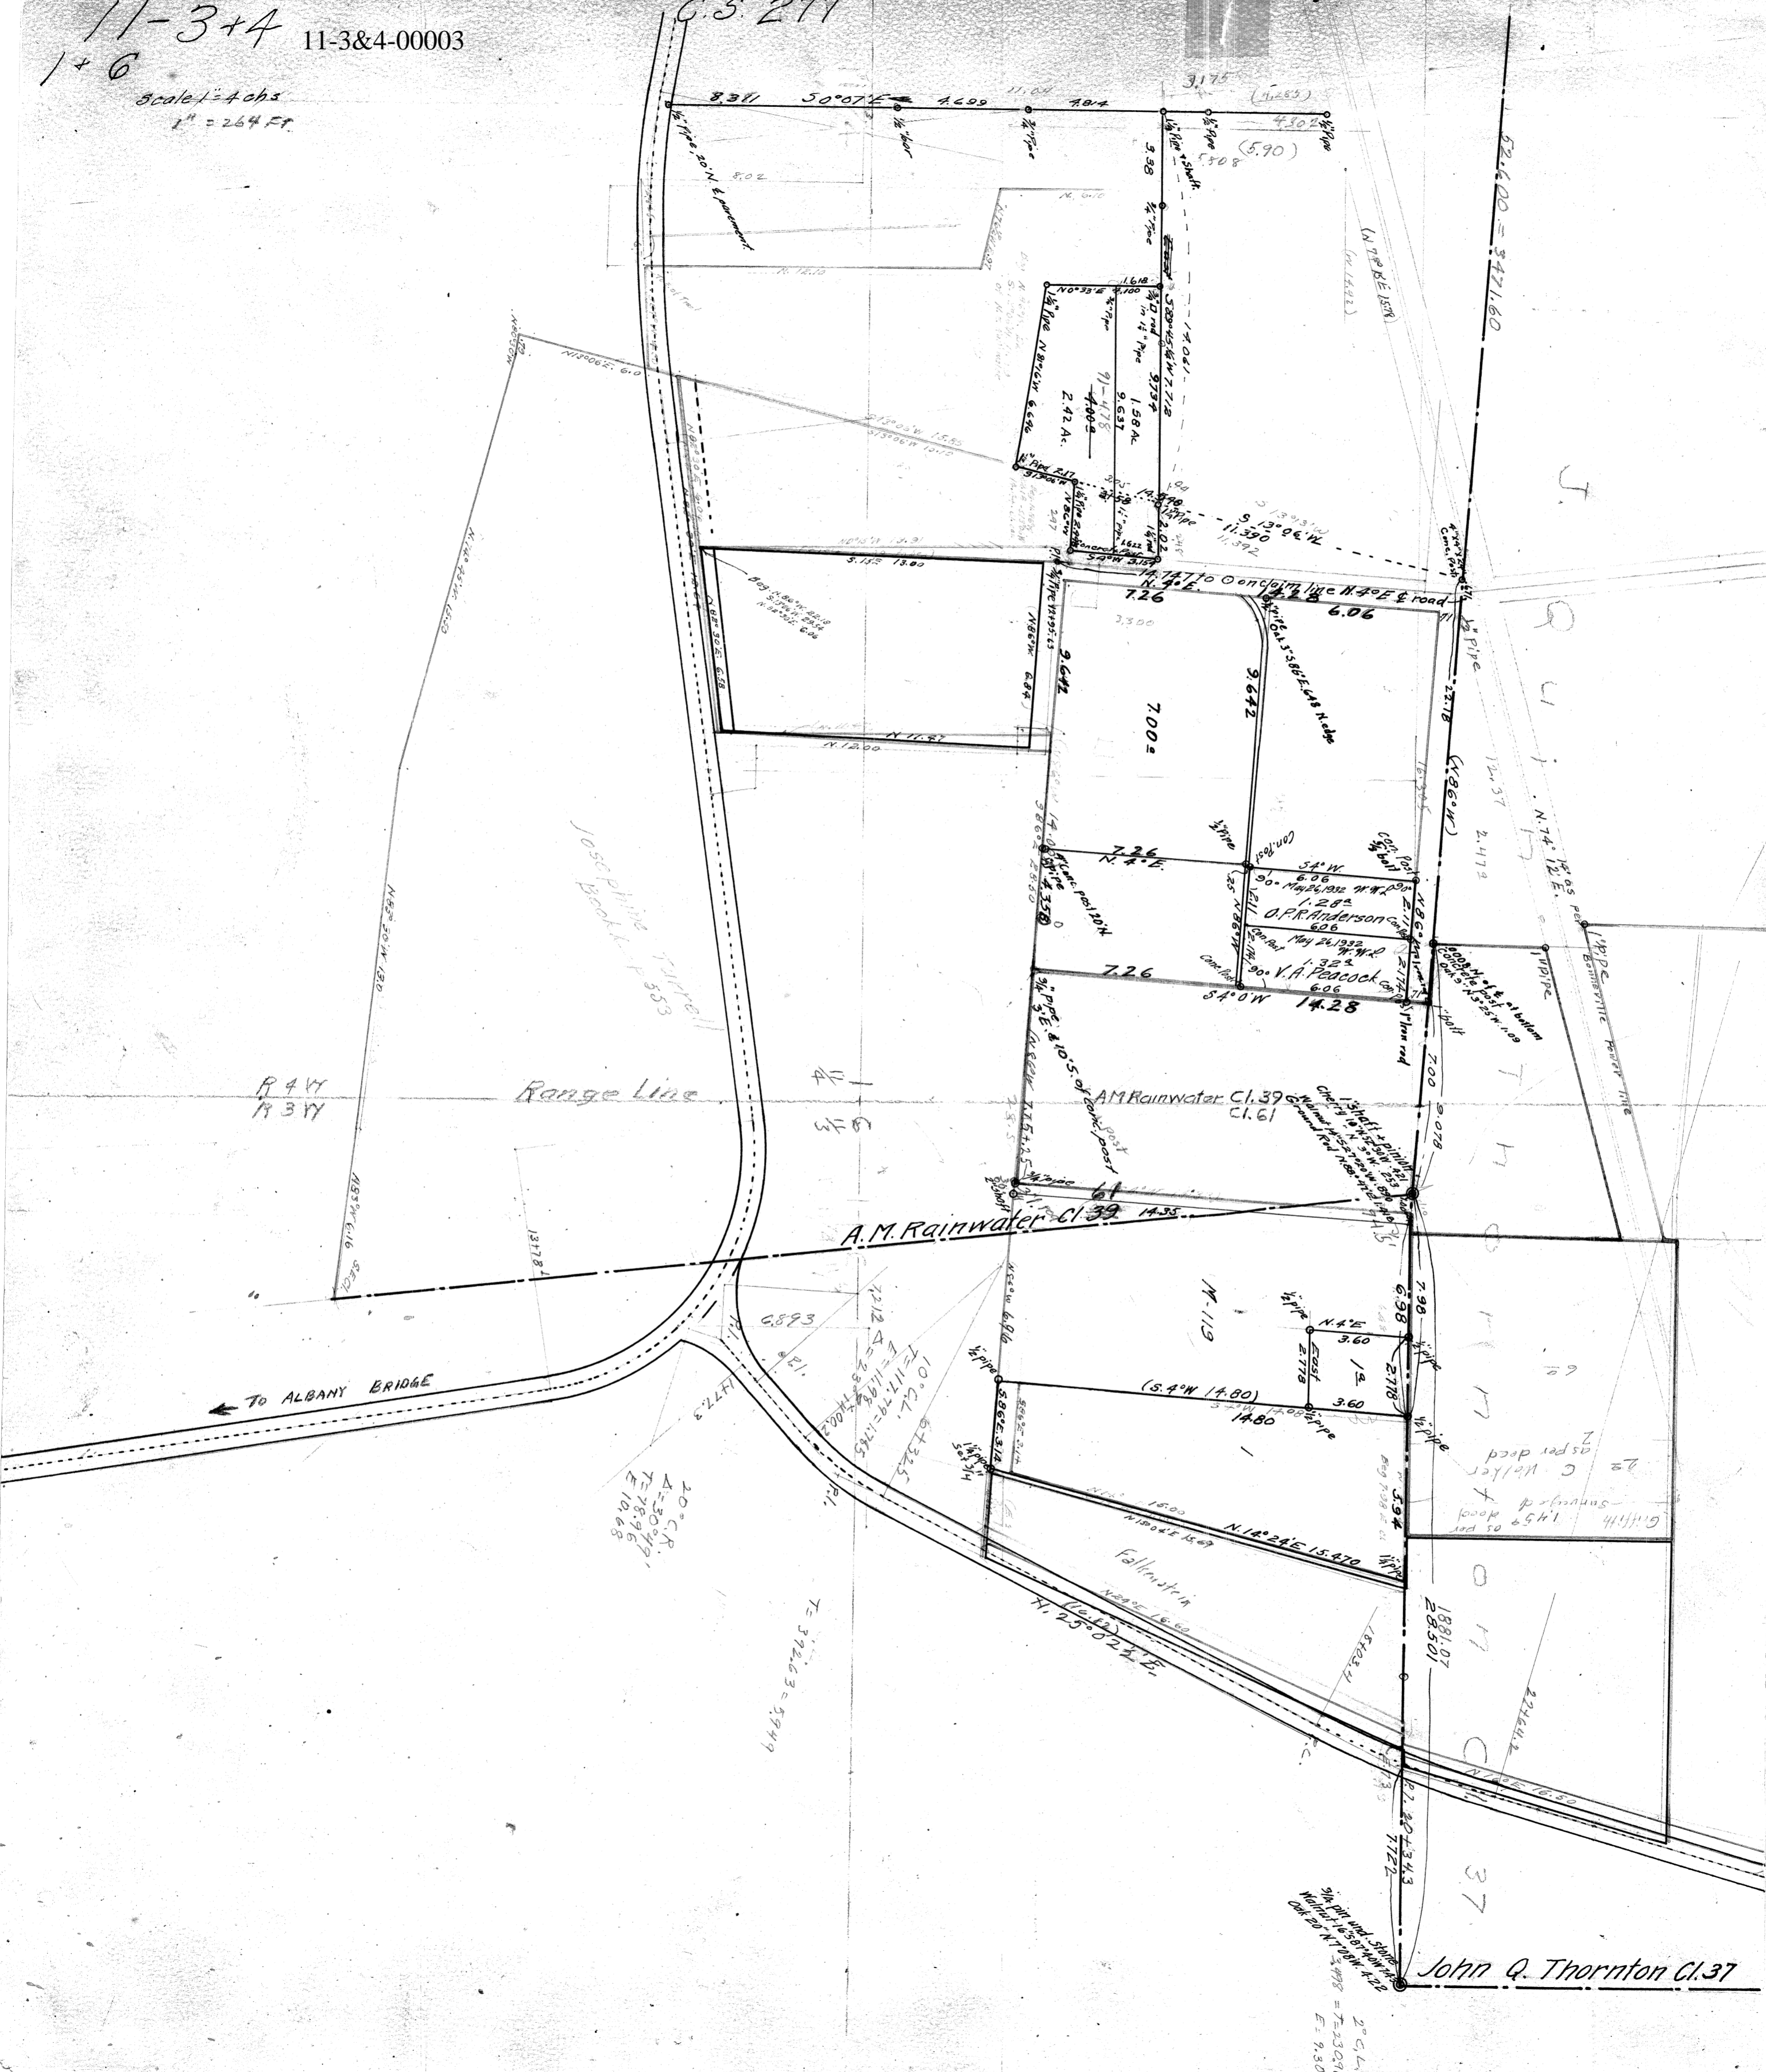

R 4 VY
R 3 VY

Range Line

TO ALBANY BRIDGE

20° C.R.
A=30° 47'
T=78.97
E=10.68

T=372.63 = 574.9

A.M. Rainwater Cl. 39

N-119

John Q. Thornton Cl. 37

2° C.L.
S 10° 07' E = 723.090
E = 9.301

37

1881.07
285.01

Griffith
1.459 as per
survey of deed
2 as per deed

0 17 C





