11-4
19,20

00015

C. S. 152
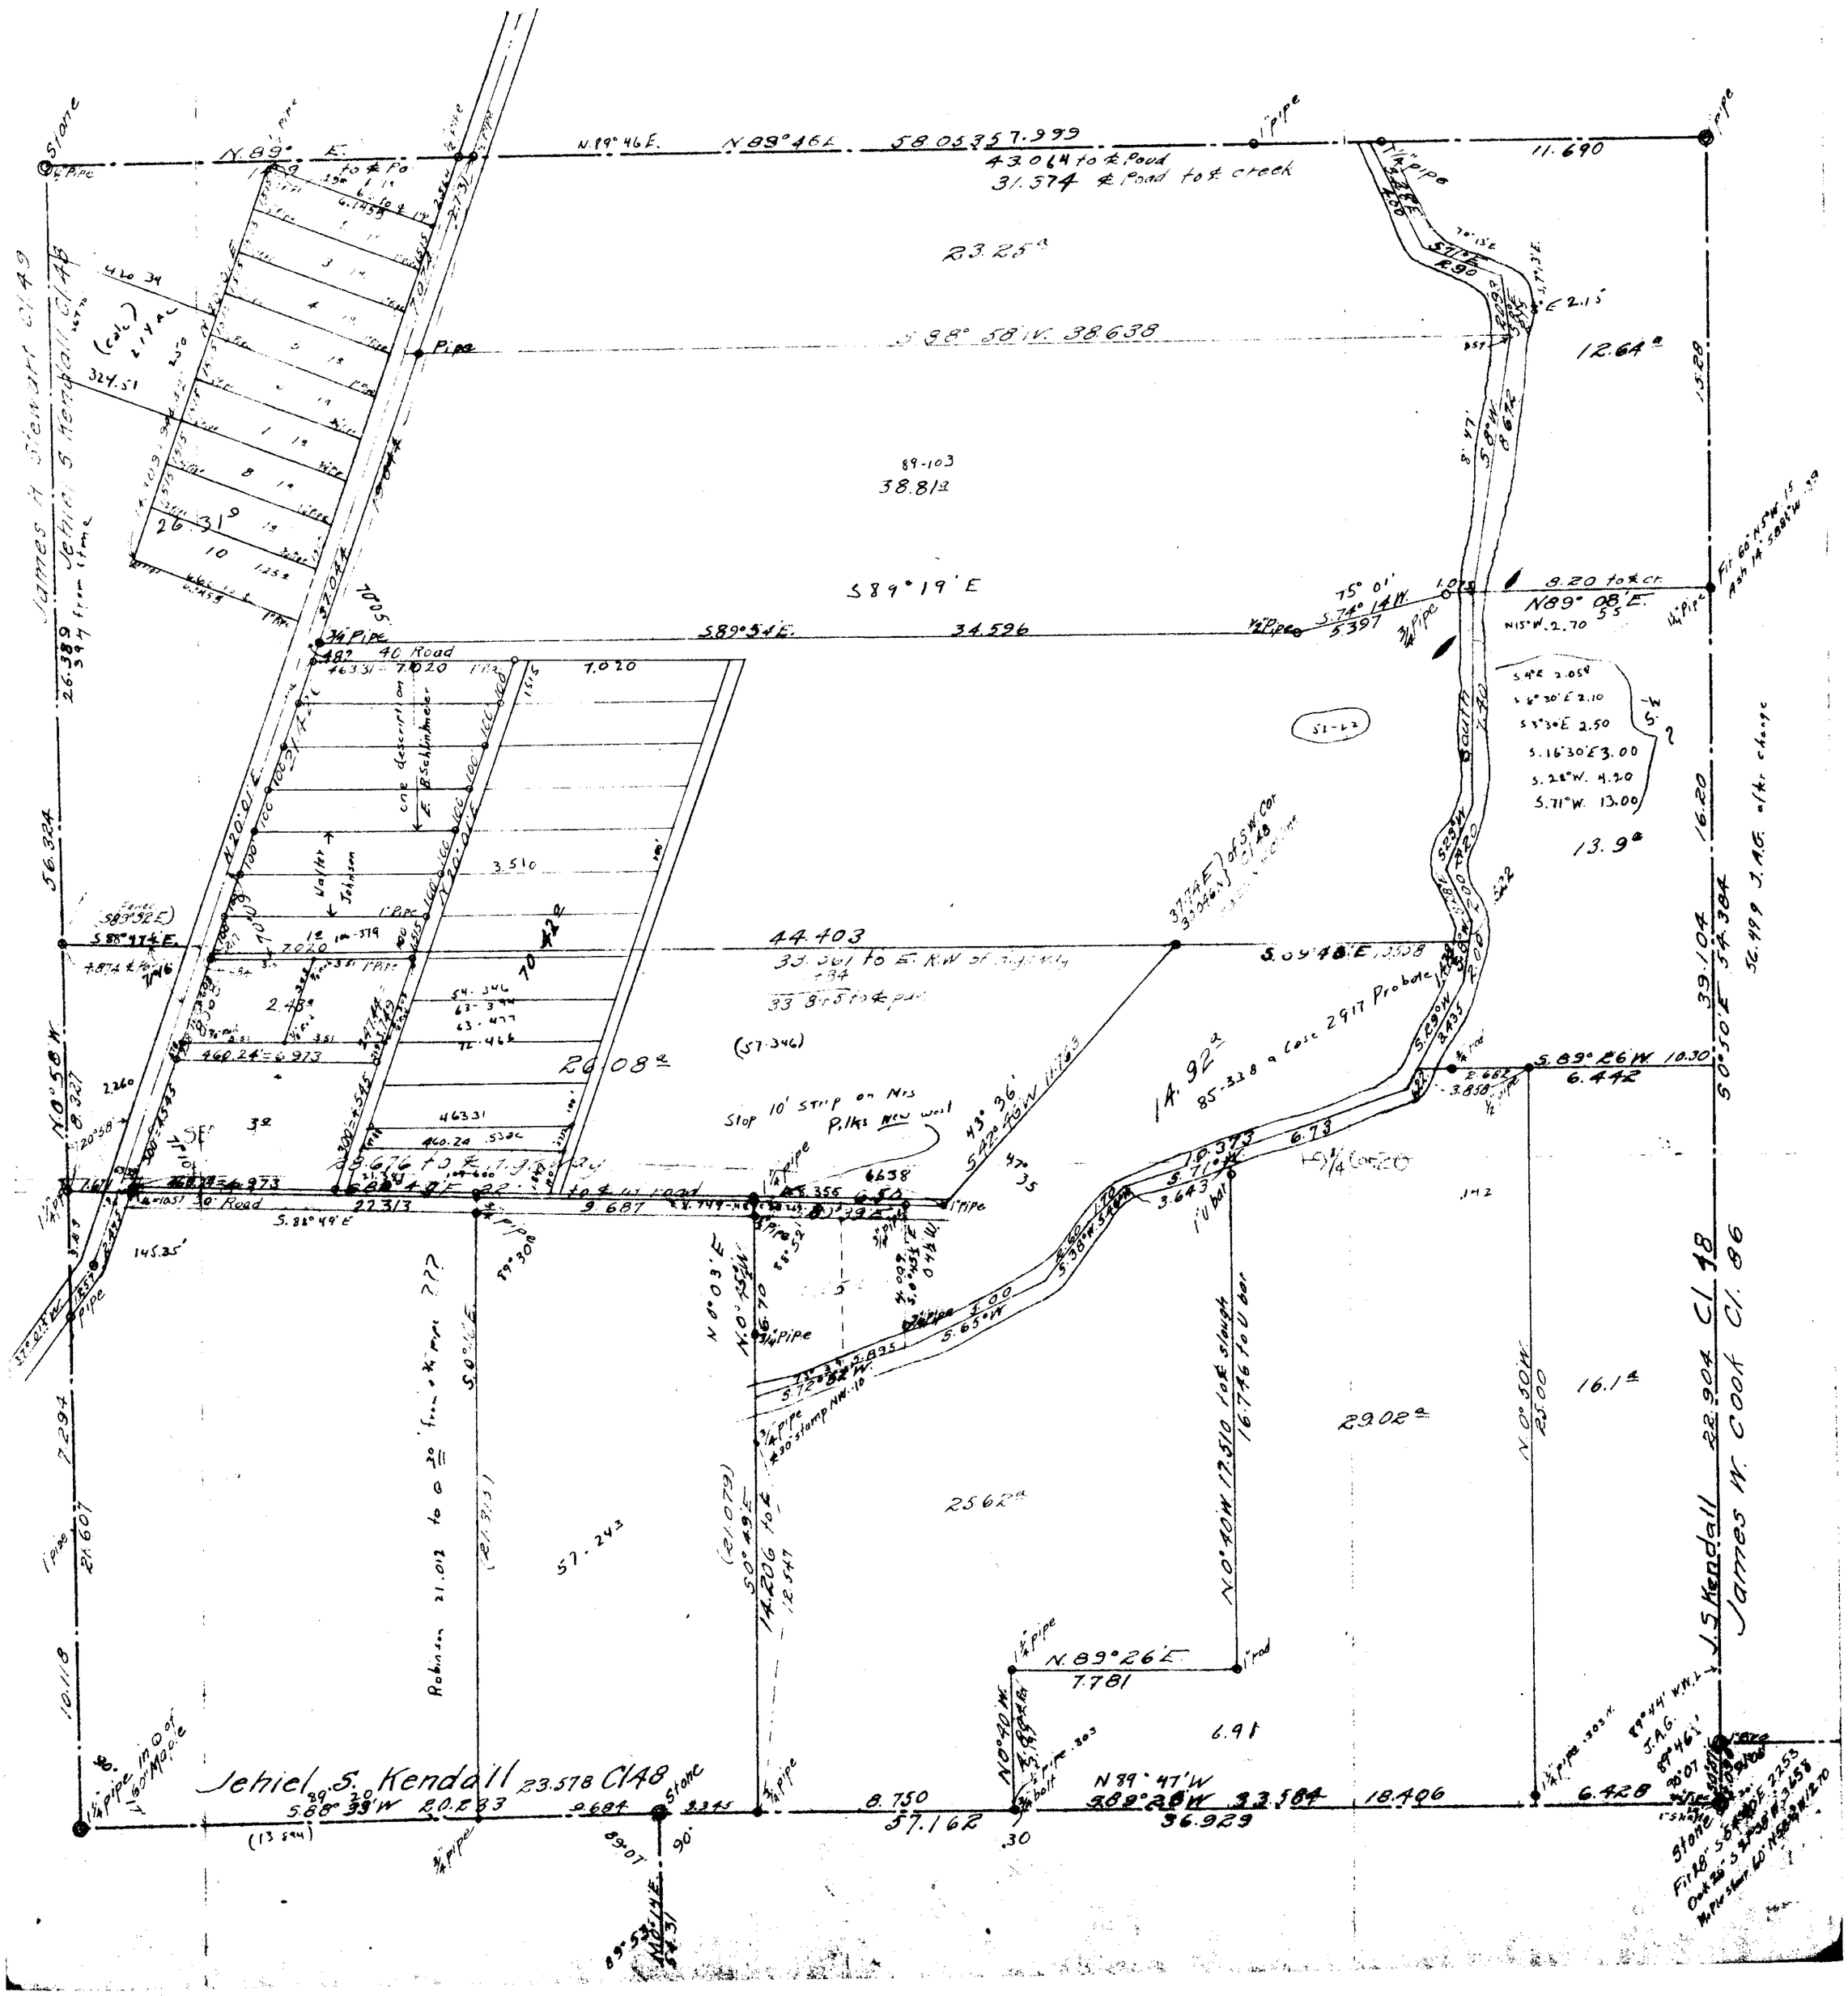
Scale 1" = 4 chs