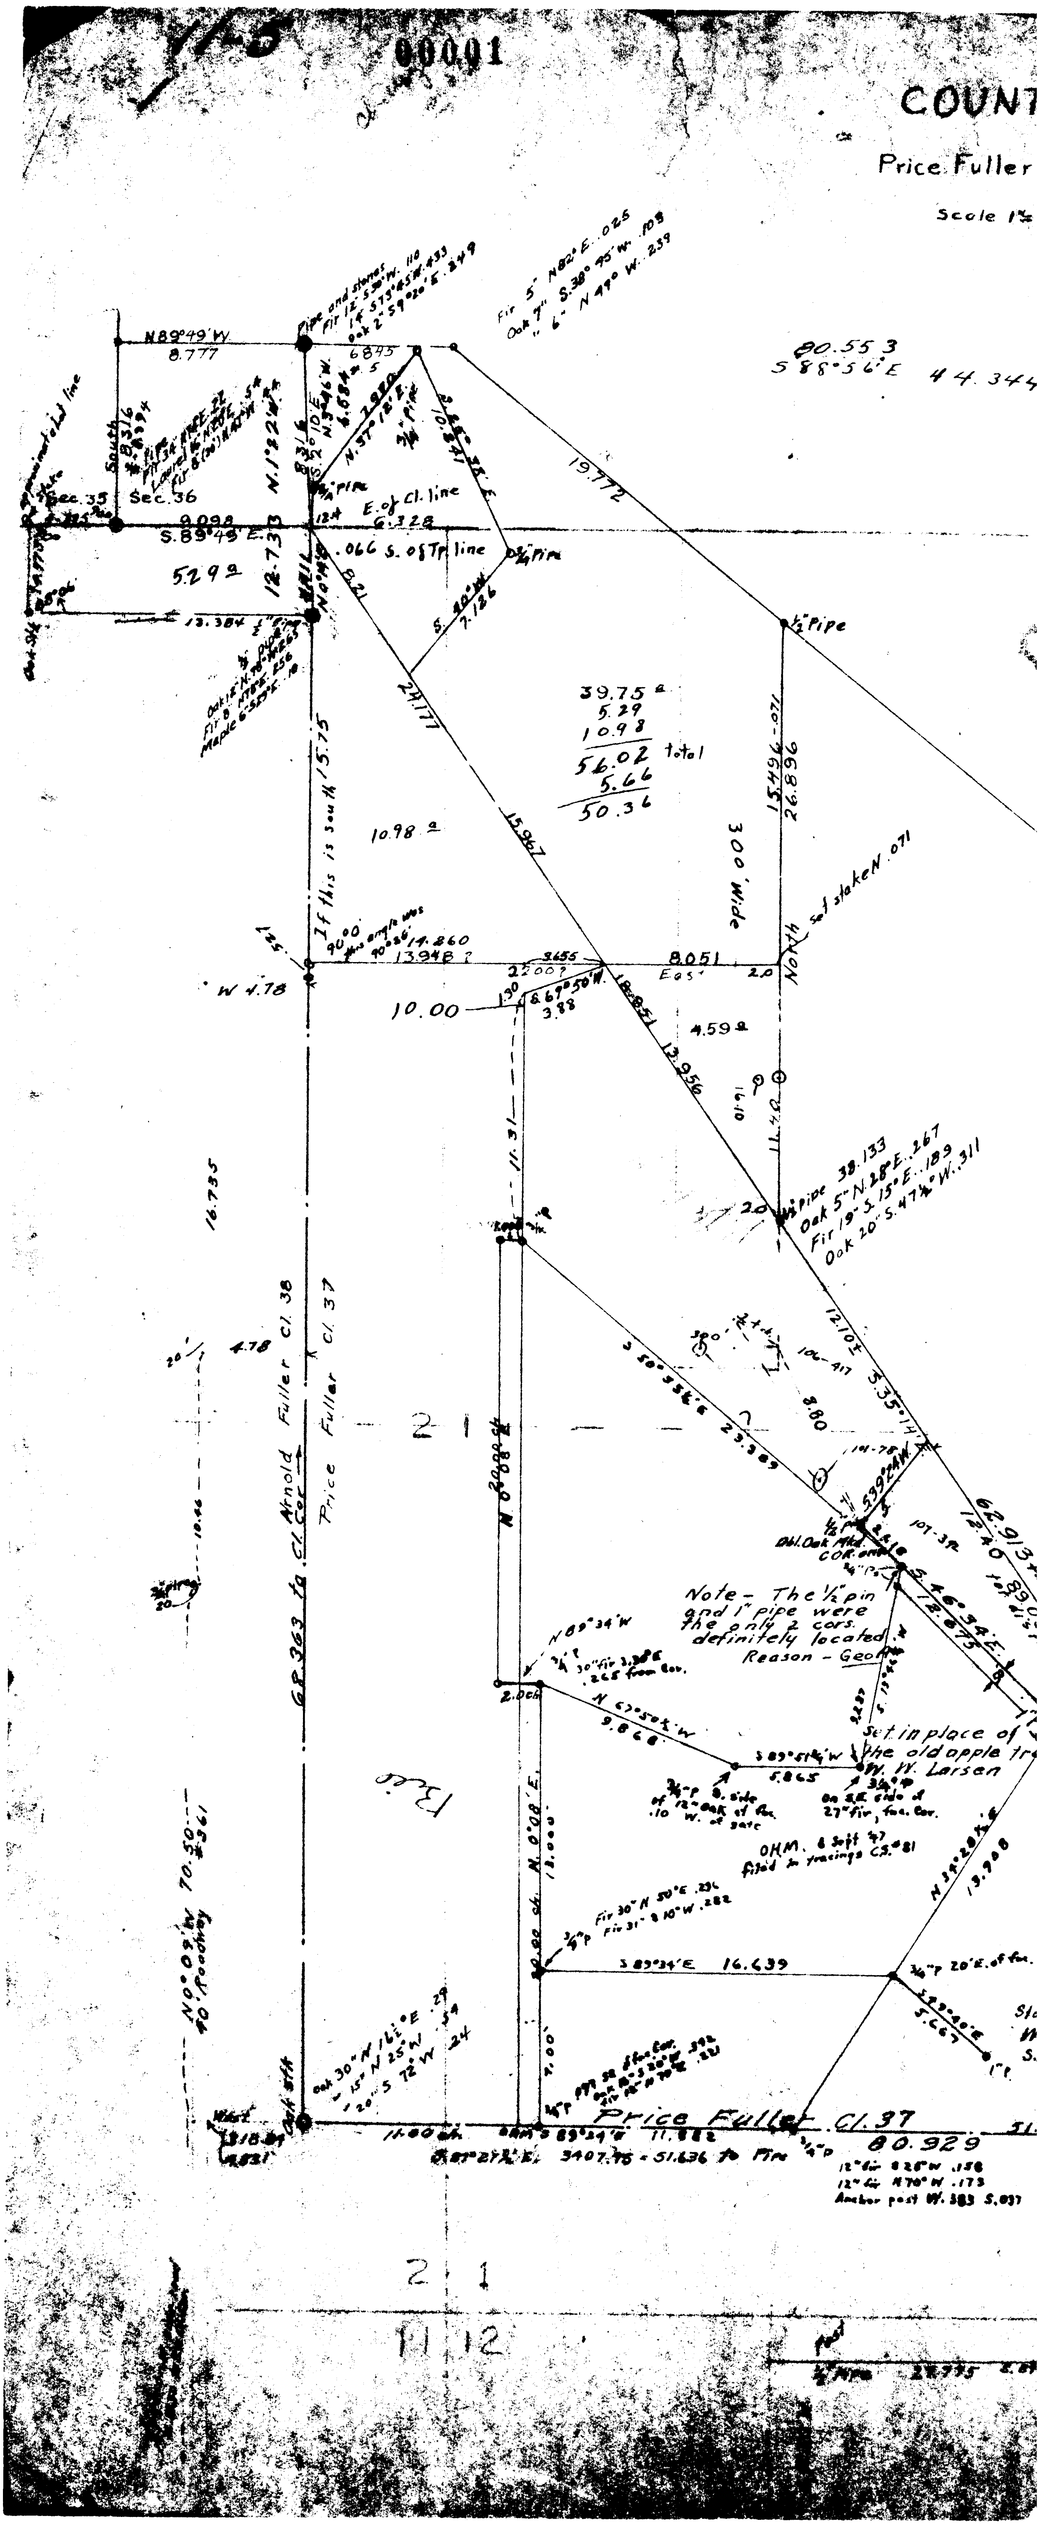
COUNT
Price Fuller
Scale 1"
Sec. 35
Sec. 36
N89°49'W
8.777
S.89°49'E.
5.292
12.733
N.1°32'W.
E. of Cl. line
6.328
.066 S. of Tp line
13.384
39.75 a
5.29
10.98
56.02 total
5.66
50.36
10.98 a
300' wide
½" Pipe
Oak 5" N.28°E. .267
Fir 19" S.15°E. .189
Oak 20" S.47½°W. .311
Price Fuller Cl. 37
Arnold Fuller Cl. 38
Cl. Cor.
Note - The ½" pin and 1" pipe were the only 2 cors. definitely located. Reason - Geol
Set in place of the old apple tr W. W. Larsen
OHM. & Sift '47 filed in recording Co. '81
Fir 30" N 50°E .25'
Fir 31" S 10°W .282
Oak 30" N 16½°E .29
Oak 15" N 25°W .34
Oak 20" S 72°W .24
40' Roadway
Oak stk
80.929
80.553
S 88°56'E 44.344
Fir 5" N 82°E .025
Oak 7" S 38°45'W .108
" 6" N 49°W .259
Pipe and stones
Fir 12" S 39°45'W .110
Oak 2" S 59°20'E .249
Fir 12" S 53°45'W .433
