11-5
2, 3, 10, 11
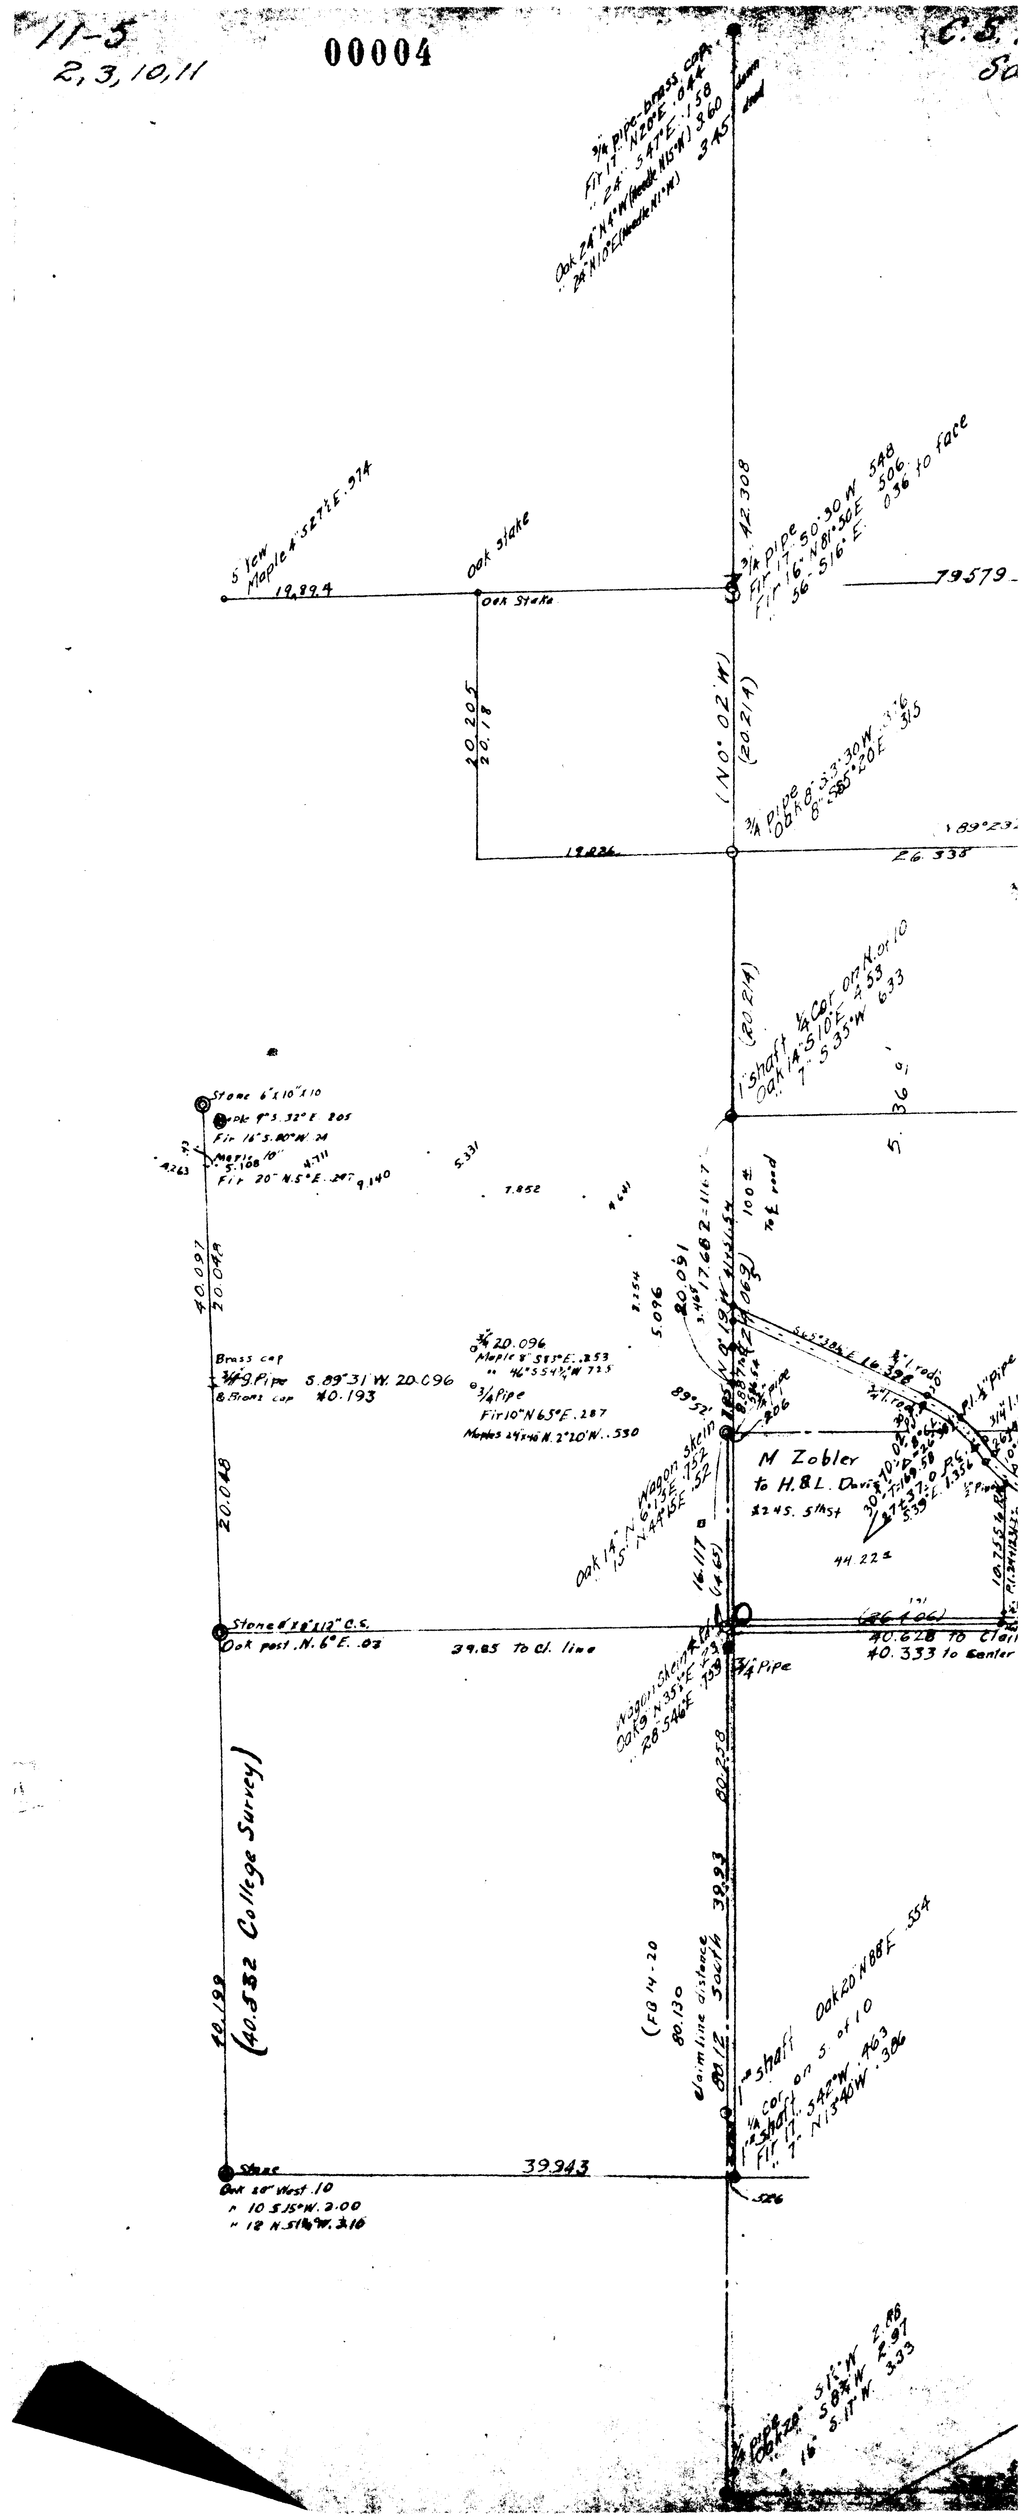
00004