11-5

4,5,8,9
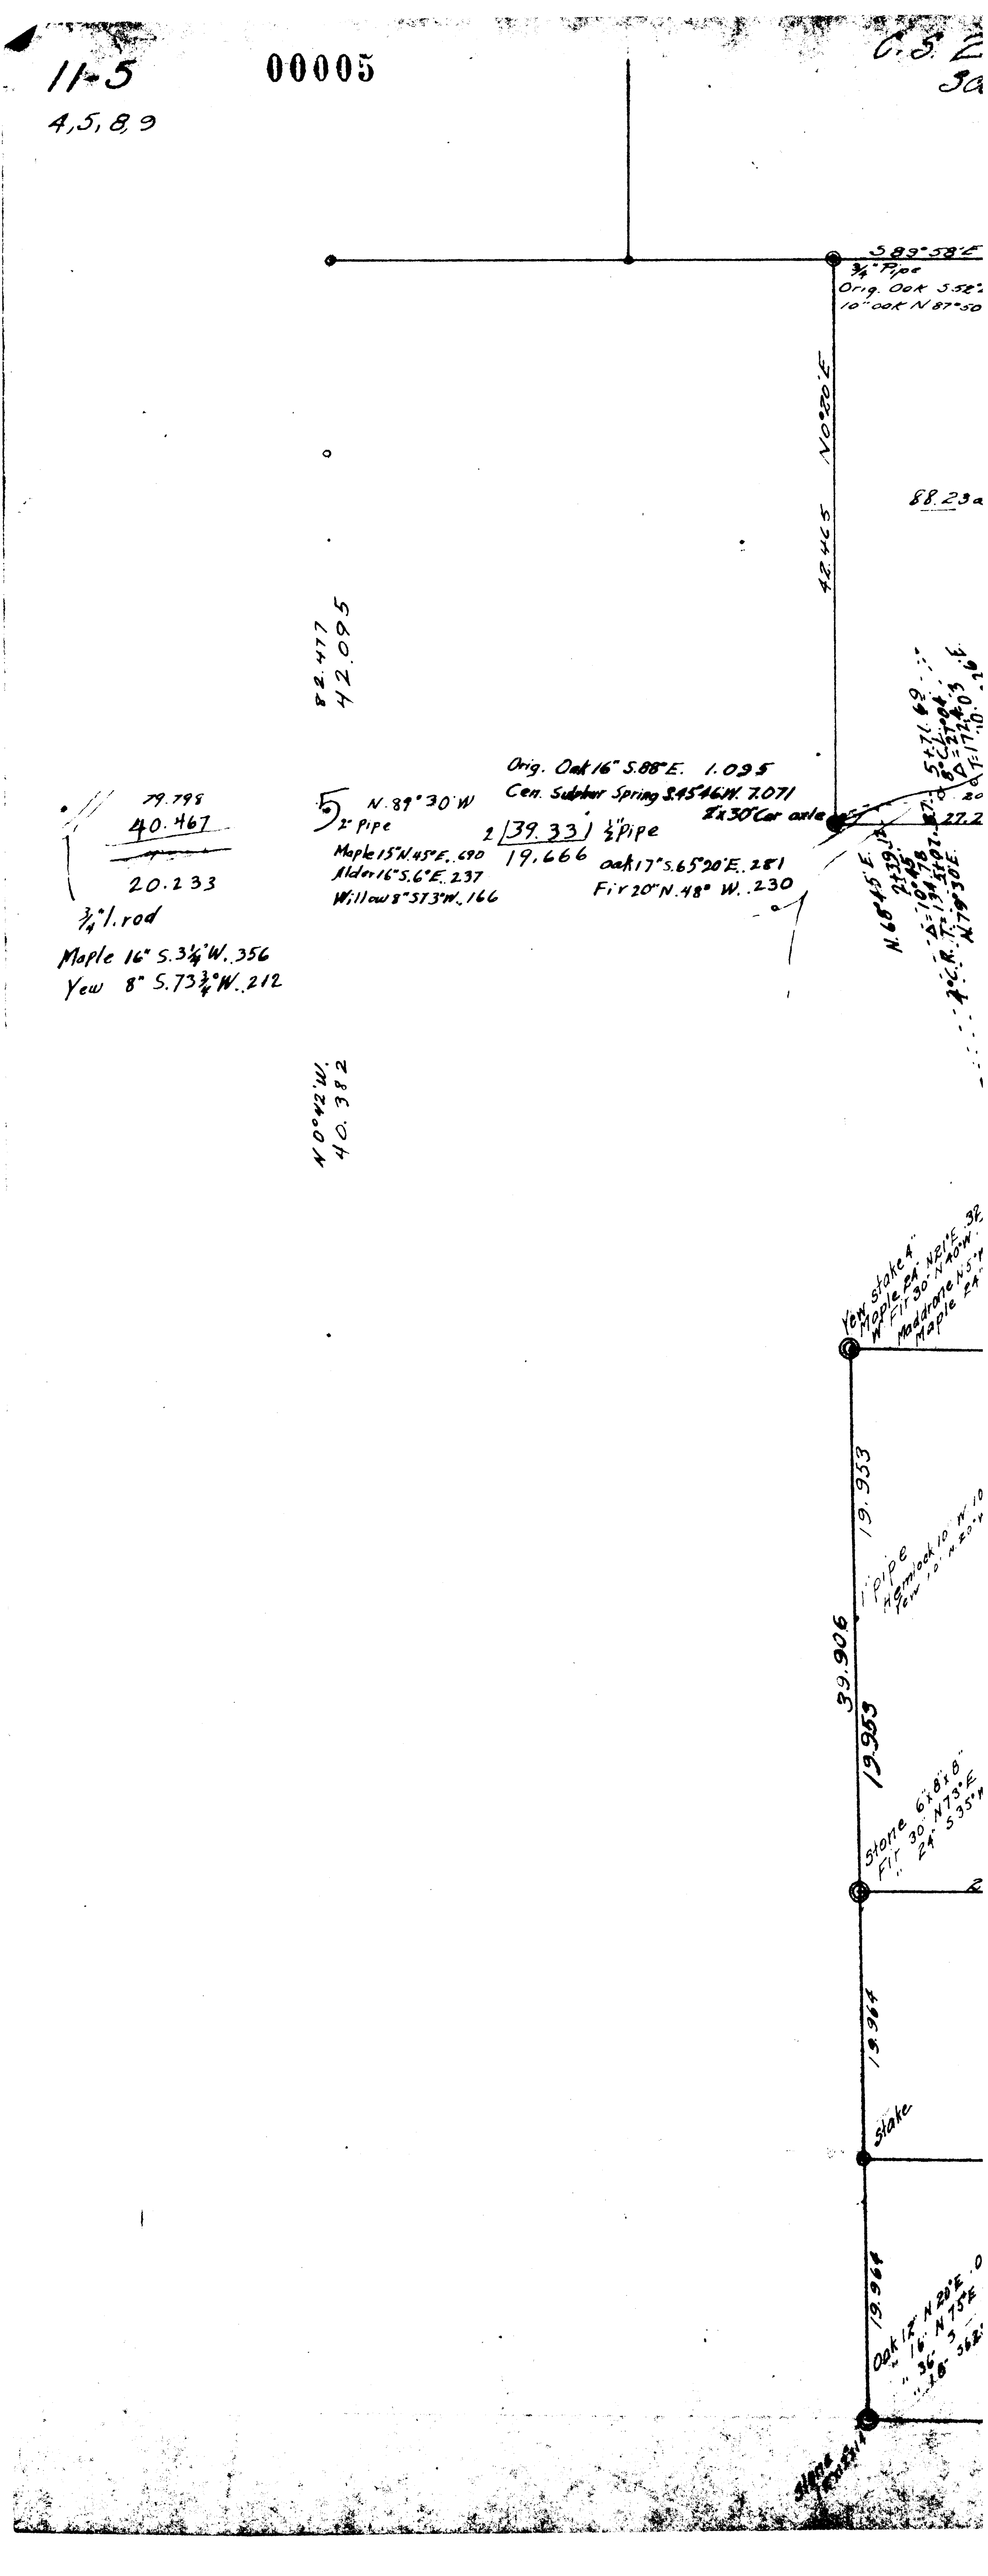
00005