11-5
20,21,28,29

00009

COUNTY SURVEY

T. 11 S. R
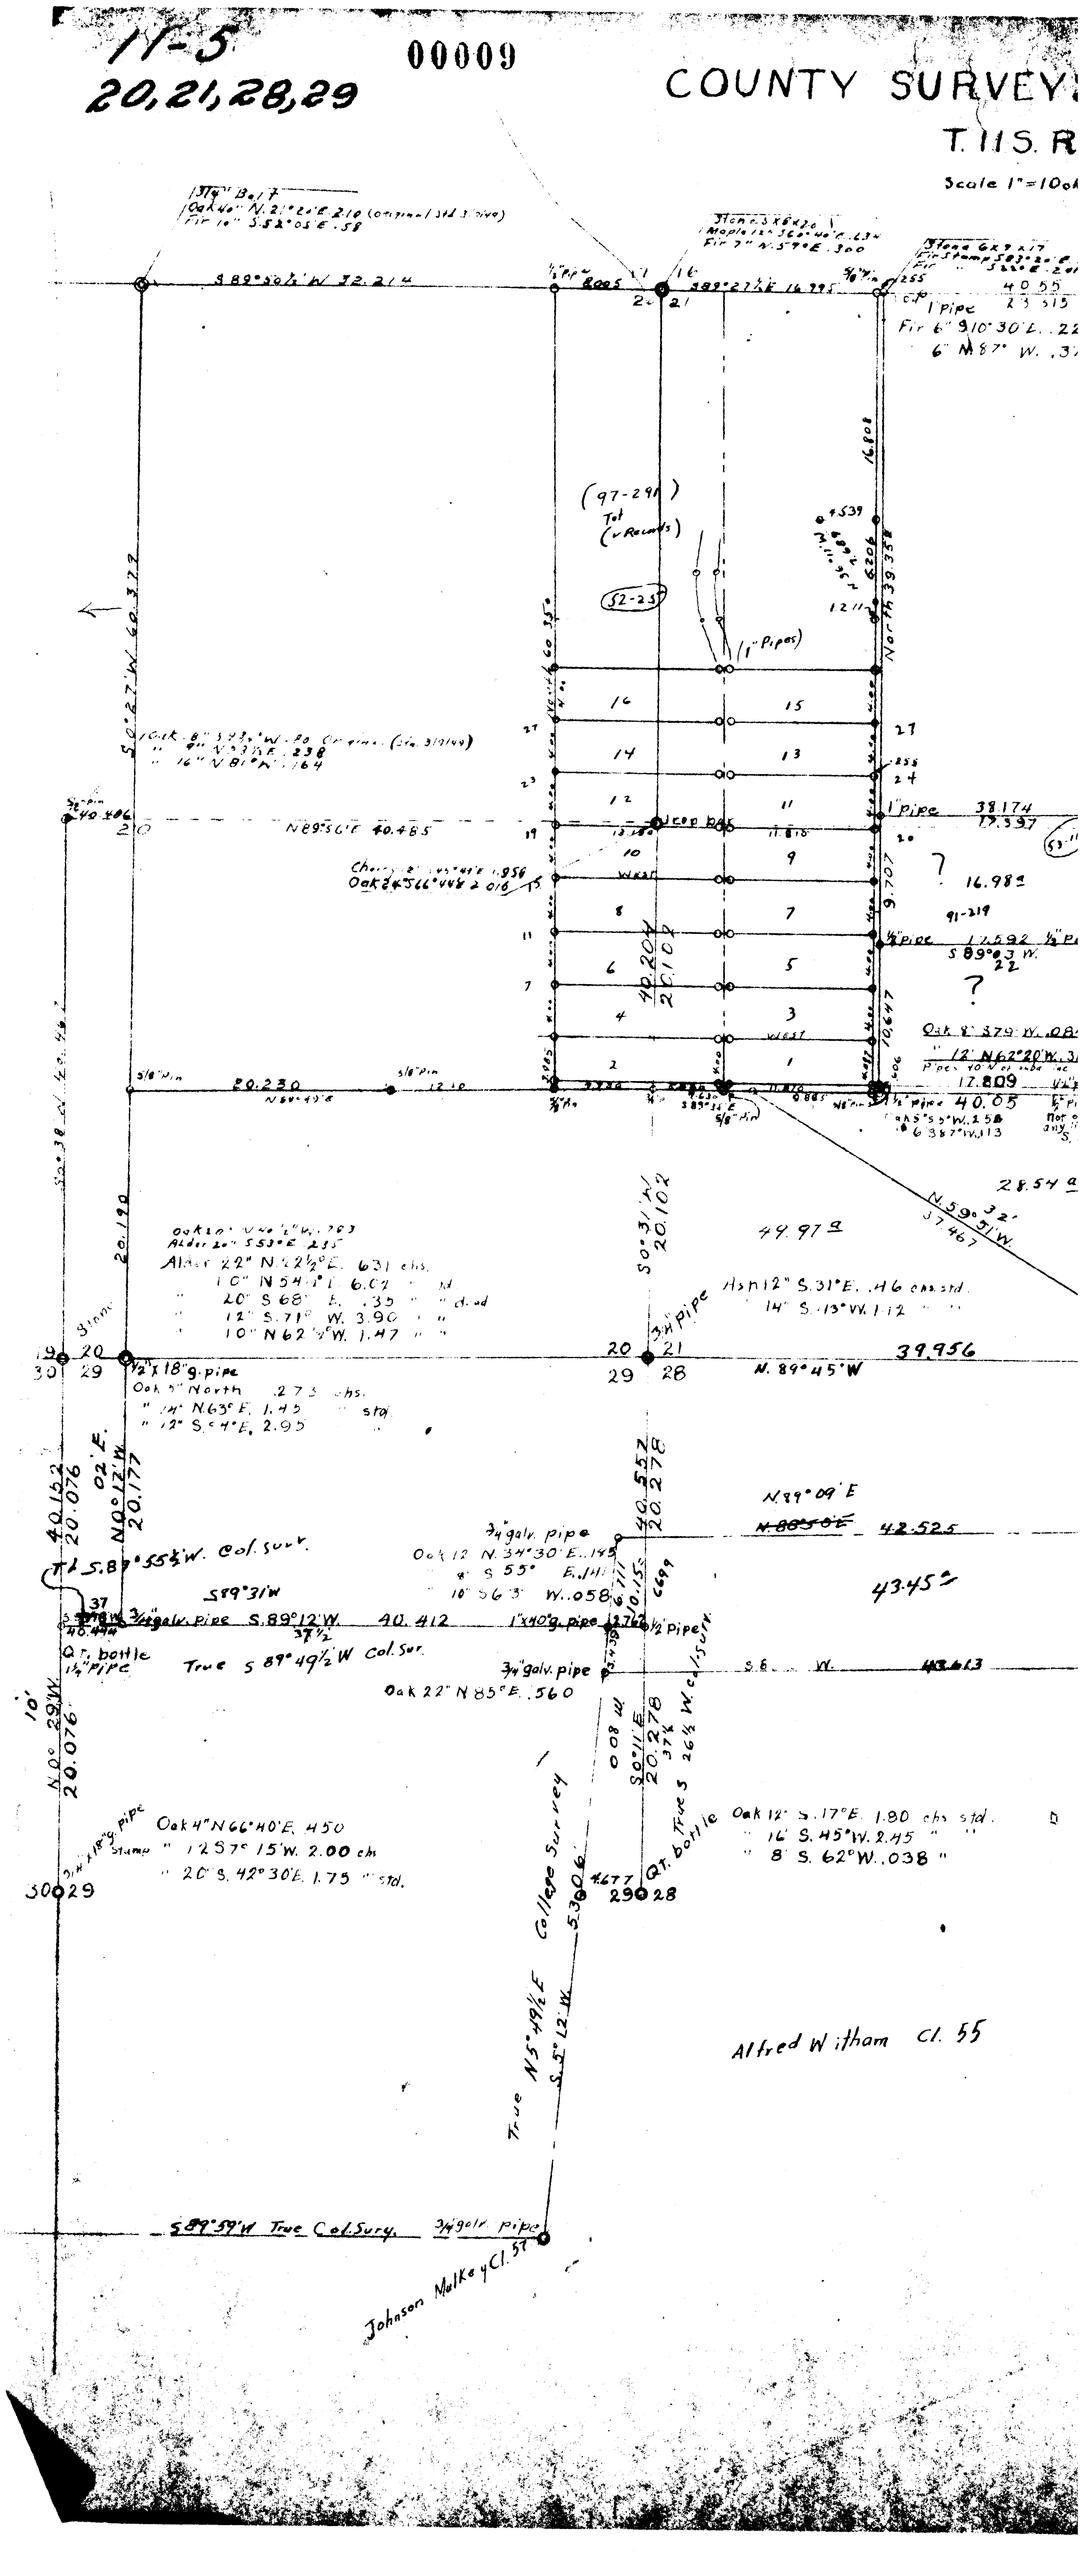
Scale 1"=10o