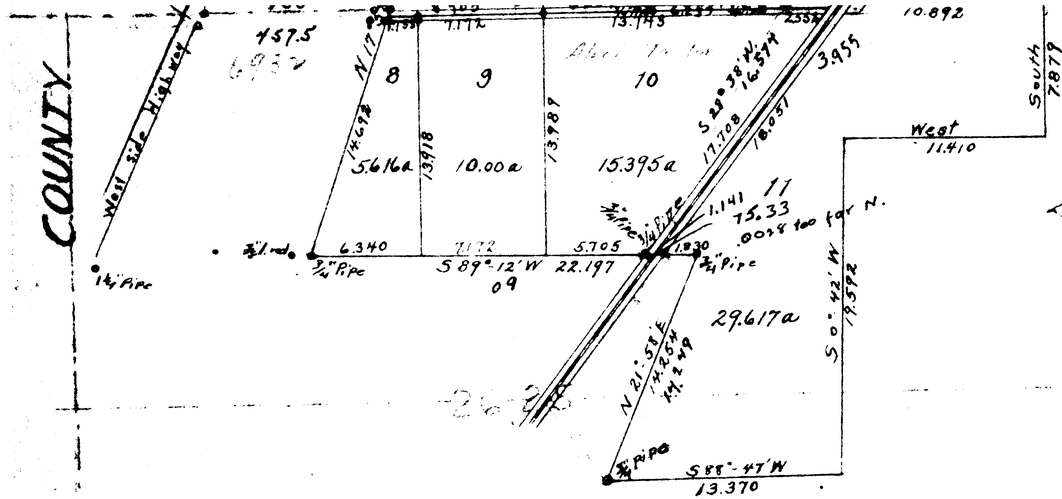

WILLAMETTE DALE FARM.

FRUIT, VEGETABLE AND DAIRY FARMS.

10 to 75 Acre Tracts.

BENTON COUNTY, OREGON.

1" = 500'

25 30

00016

11-5
B5,26