11-5
26

00017

COUNTY

JOHN S
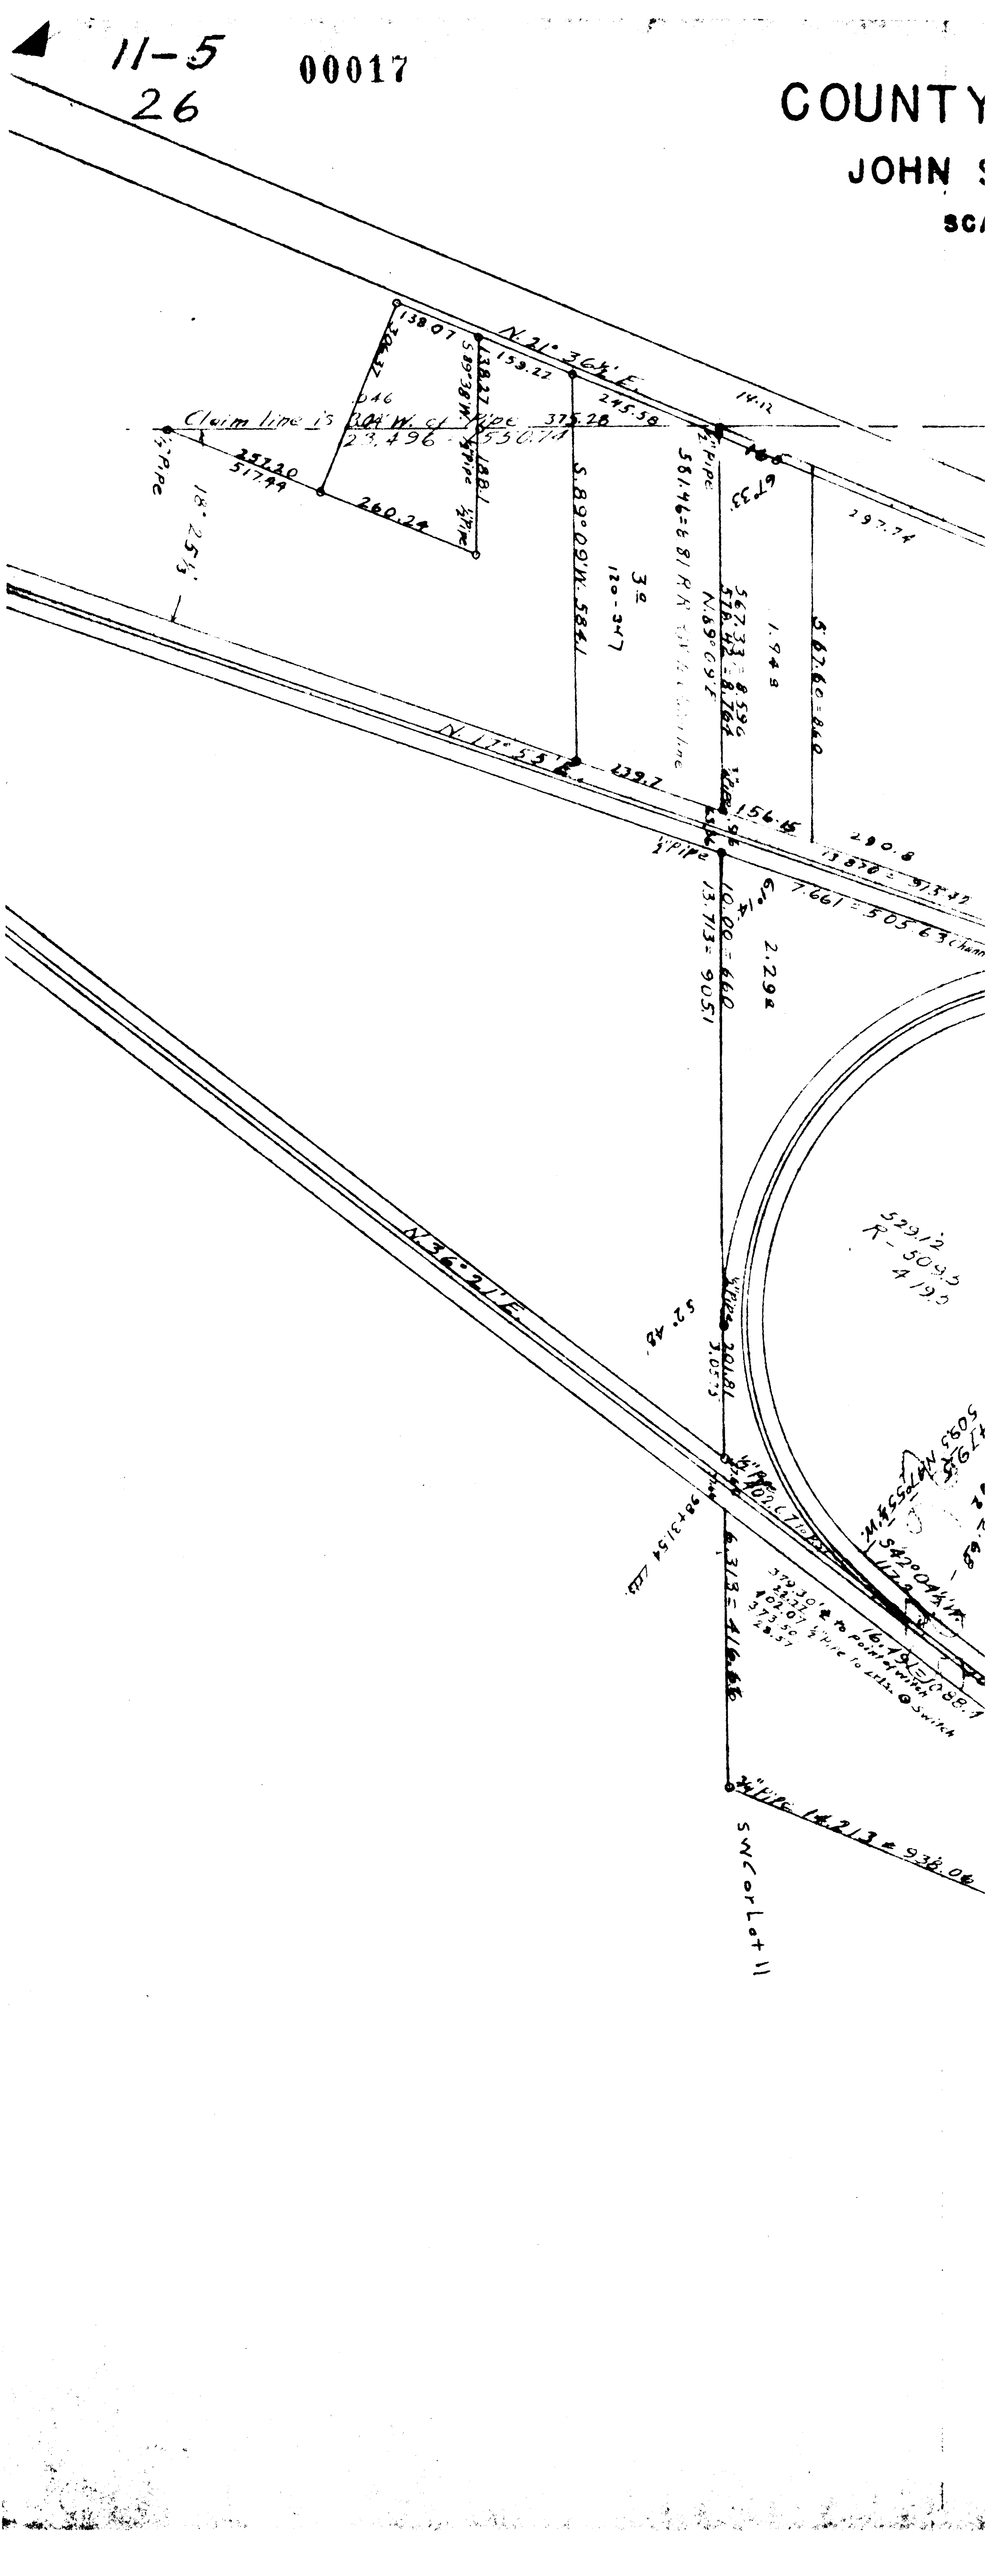
SCA