


H-5 00020
26 & 35

26
35

C.S. 129
T.11S.R5W
SCALE 1" = 100'

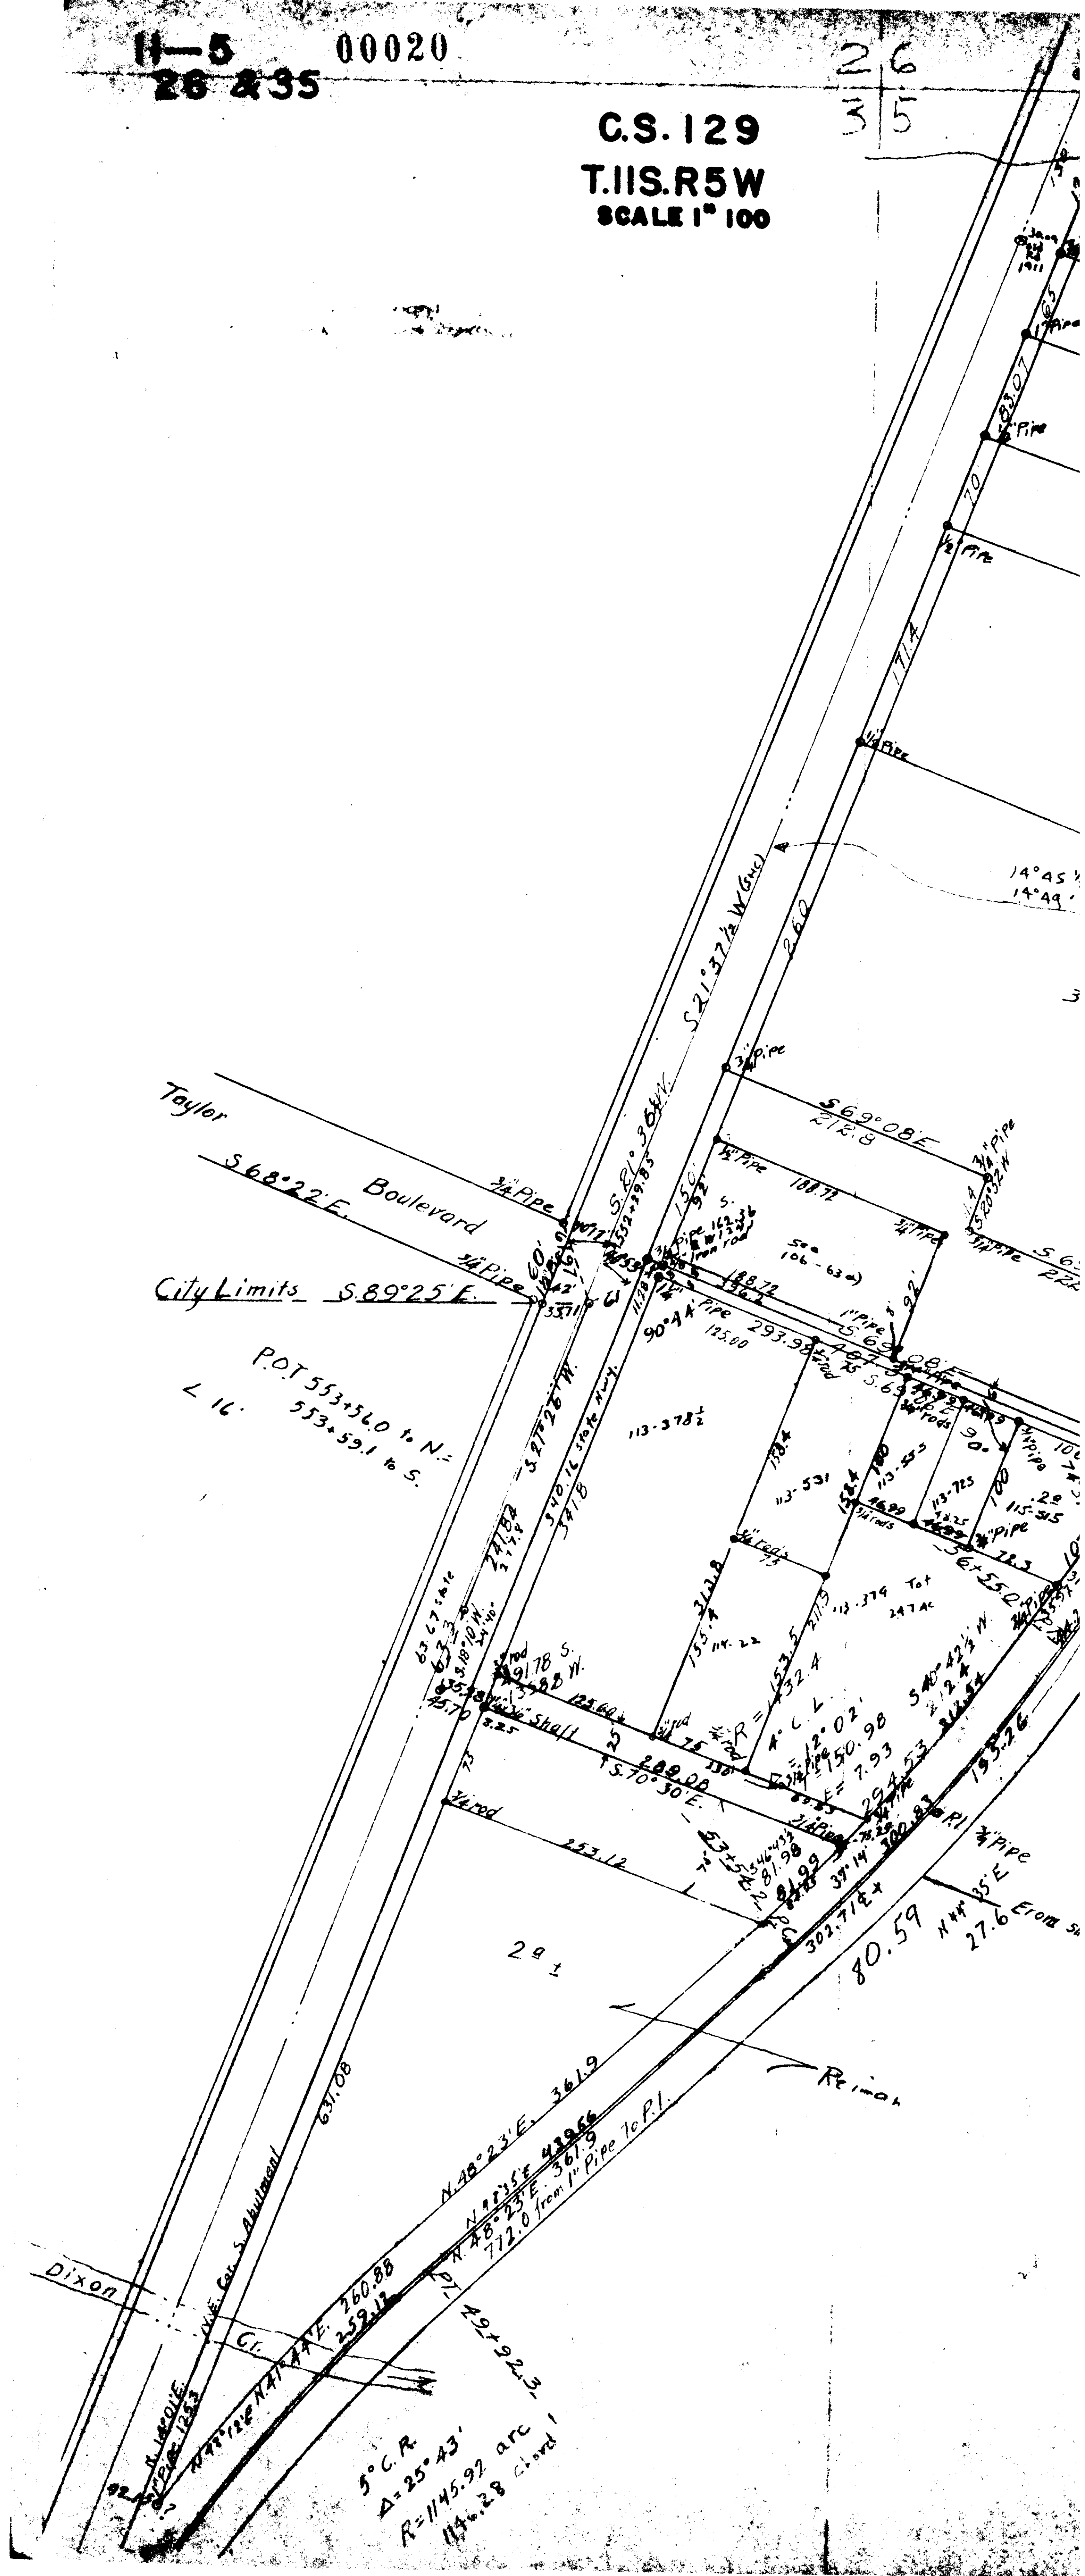

Taylor Boulevard
S 68° 22' E
City Limits S 89° 25' E

P.O.T. 553+56.0 to N =
L 16. 553+59.1 to S.

Dixon

5° C.R.
A = 25° 43'
R = 1145.92 arc
114.28 chord

N 48° 23' E. 361.9
N 48° 23' E. 439.6
N 48° 23' E. 361.9
712.0 from 1" Pipe to P.I.

Remain

80.59
27.6
From S