11-5
-29

00027

COUNTY SURVEY No. 270 CONTINUED

SECTION 29 T. 11 S., R. 5 W.

Scale 1" = 10 chs.
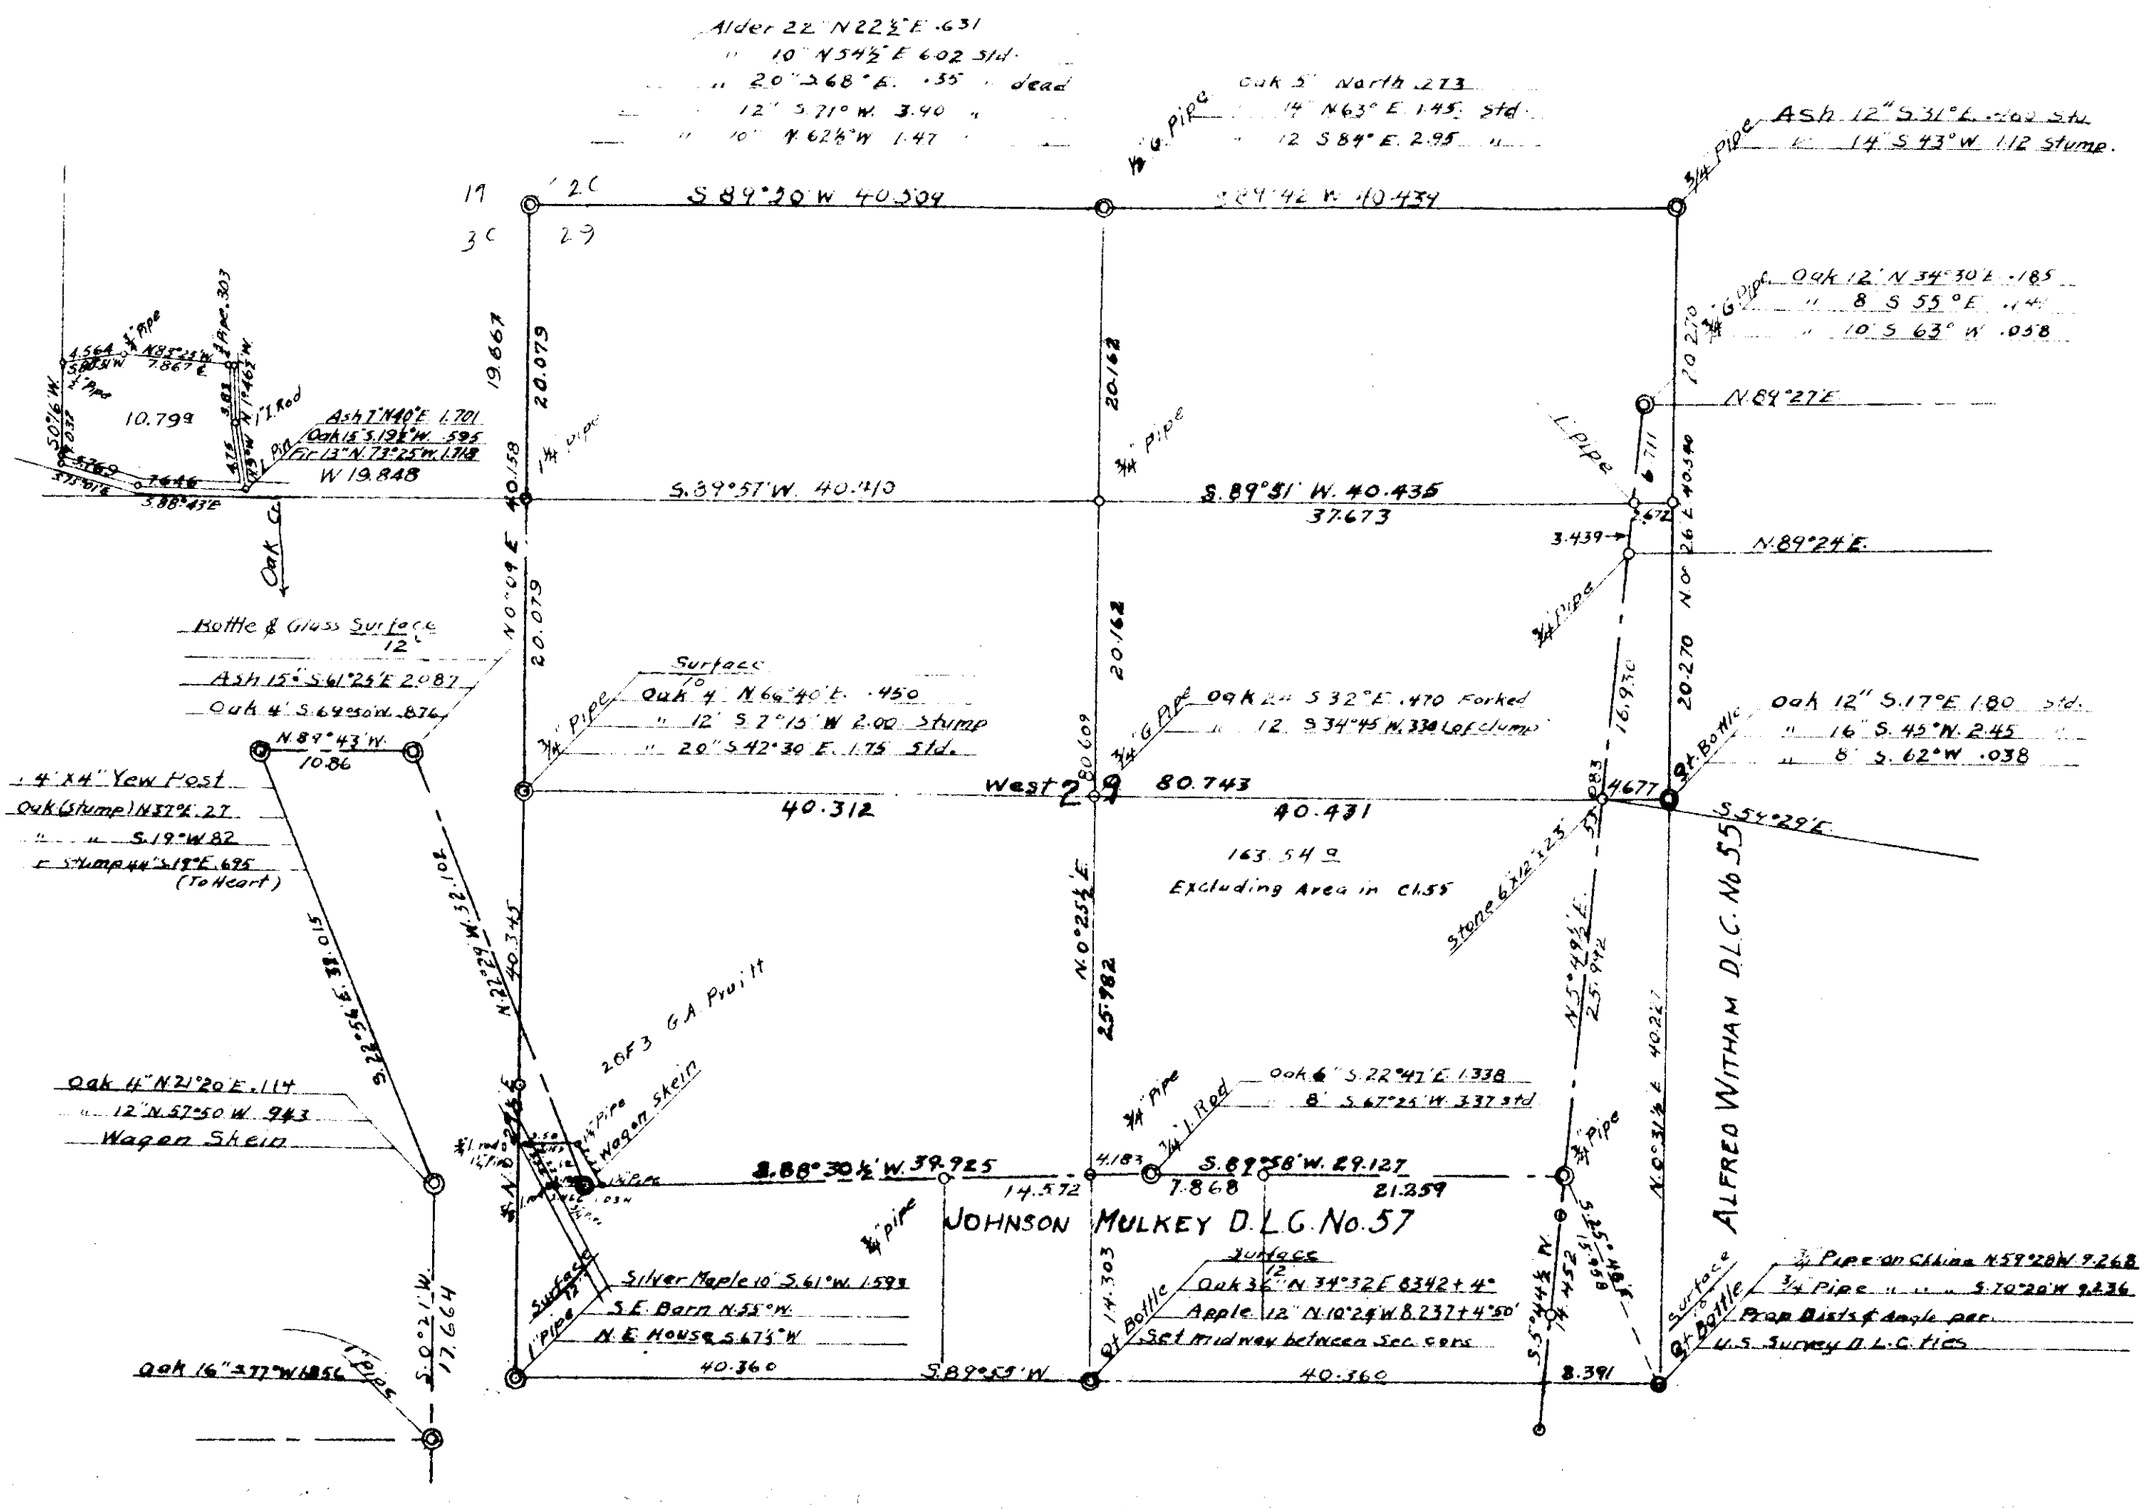
Combining Parts of Surveys Nos. 260, 270 & 292