11-5-#00033

35-36

Taylor Tracts
Scale:-1"=50ft.
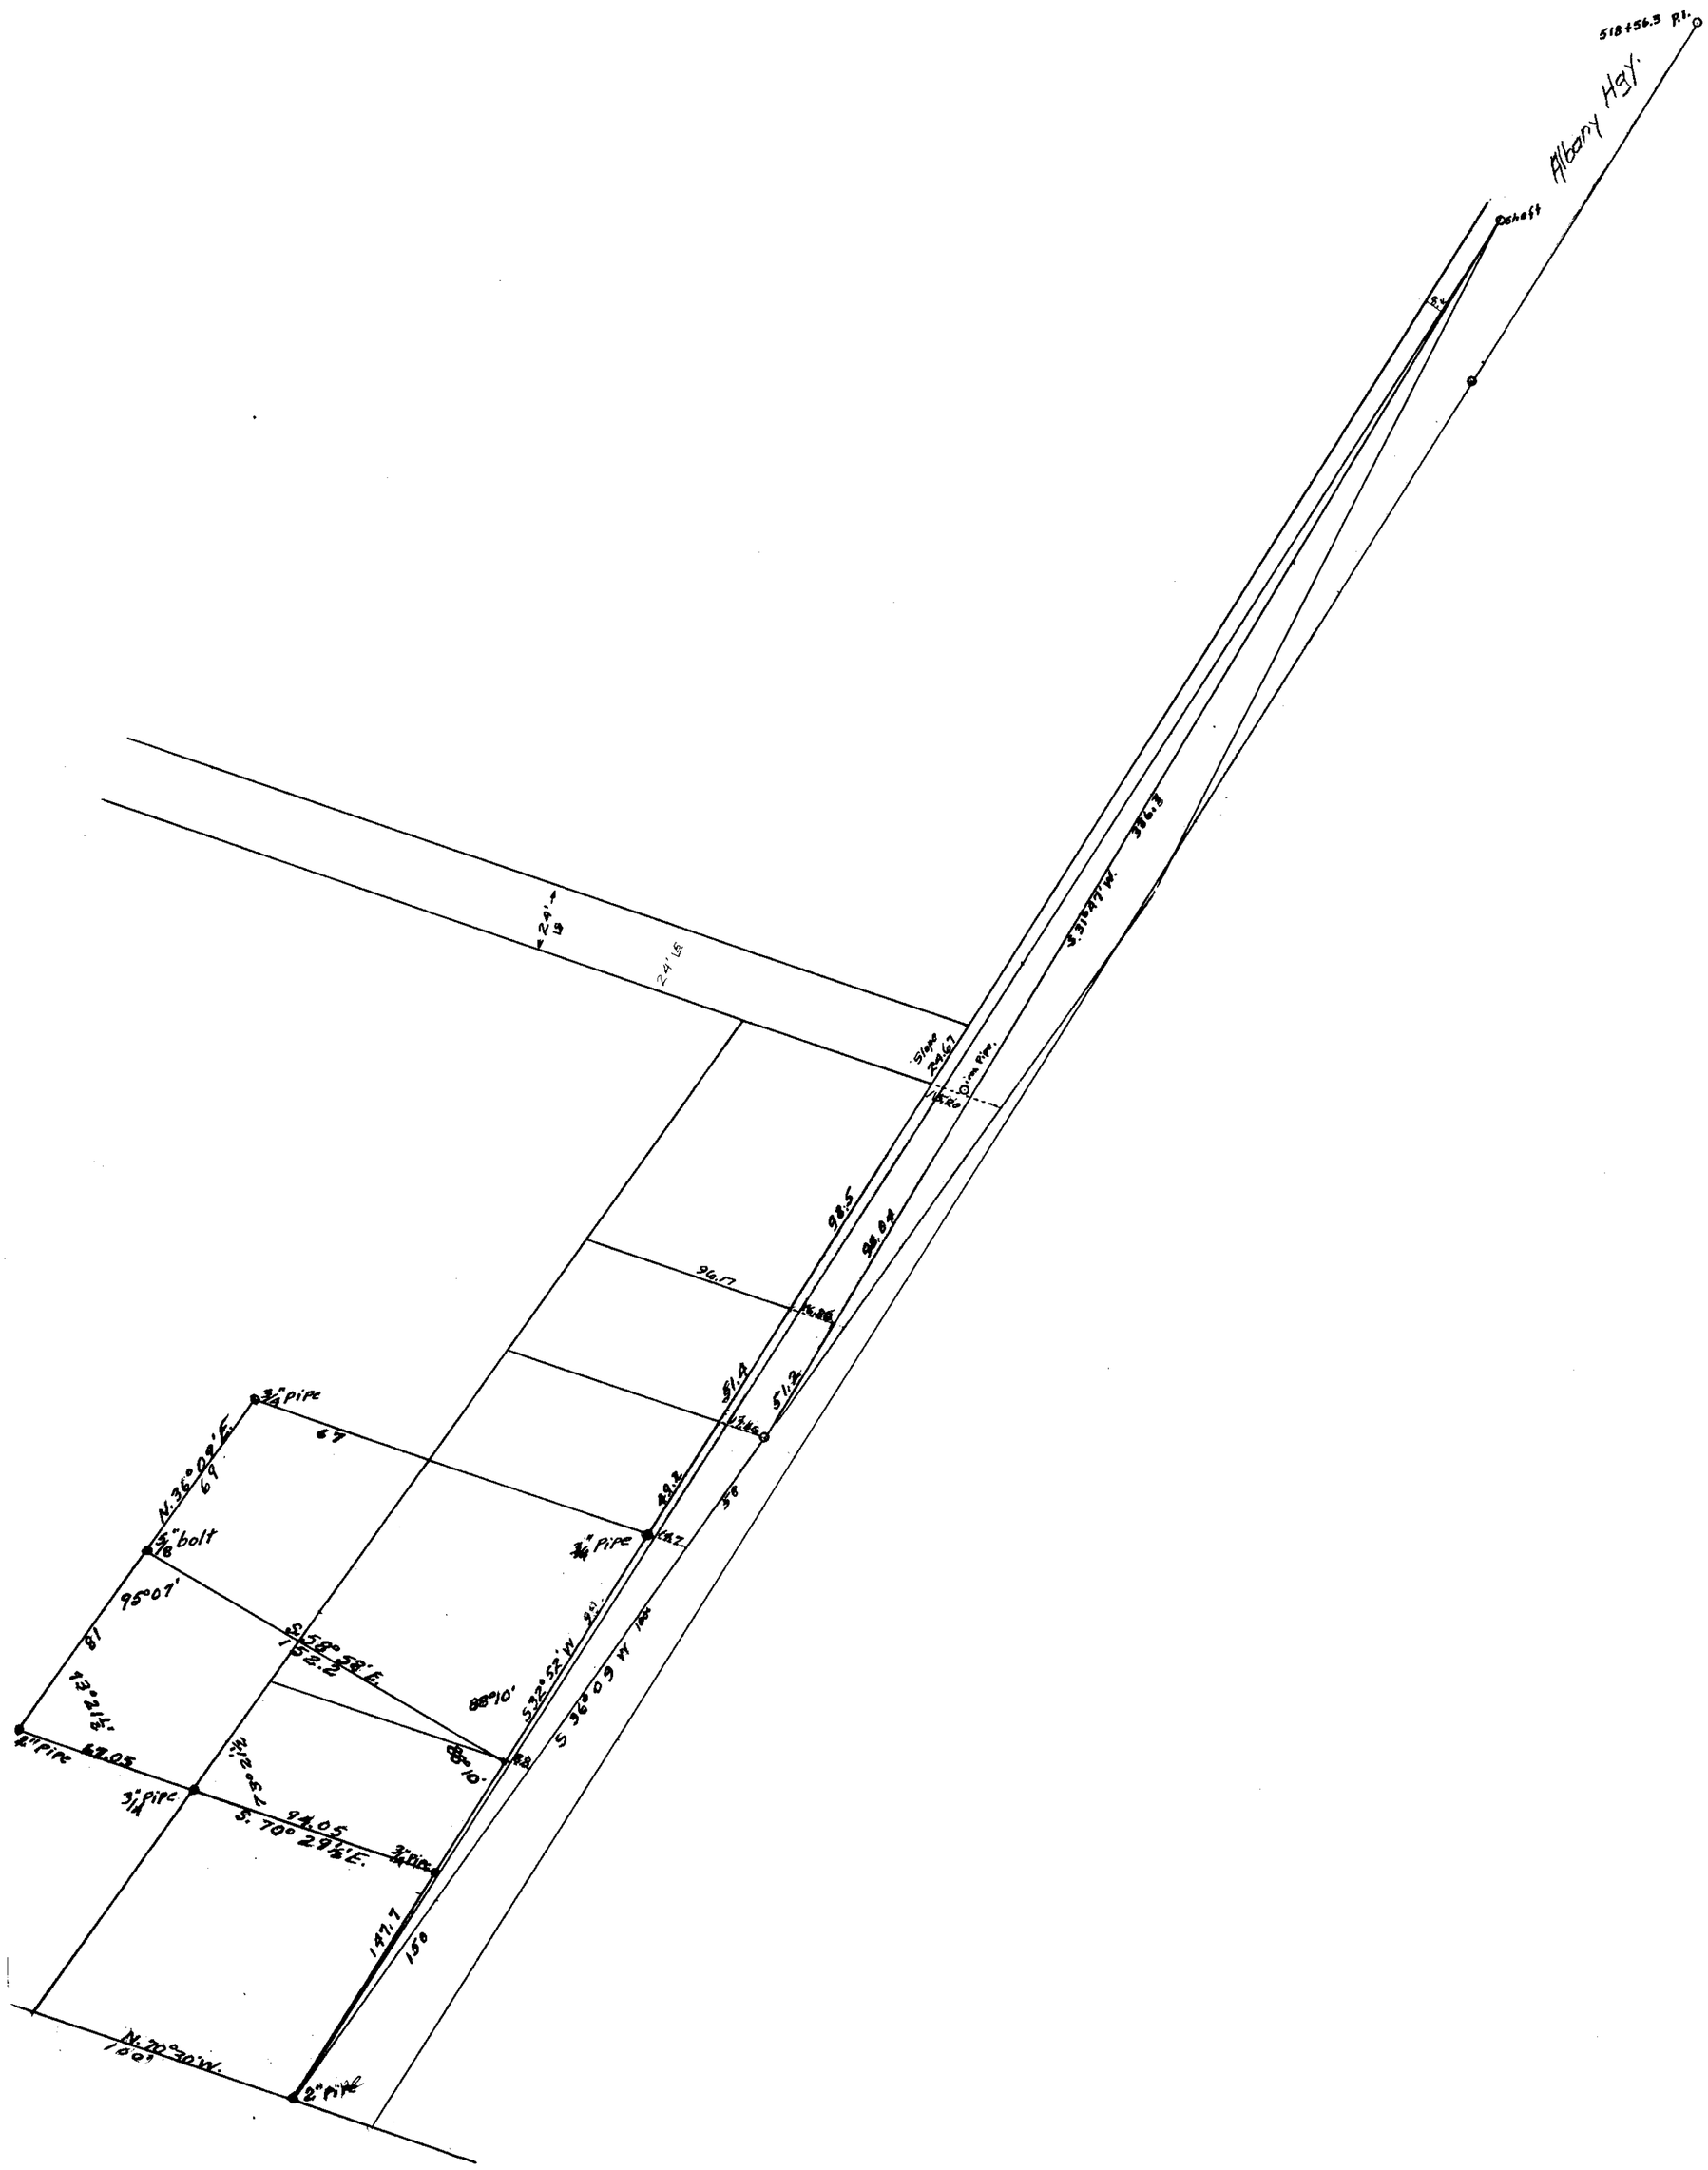
C.S. NO. 135