


11-5

11-5-00036

C.S. 135

Use C.S. 96

25

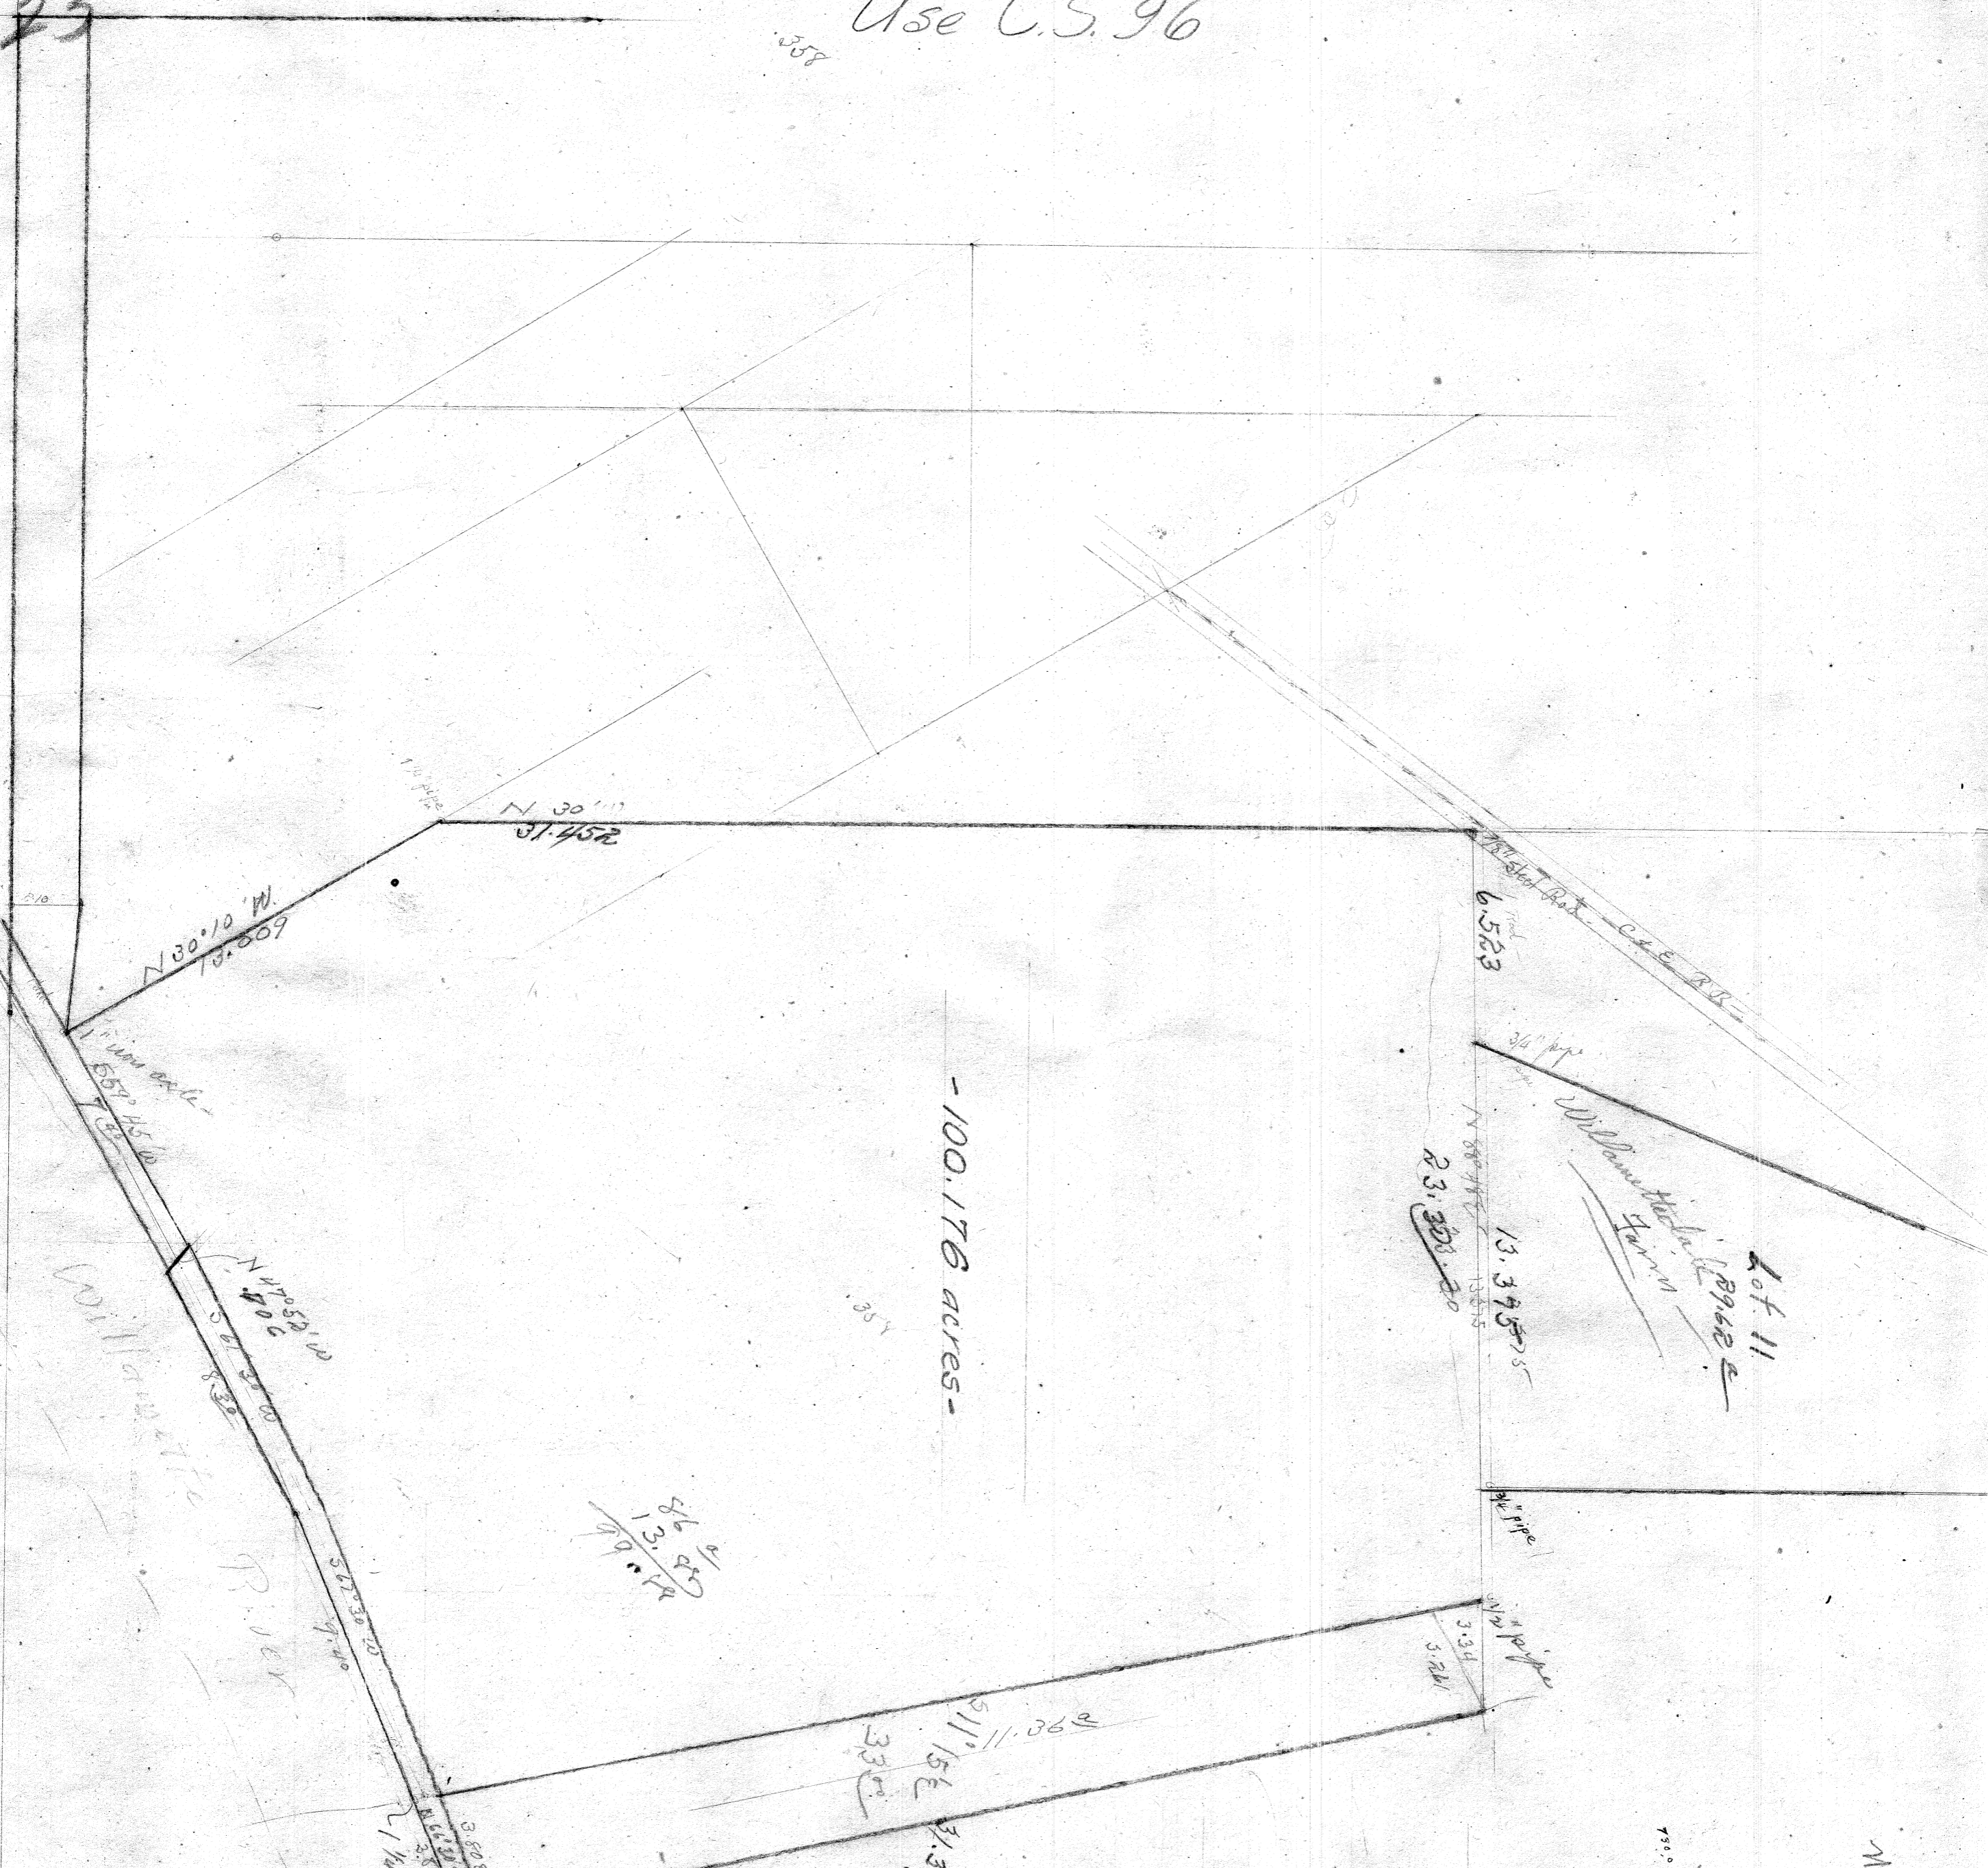

- 100.176 acres -

Lot 11  
18962  

13.345  
N 88° 45' 13.345

23.303

36 257  
13.12

31.34  
33.01  
51.15  
11.36

31.34

SURVEY # 135

John Stewart Lic # 49- TIAS R. 511  
for  
Julian McFadden

Scale 1" = 400'

3/18, 1943, F. Marvin M...  
Twp. Cnty. Oreg.

C.S. 135

M. M. M.  
