11-6
14,15,22

00005

COUNTY SURVEY #255

Tp. 11 S. R. 6 W. W. M.

Scale 1" = 20 chs.

W. C. Galloway C.S.

Nov. 27, 1916.

Made For

James F. Mc Donough

Ella G. Mc Donough

Mary E. Mc Donough

C. E. Jackson
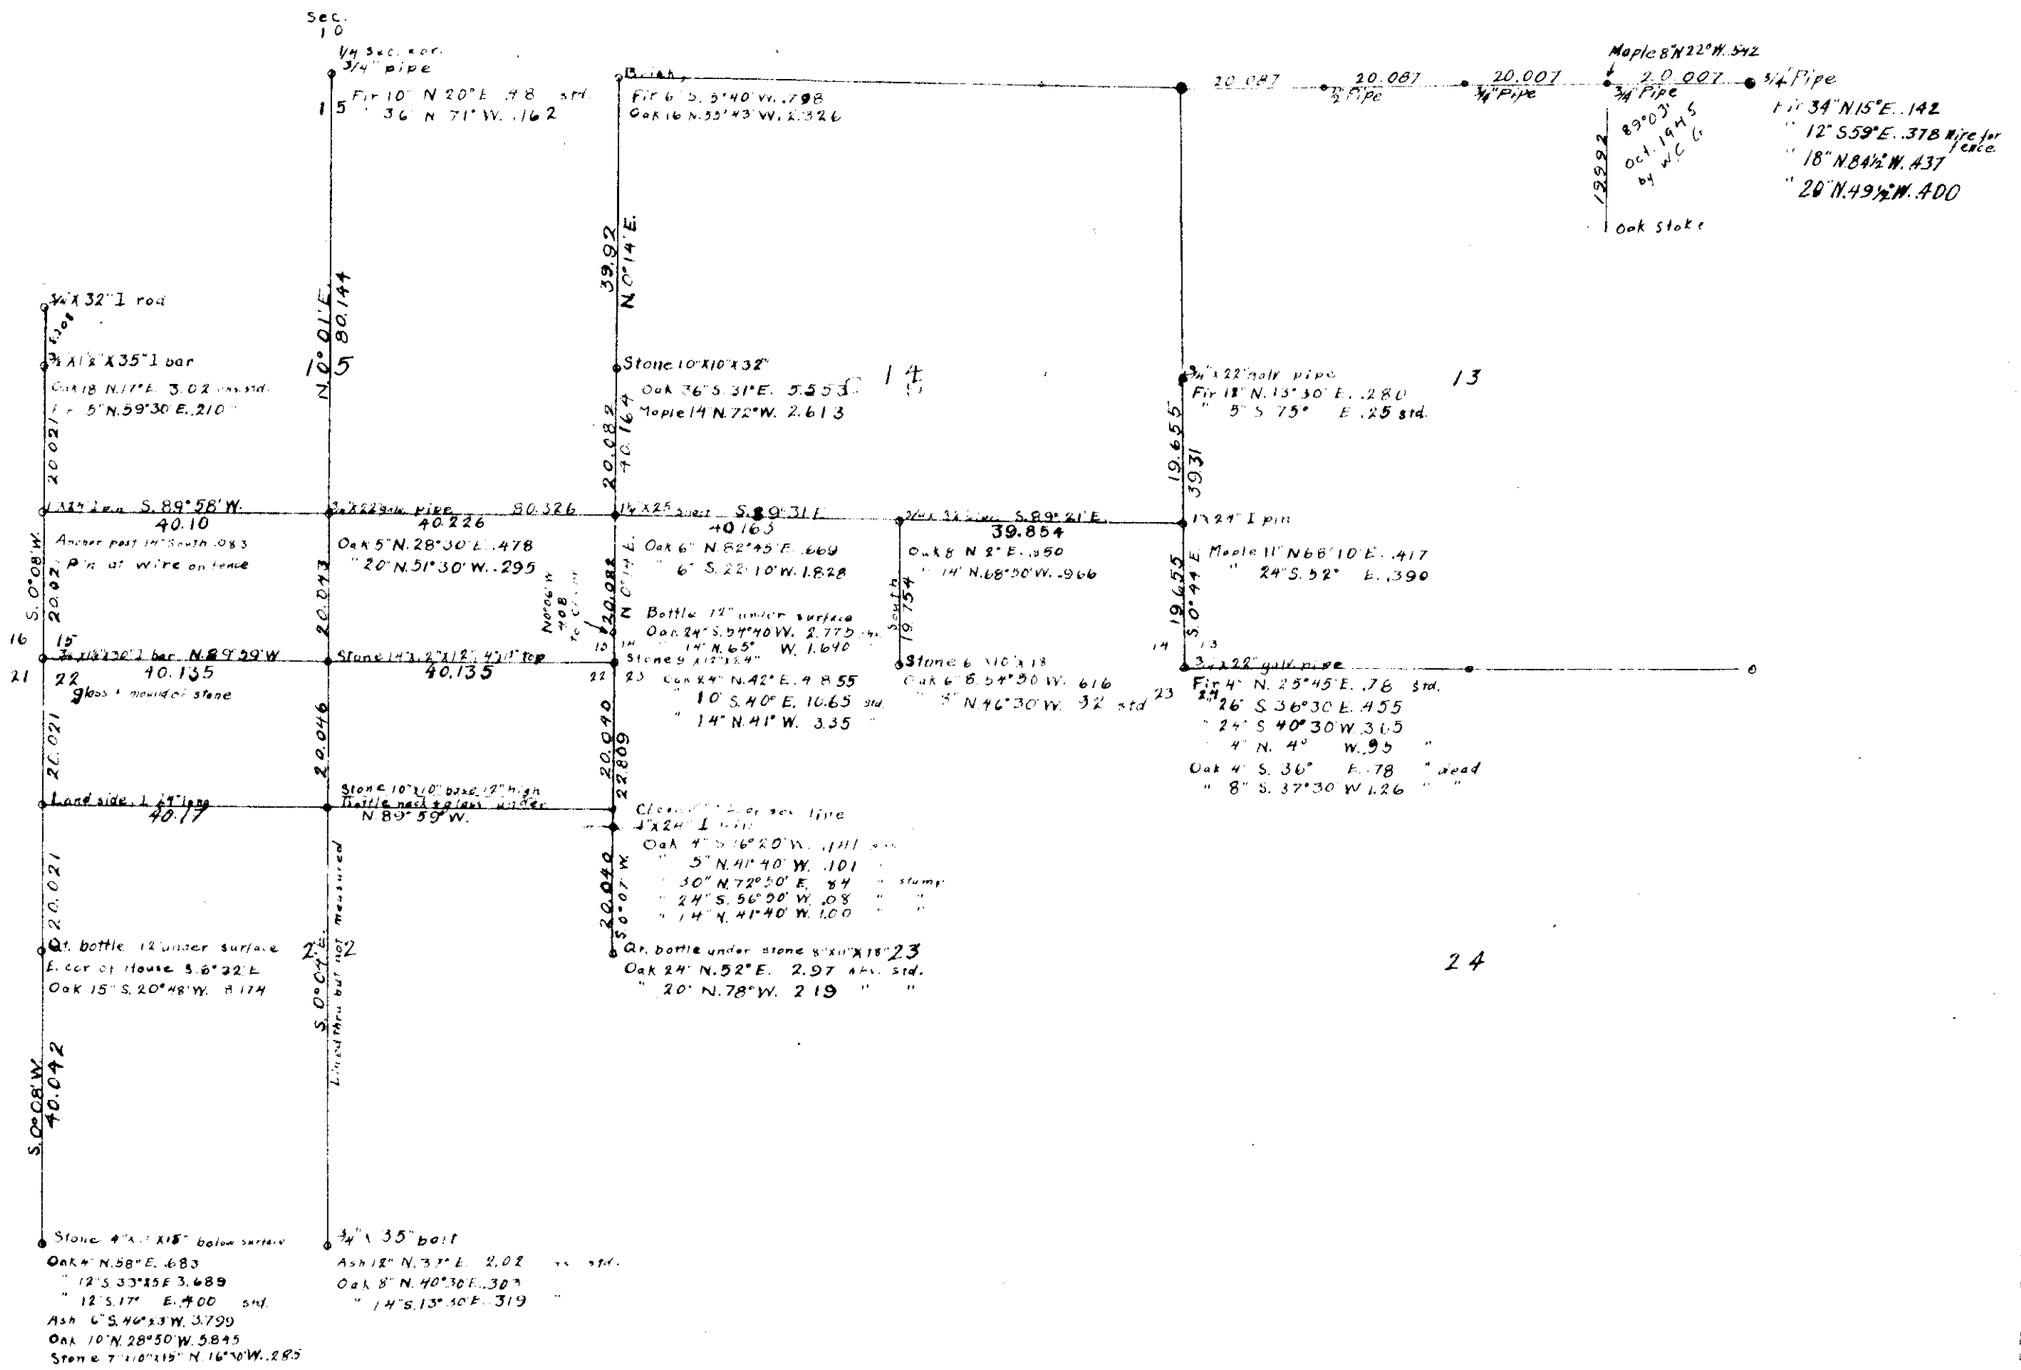
Henry Harkson