11-6 00009

20 & 21

COUNTY SURVEY Nº 246

Scale 1" = 6 chs
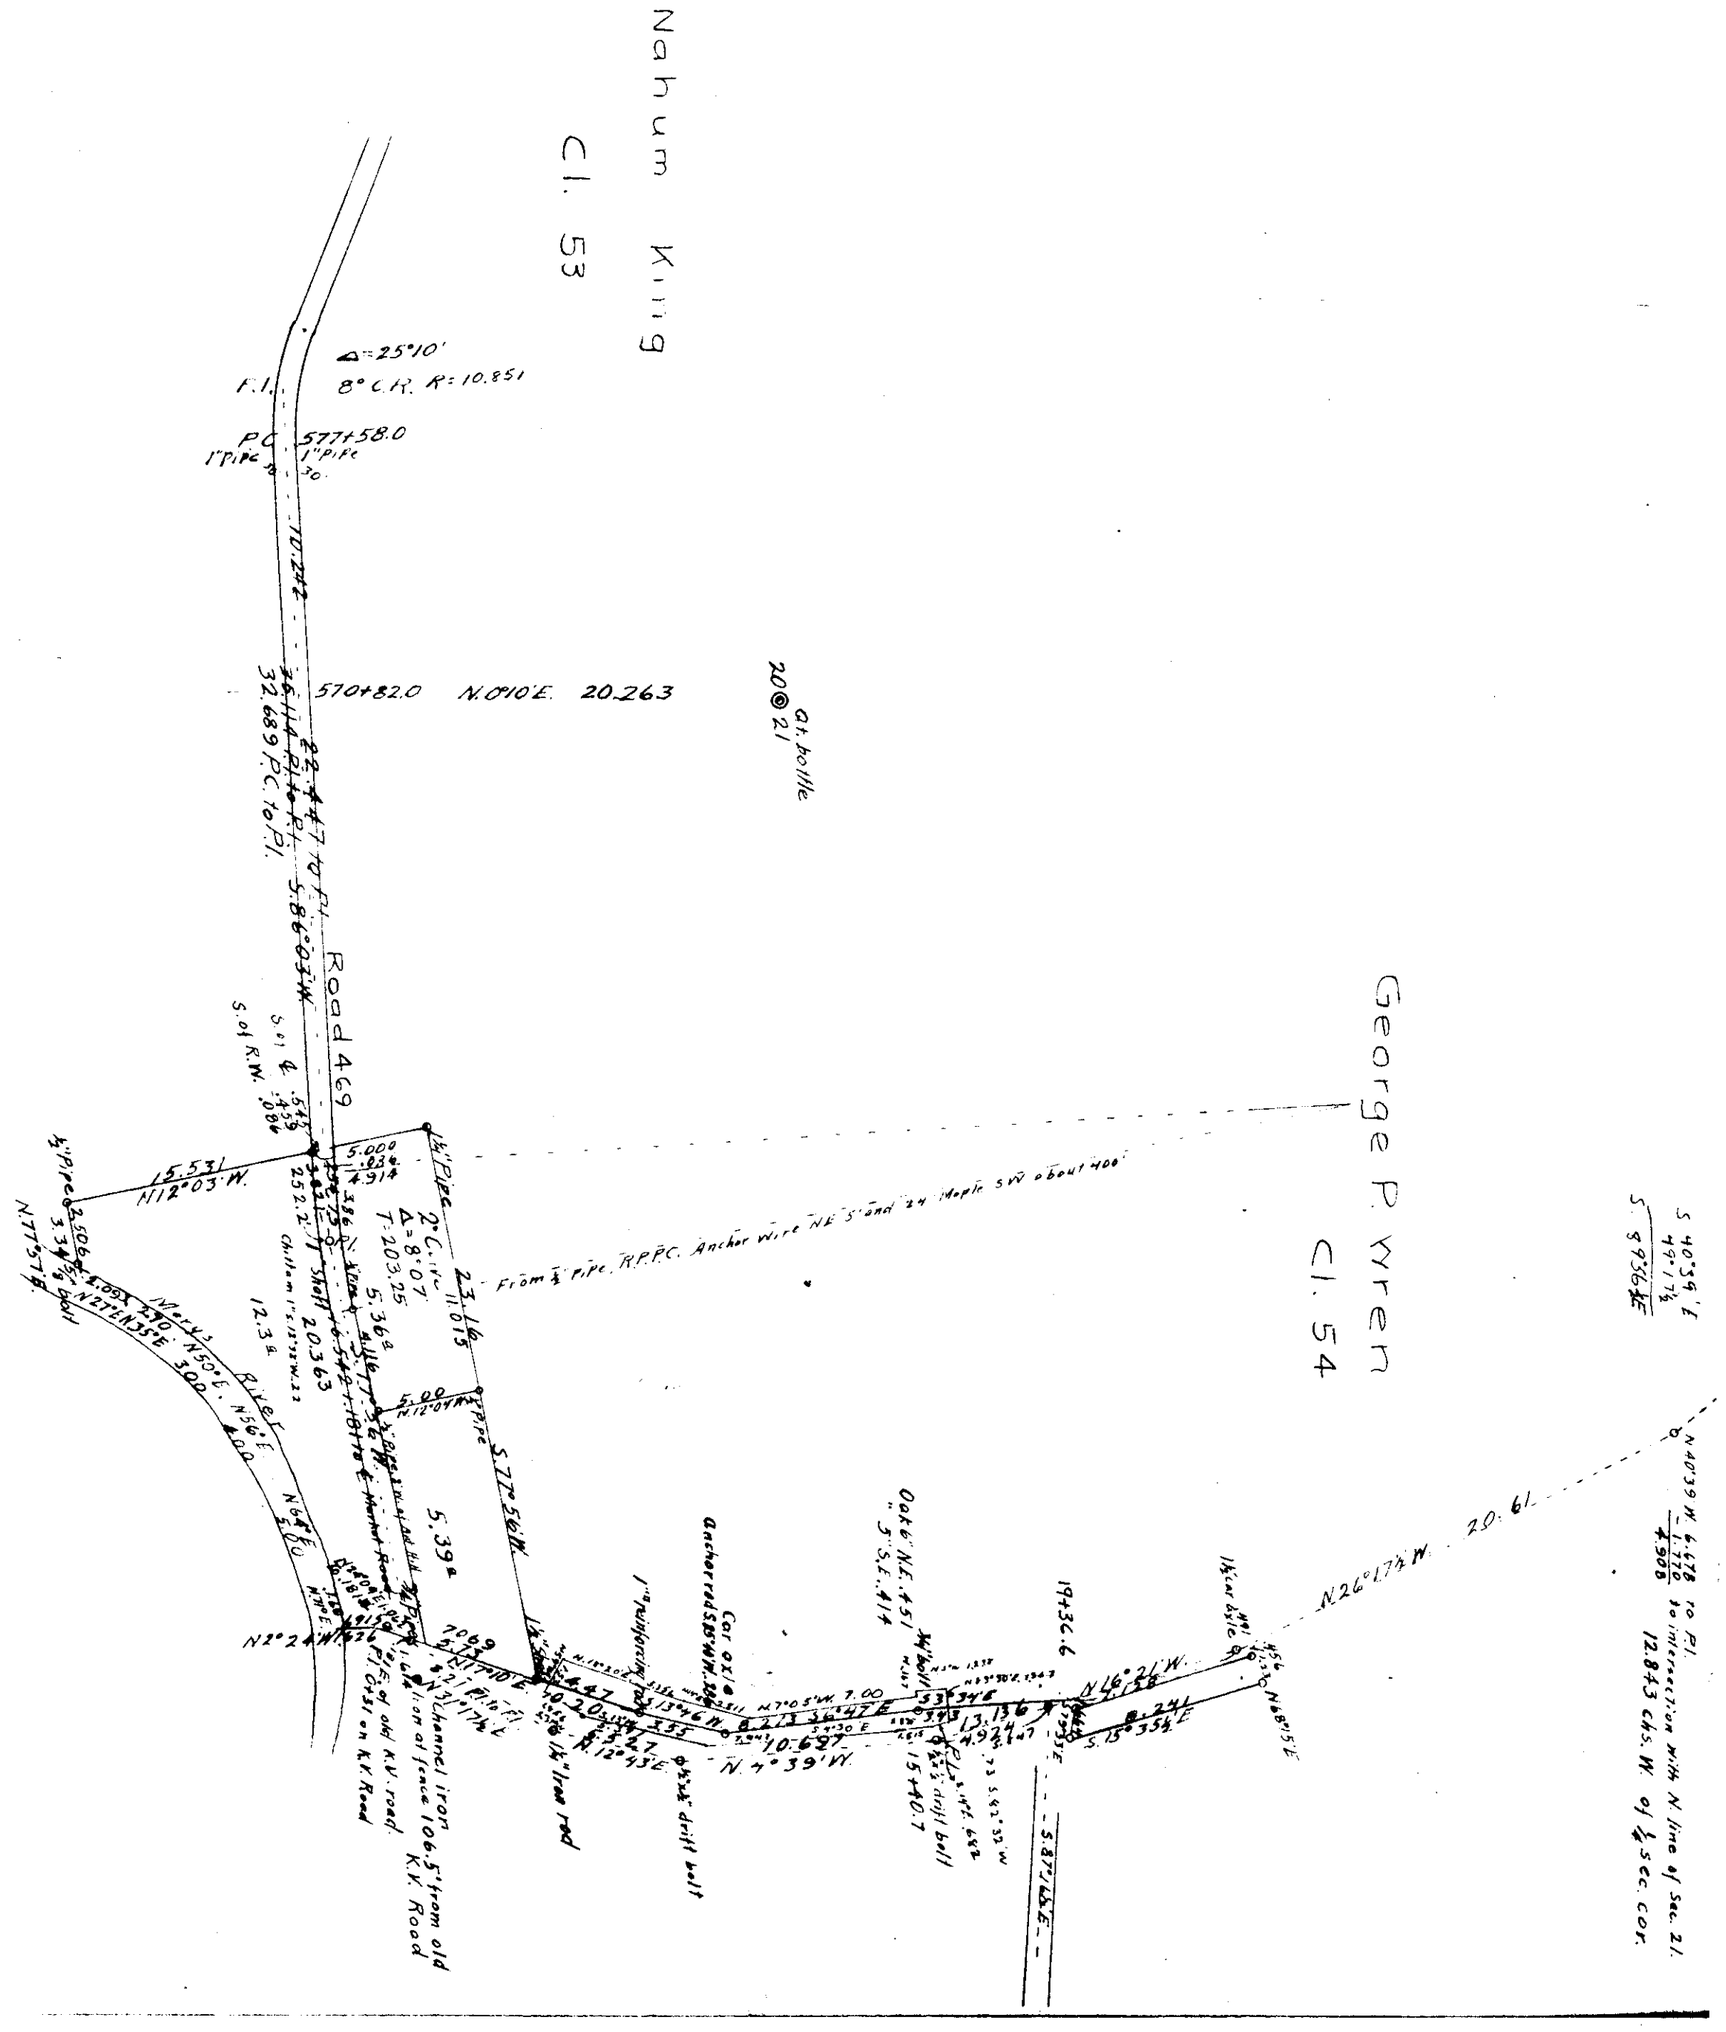
W.C. Calloway C.S.