COUNTY SURVEY #199 SEC. 16 & 17

SCALE 1" = 10chs.

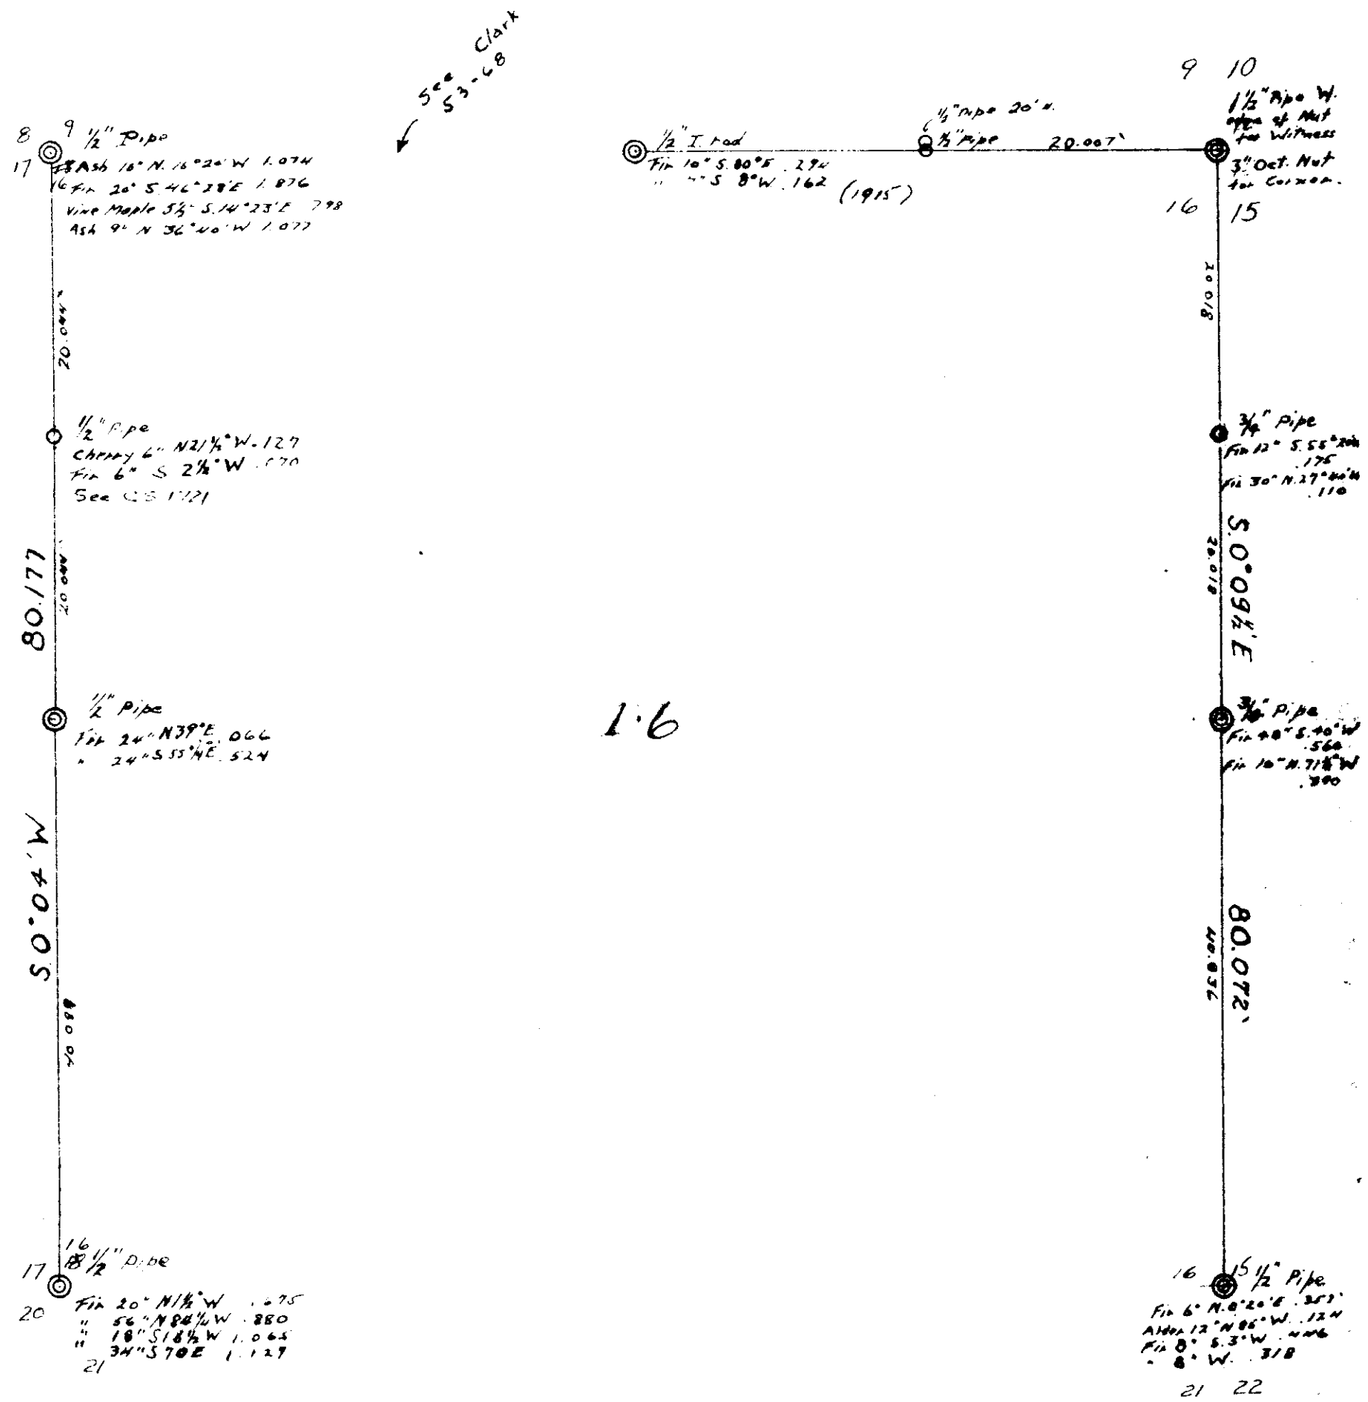

80000

16,17
7-11