


1237A & 5W
18-13
00002

C.S. 132 & 309

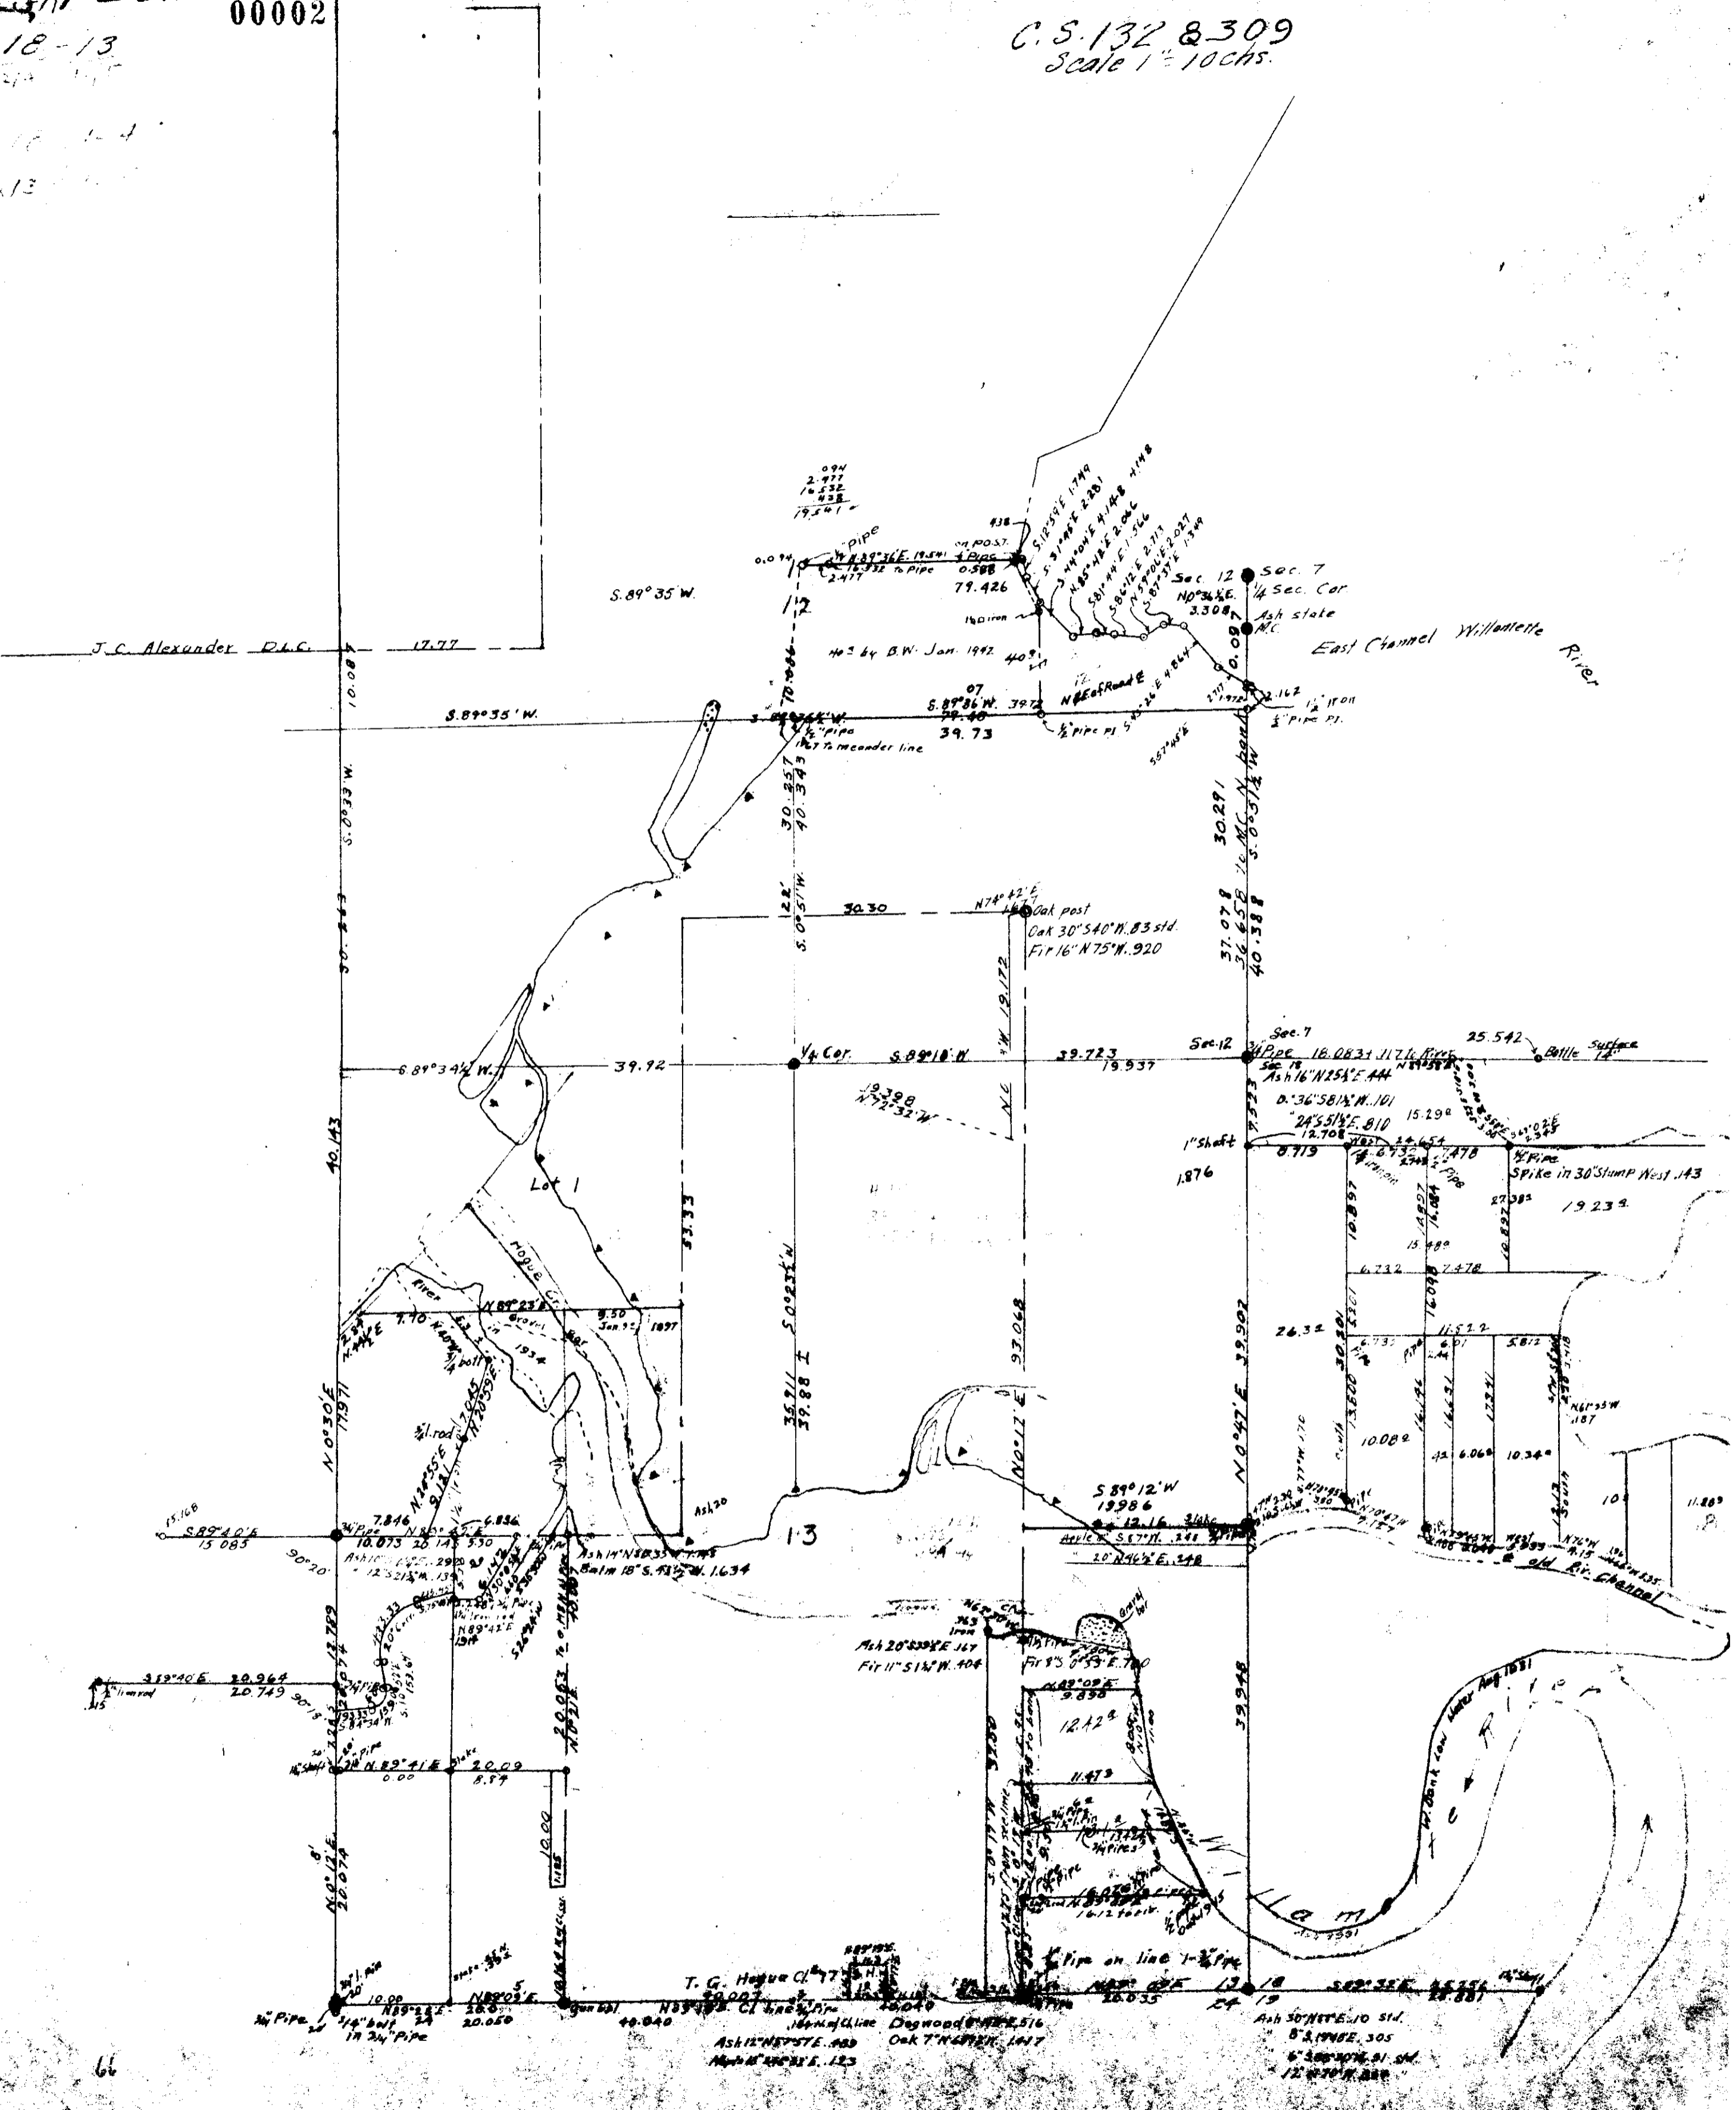

66

1000