COUNTY SURVEY NO. 212

JOS. C. AVERY D.L.C. NO. 41
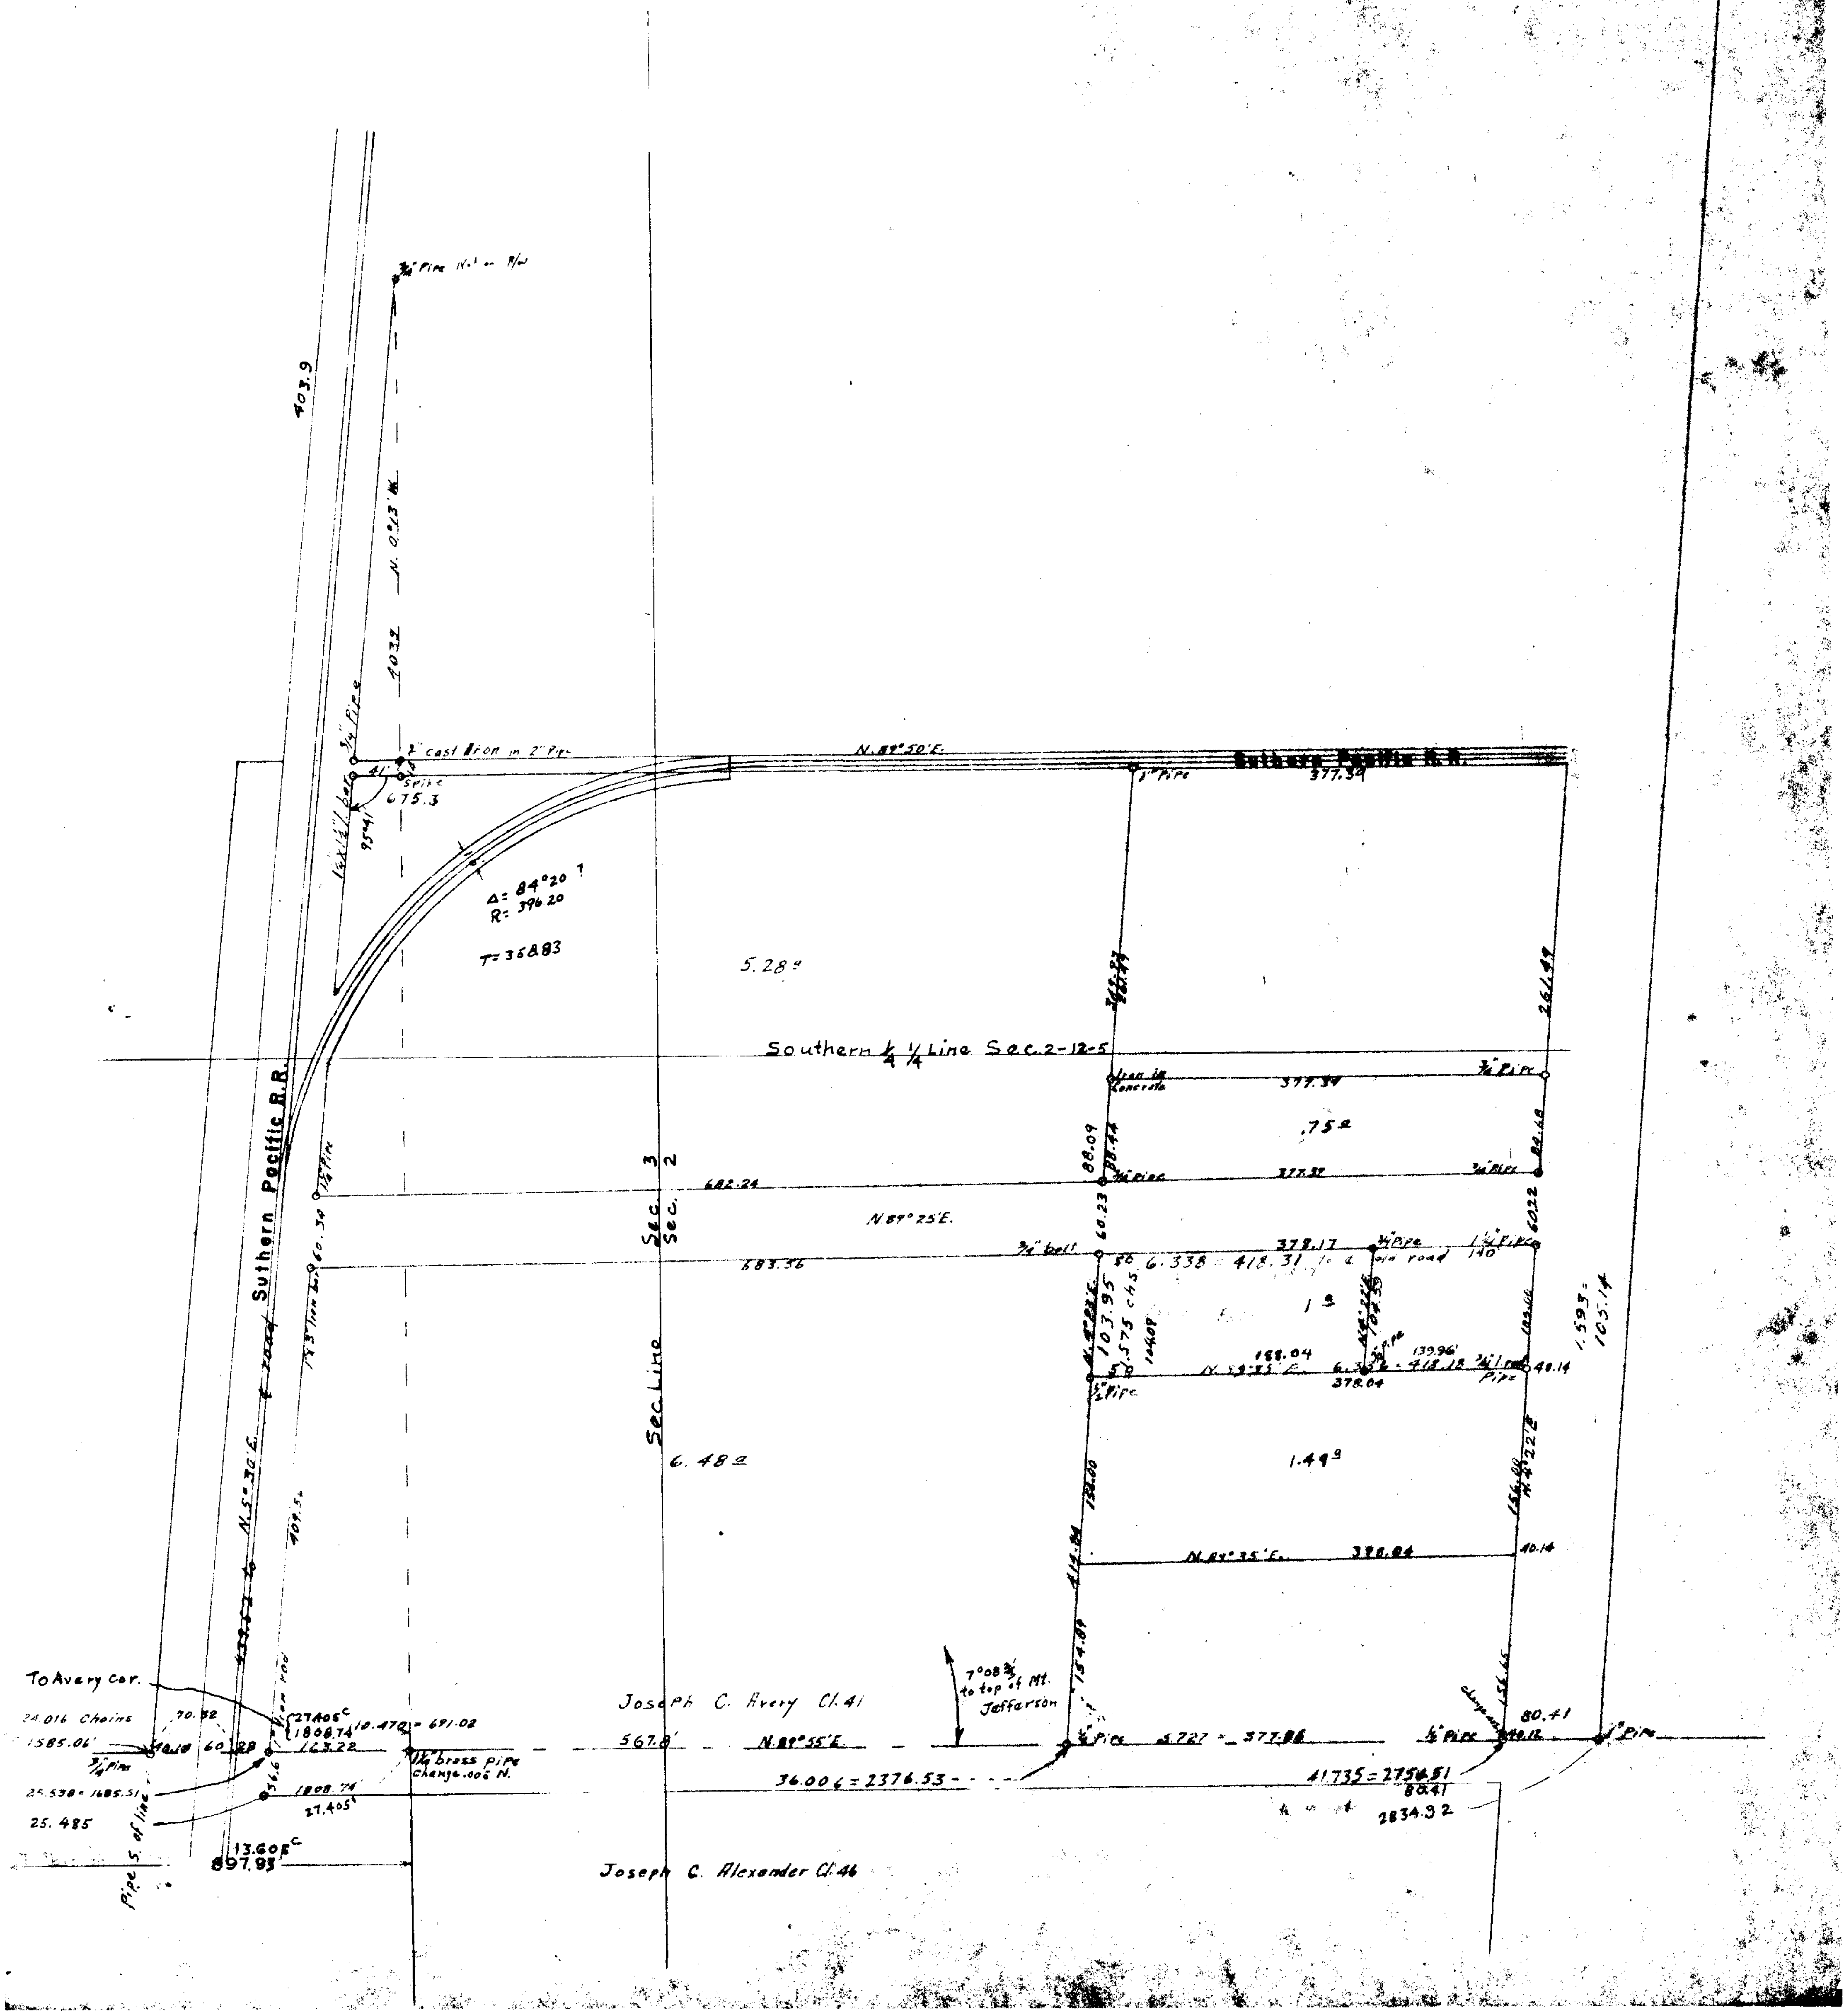
Scale 1"=100'