12-5
3

00014

County Survey No. 166
BELL TRACTS

James A. Bennett Cl. 45

T. 12 S. R. 5 W. W. M.

Scale 1" = 100'
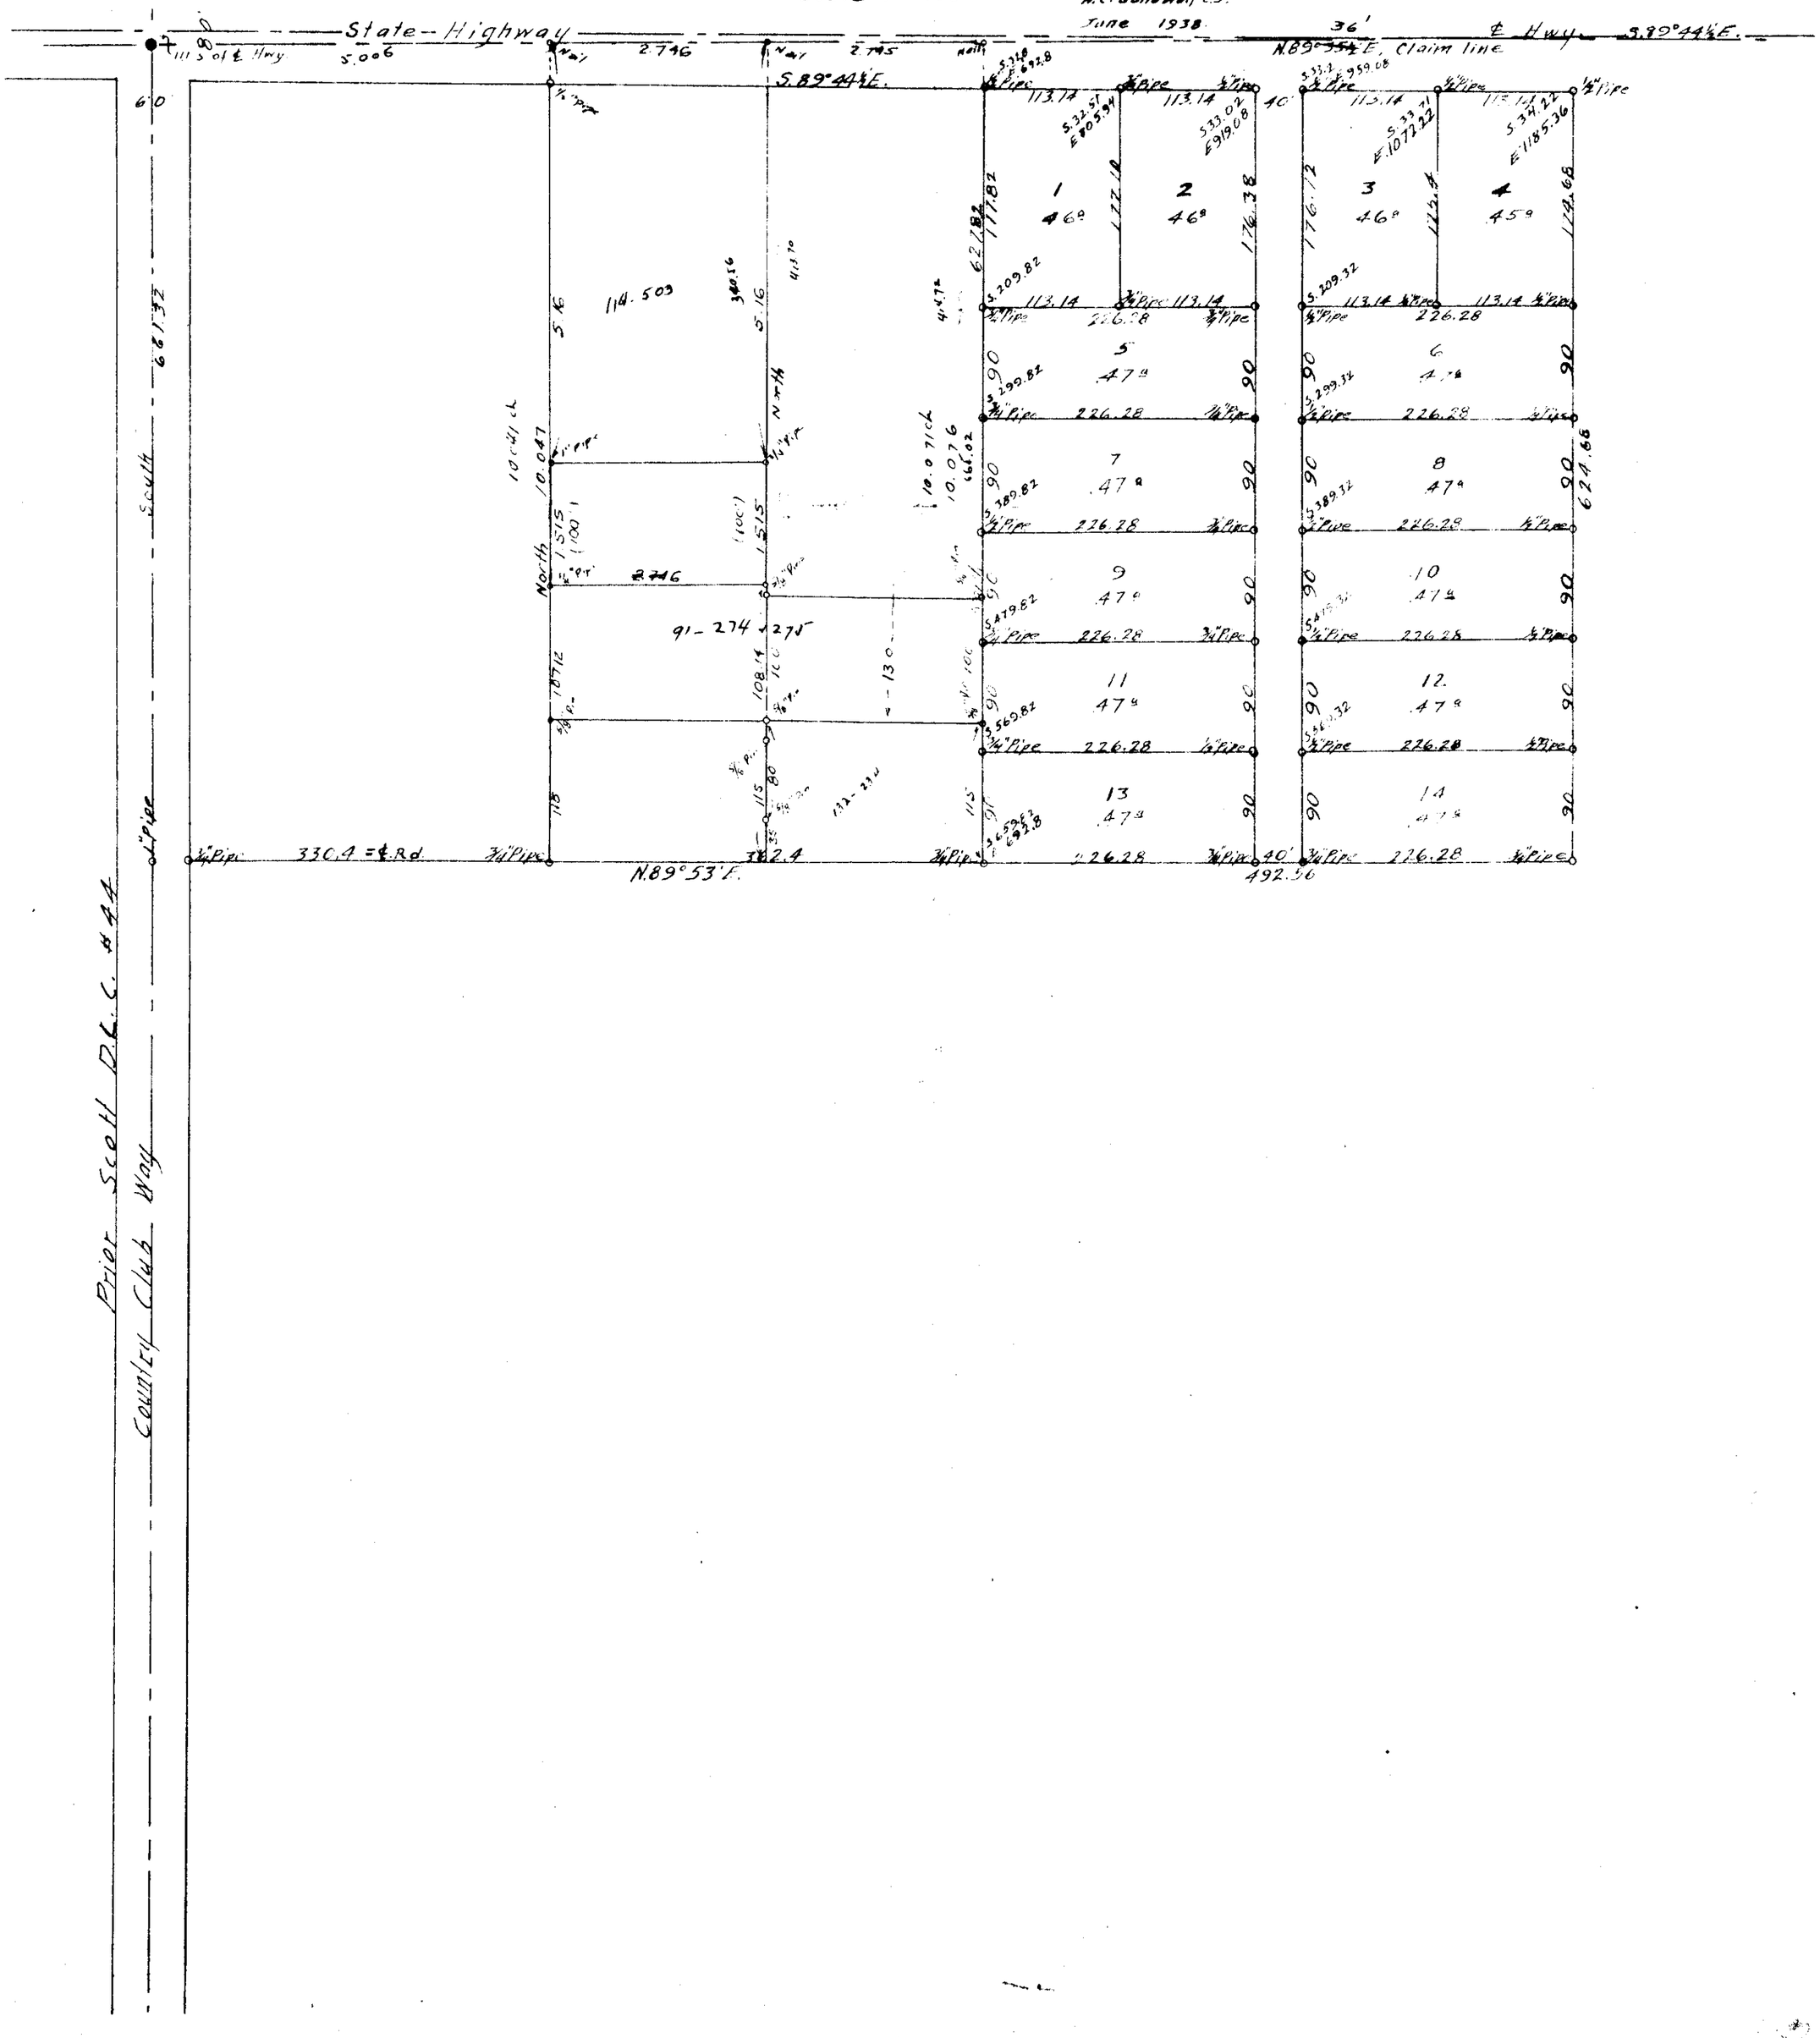
W. C. Galloway C.S.
June 1938.