12-5
3810

00018

COUNTY SURVEY 166

JAMES A. BENNETT CL. 45

Scale 1" = 4 Chains
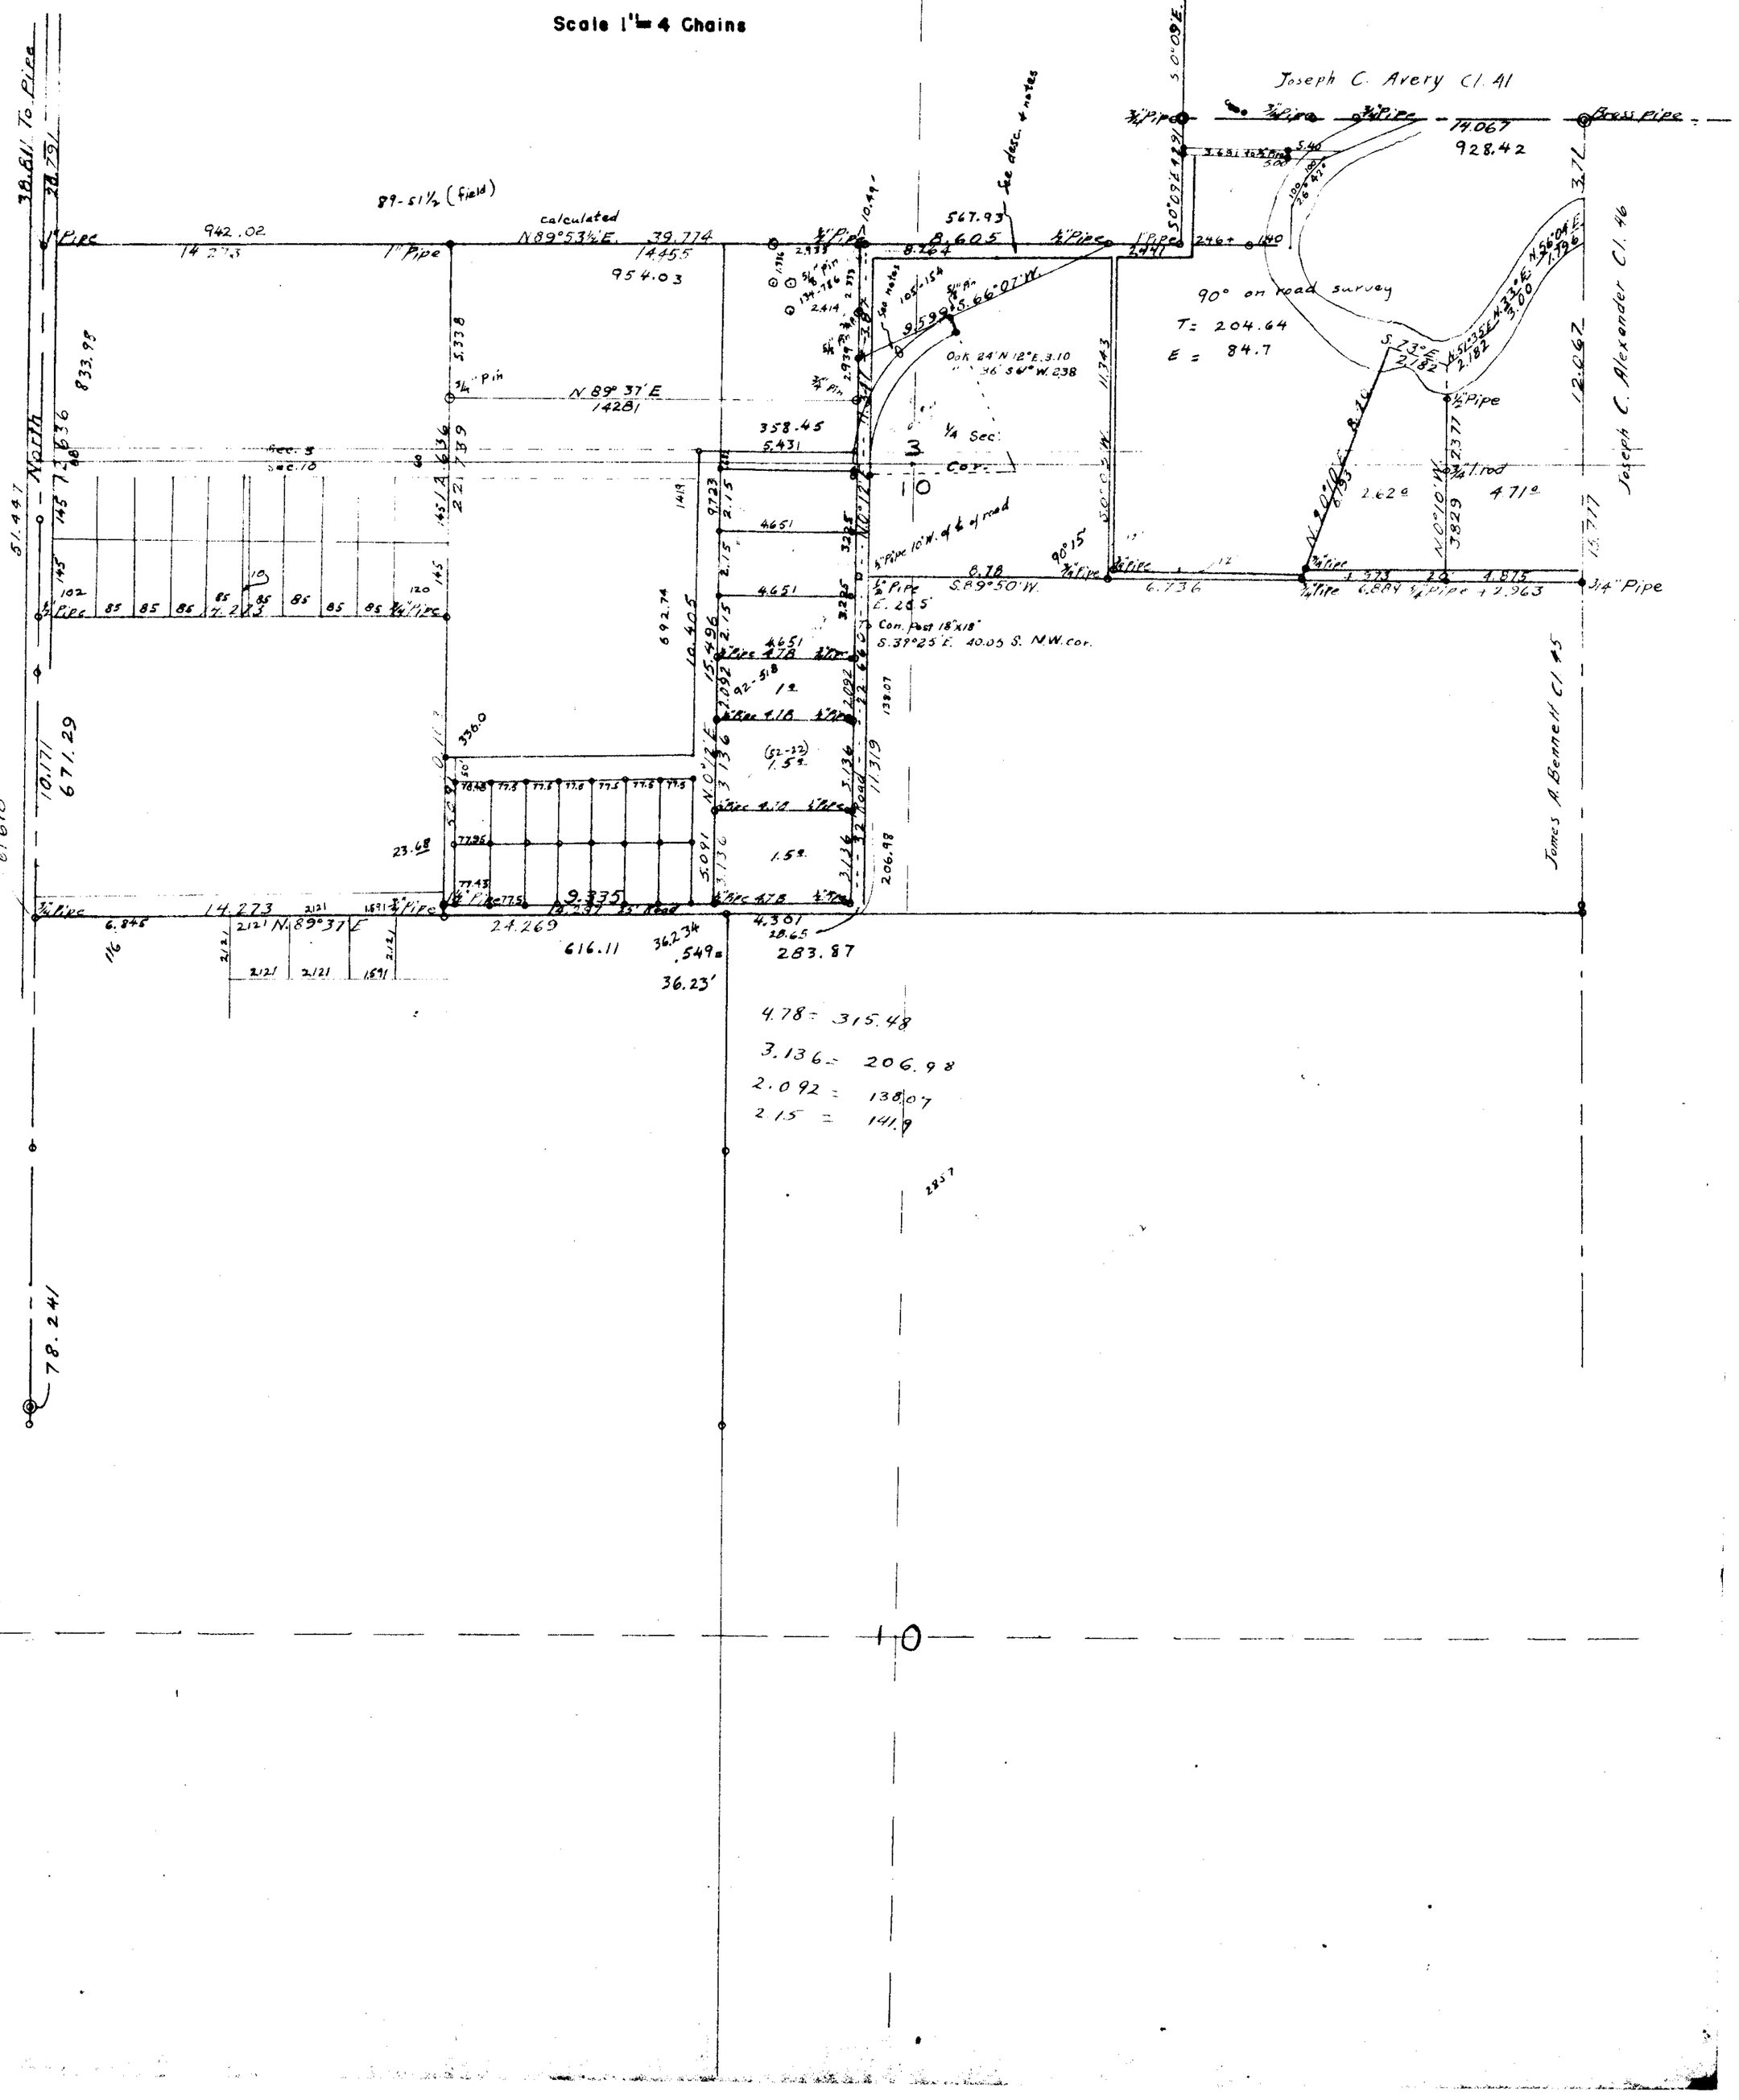
For
E. T. Reed
Curtis Kelly