12-5
4

00019

COUNTY SURVEY NO. 124

A G. HOVEY D.L.C. No. 43

T. 12 S., R. 5 W., W.M.
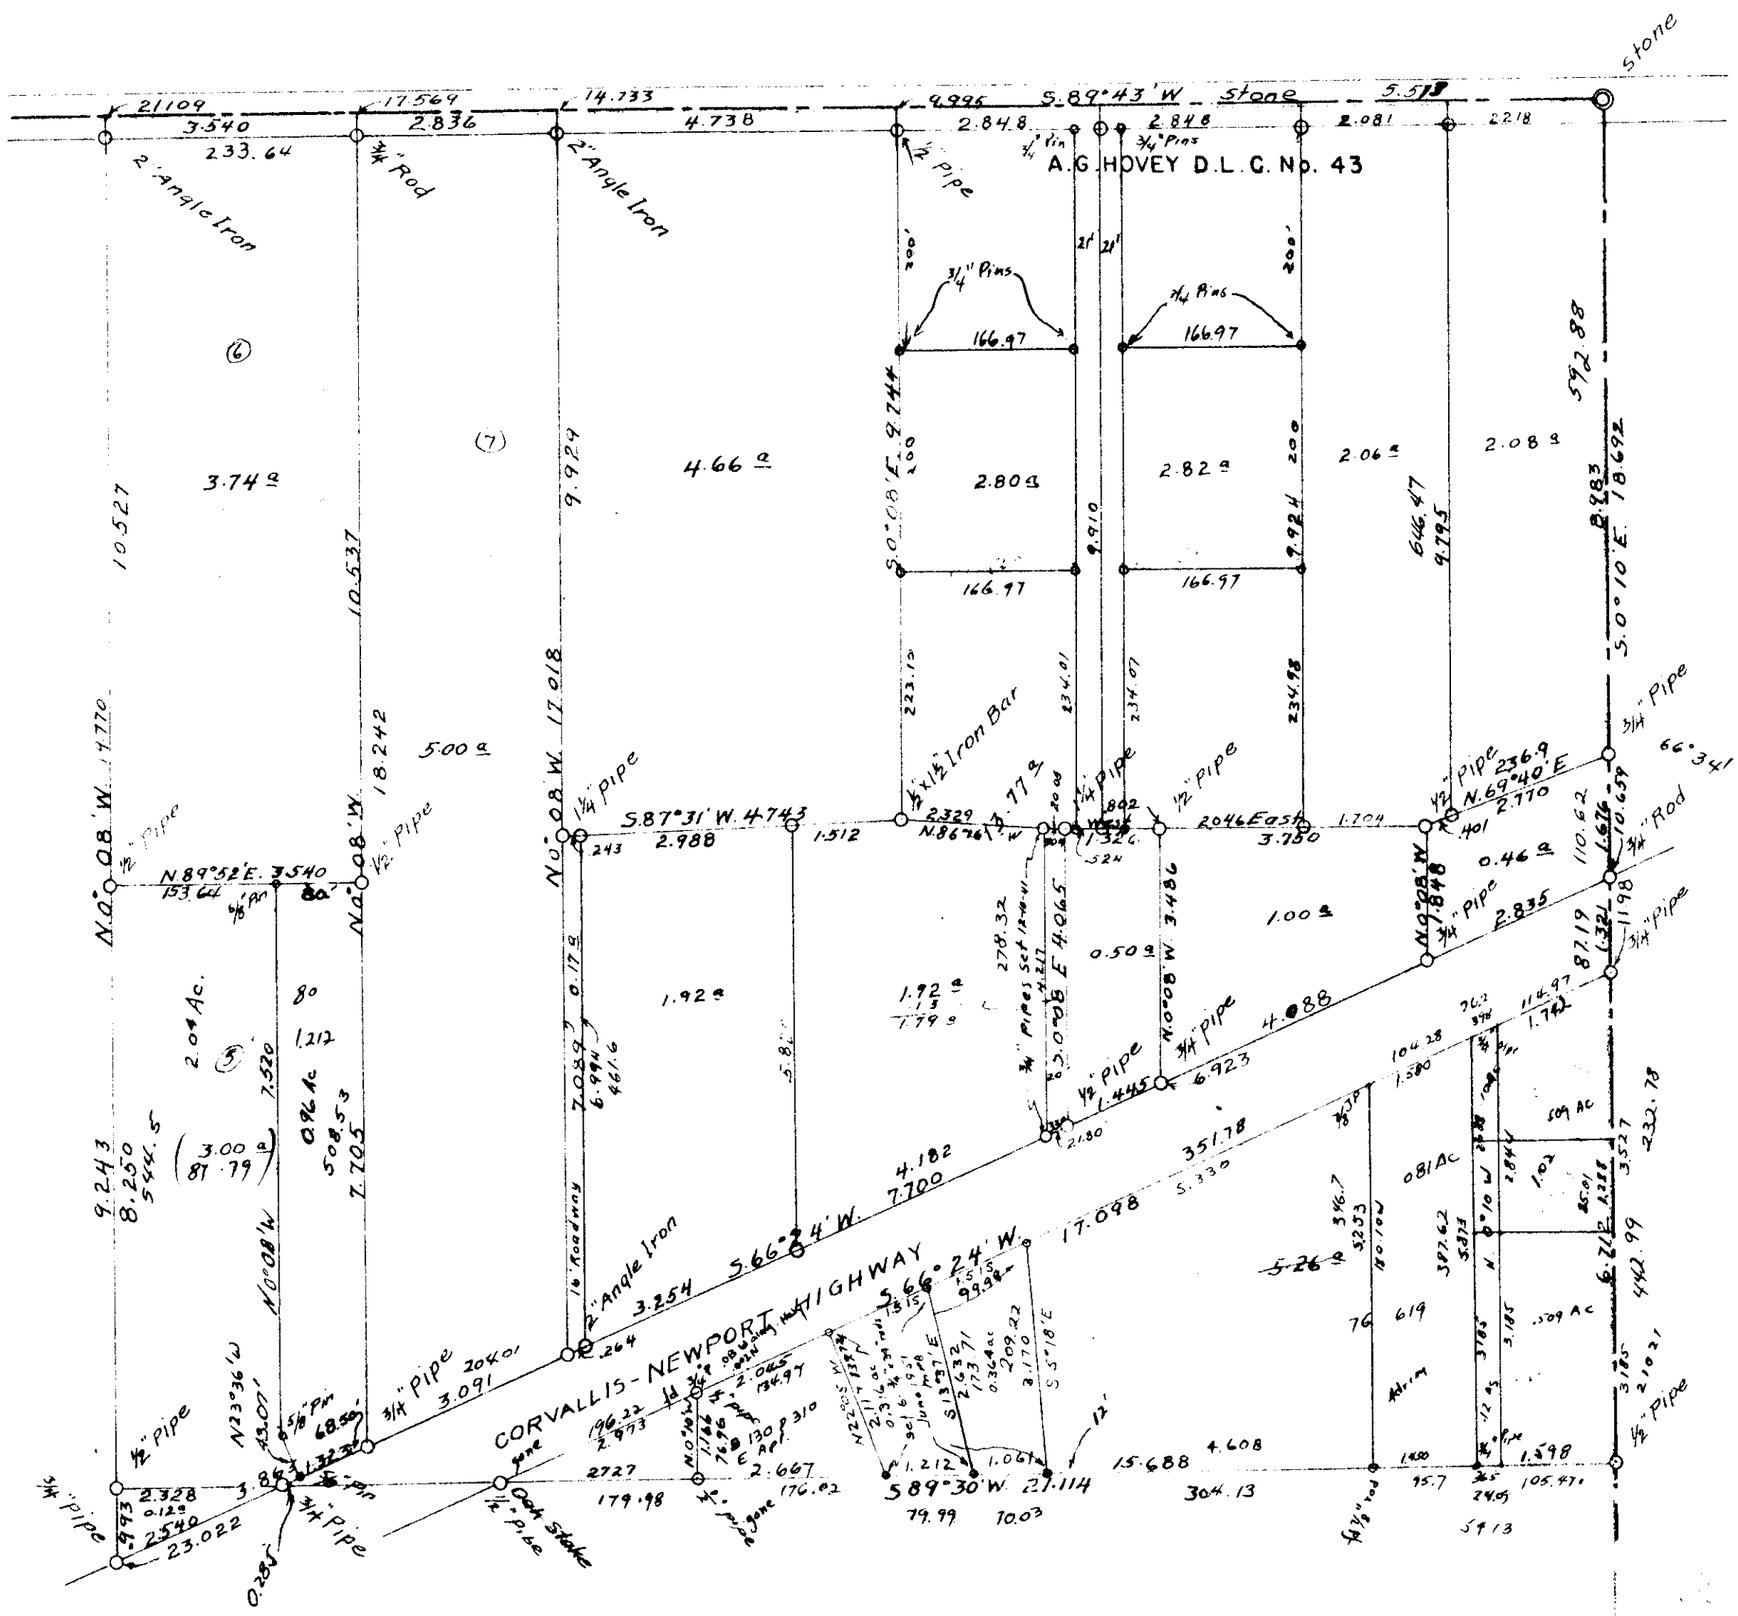
Scale 1" = 2.00 Chs. Mary Lowell Property.