12-5 00021 C.S. 61
4

PRIER SCOTT CL. 44.
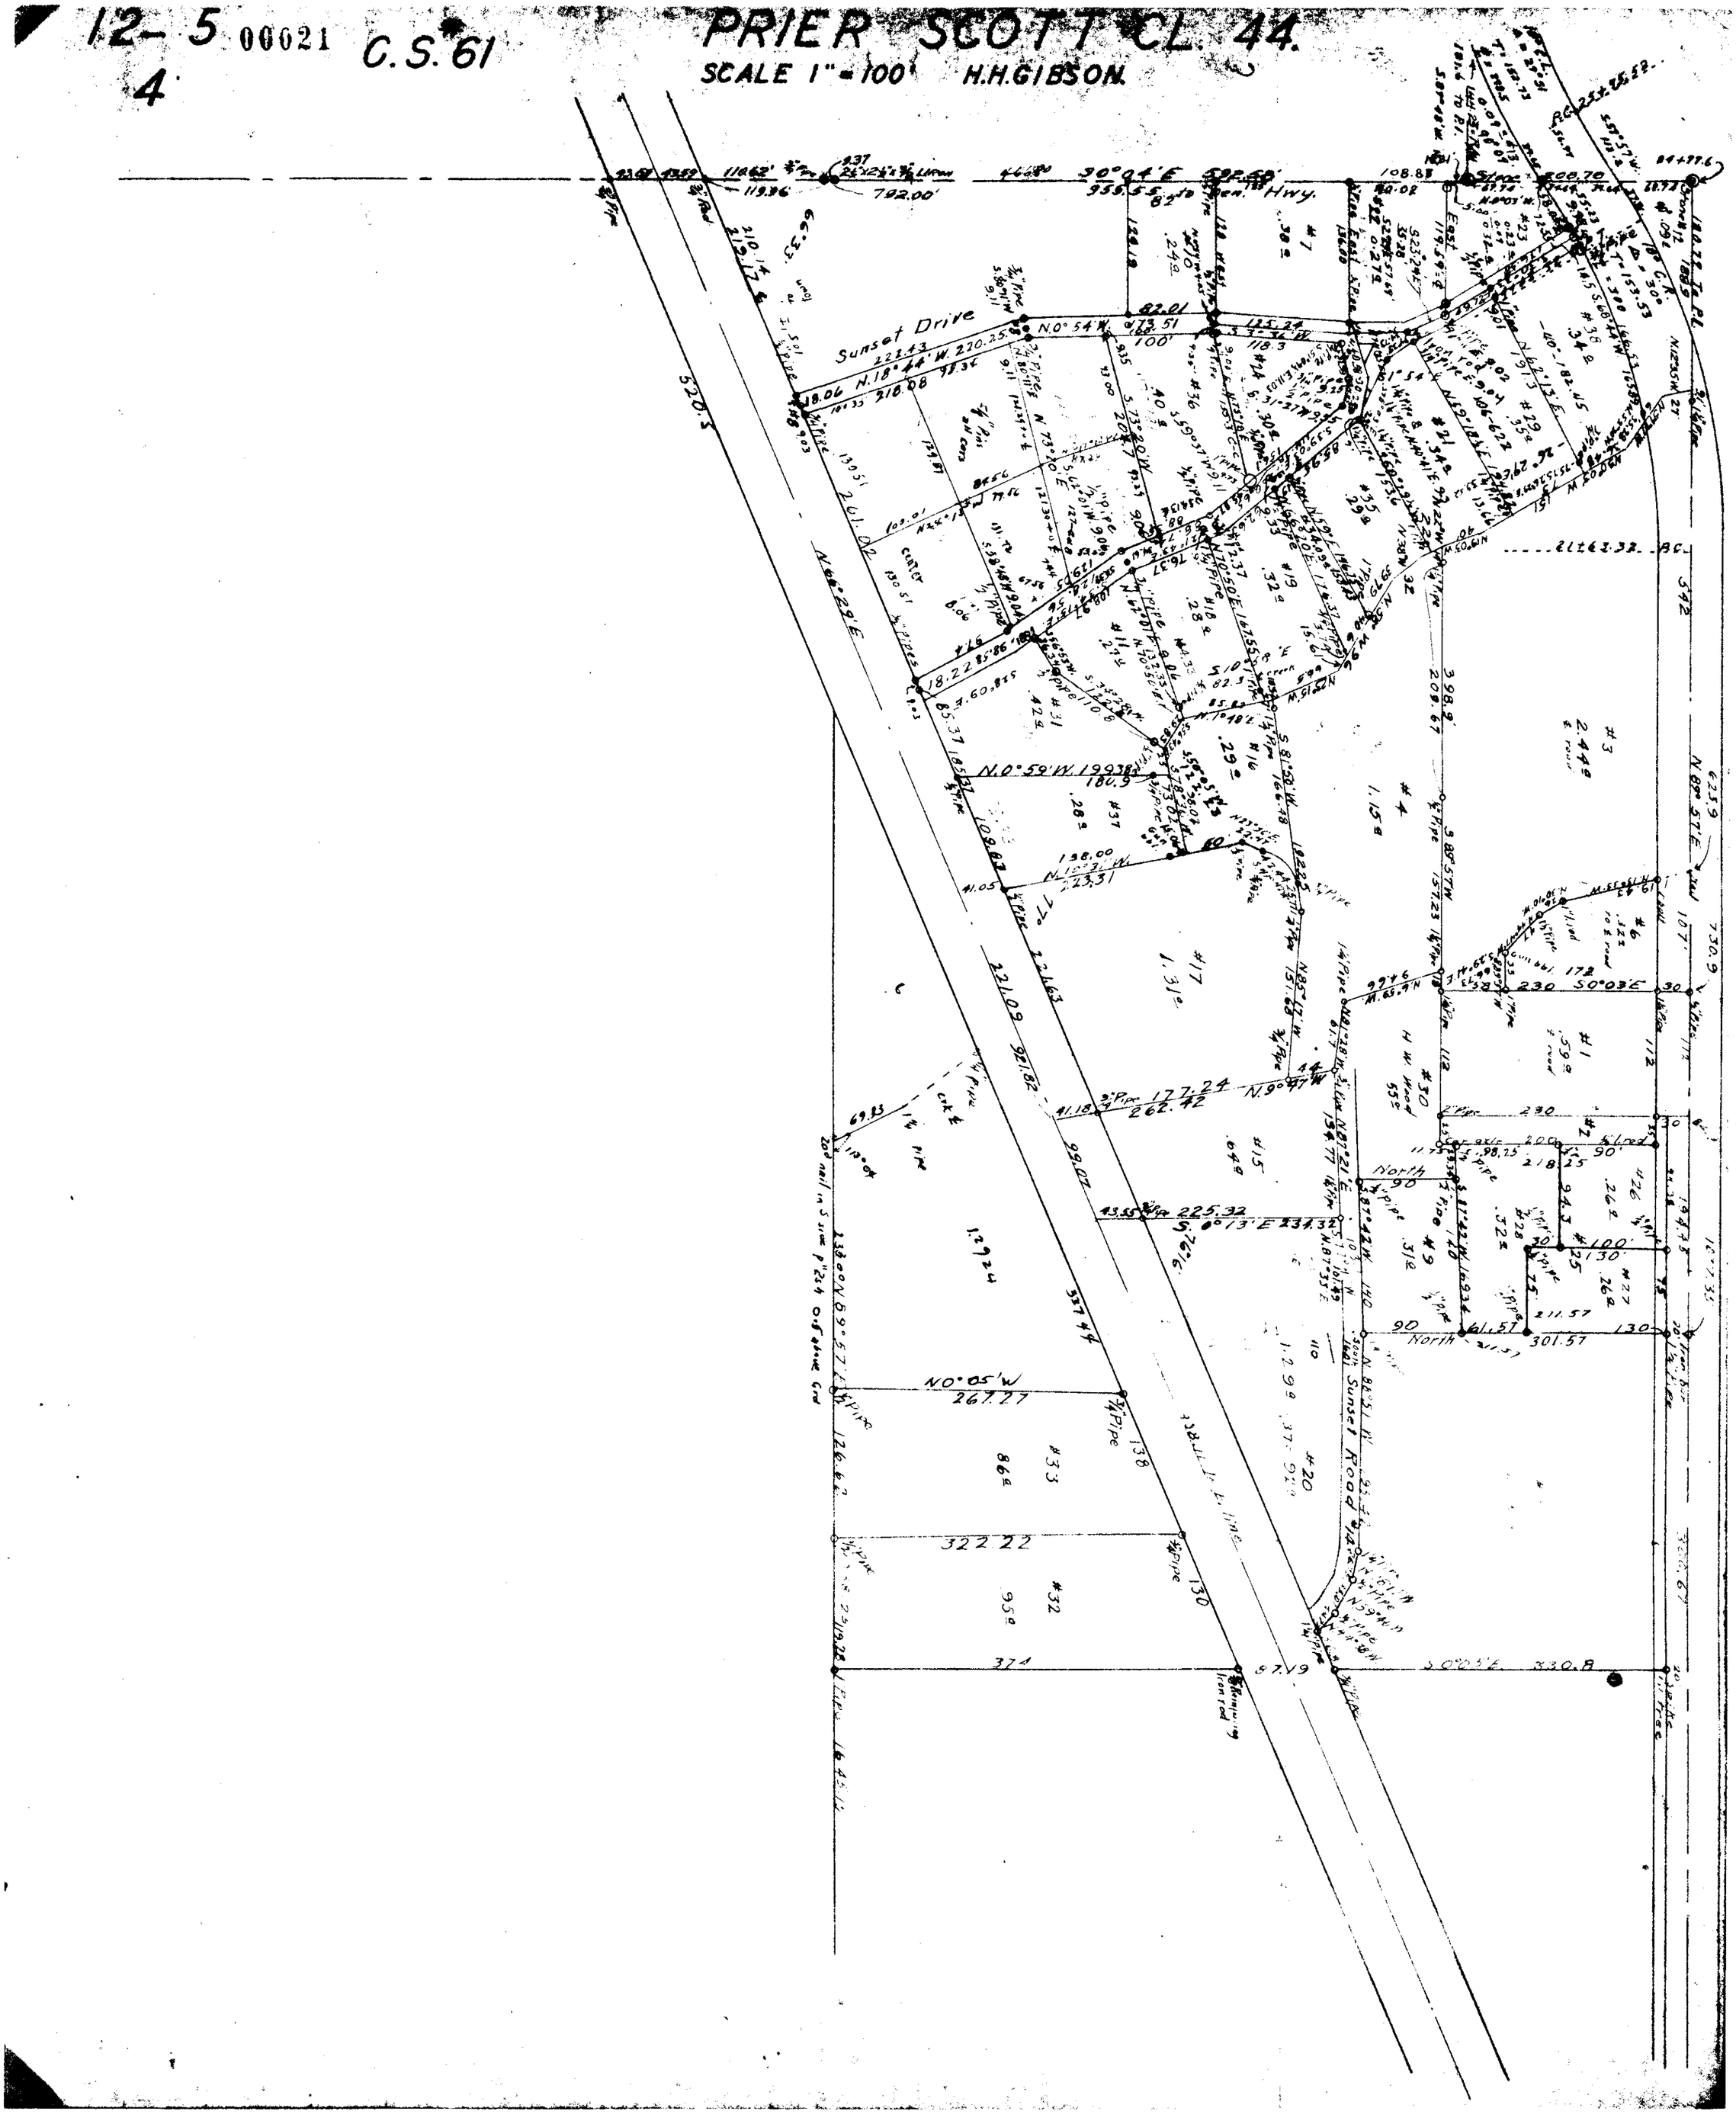
SCALE 1" = 100' H.H. GIBSON.