


00026

Scatter

Geo. W. Bethers Cl. 49
Hiram Allen Cl. 55

109

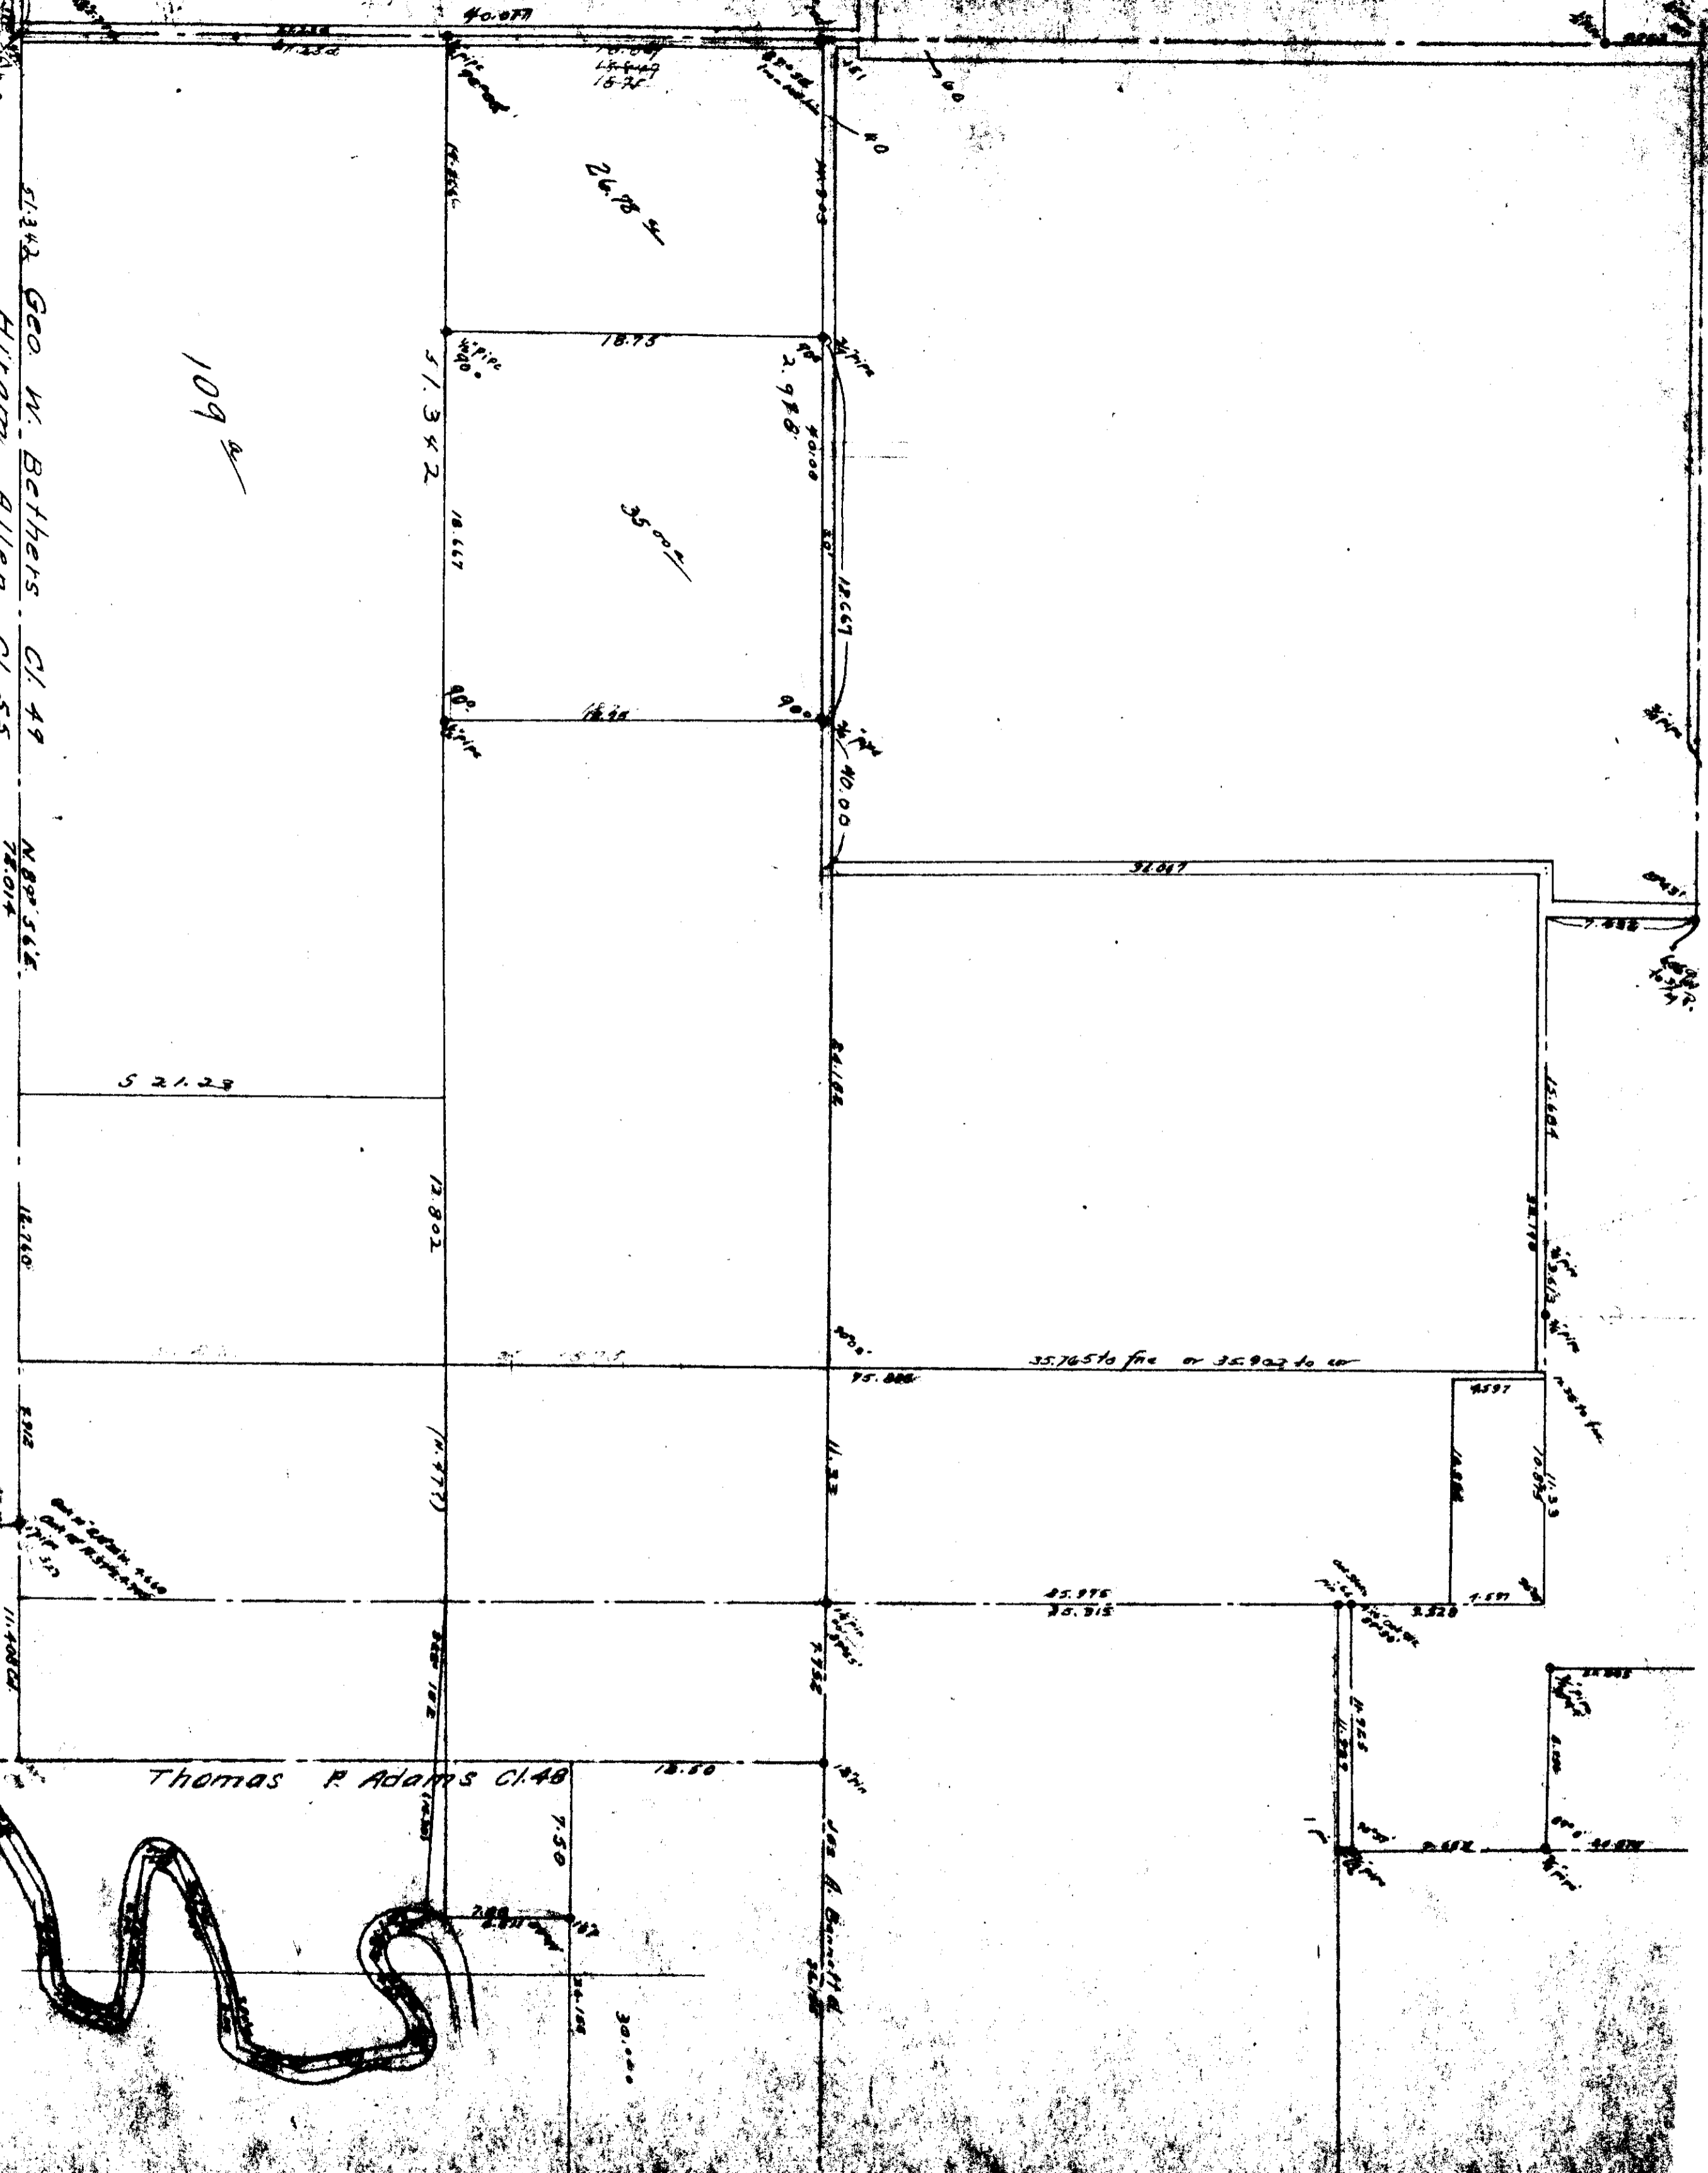

5 21.28

26.88

35.00

Thomas R Adams Cl. 48

7.50

