County Survey # 195 For. N. Lilly Heirs

Jos. C. Alexander Cl. # 46 T. 12 S. R. 5 W. Will. Mer.

Scale 1" = 5 chs.

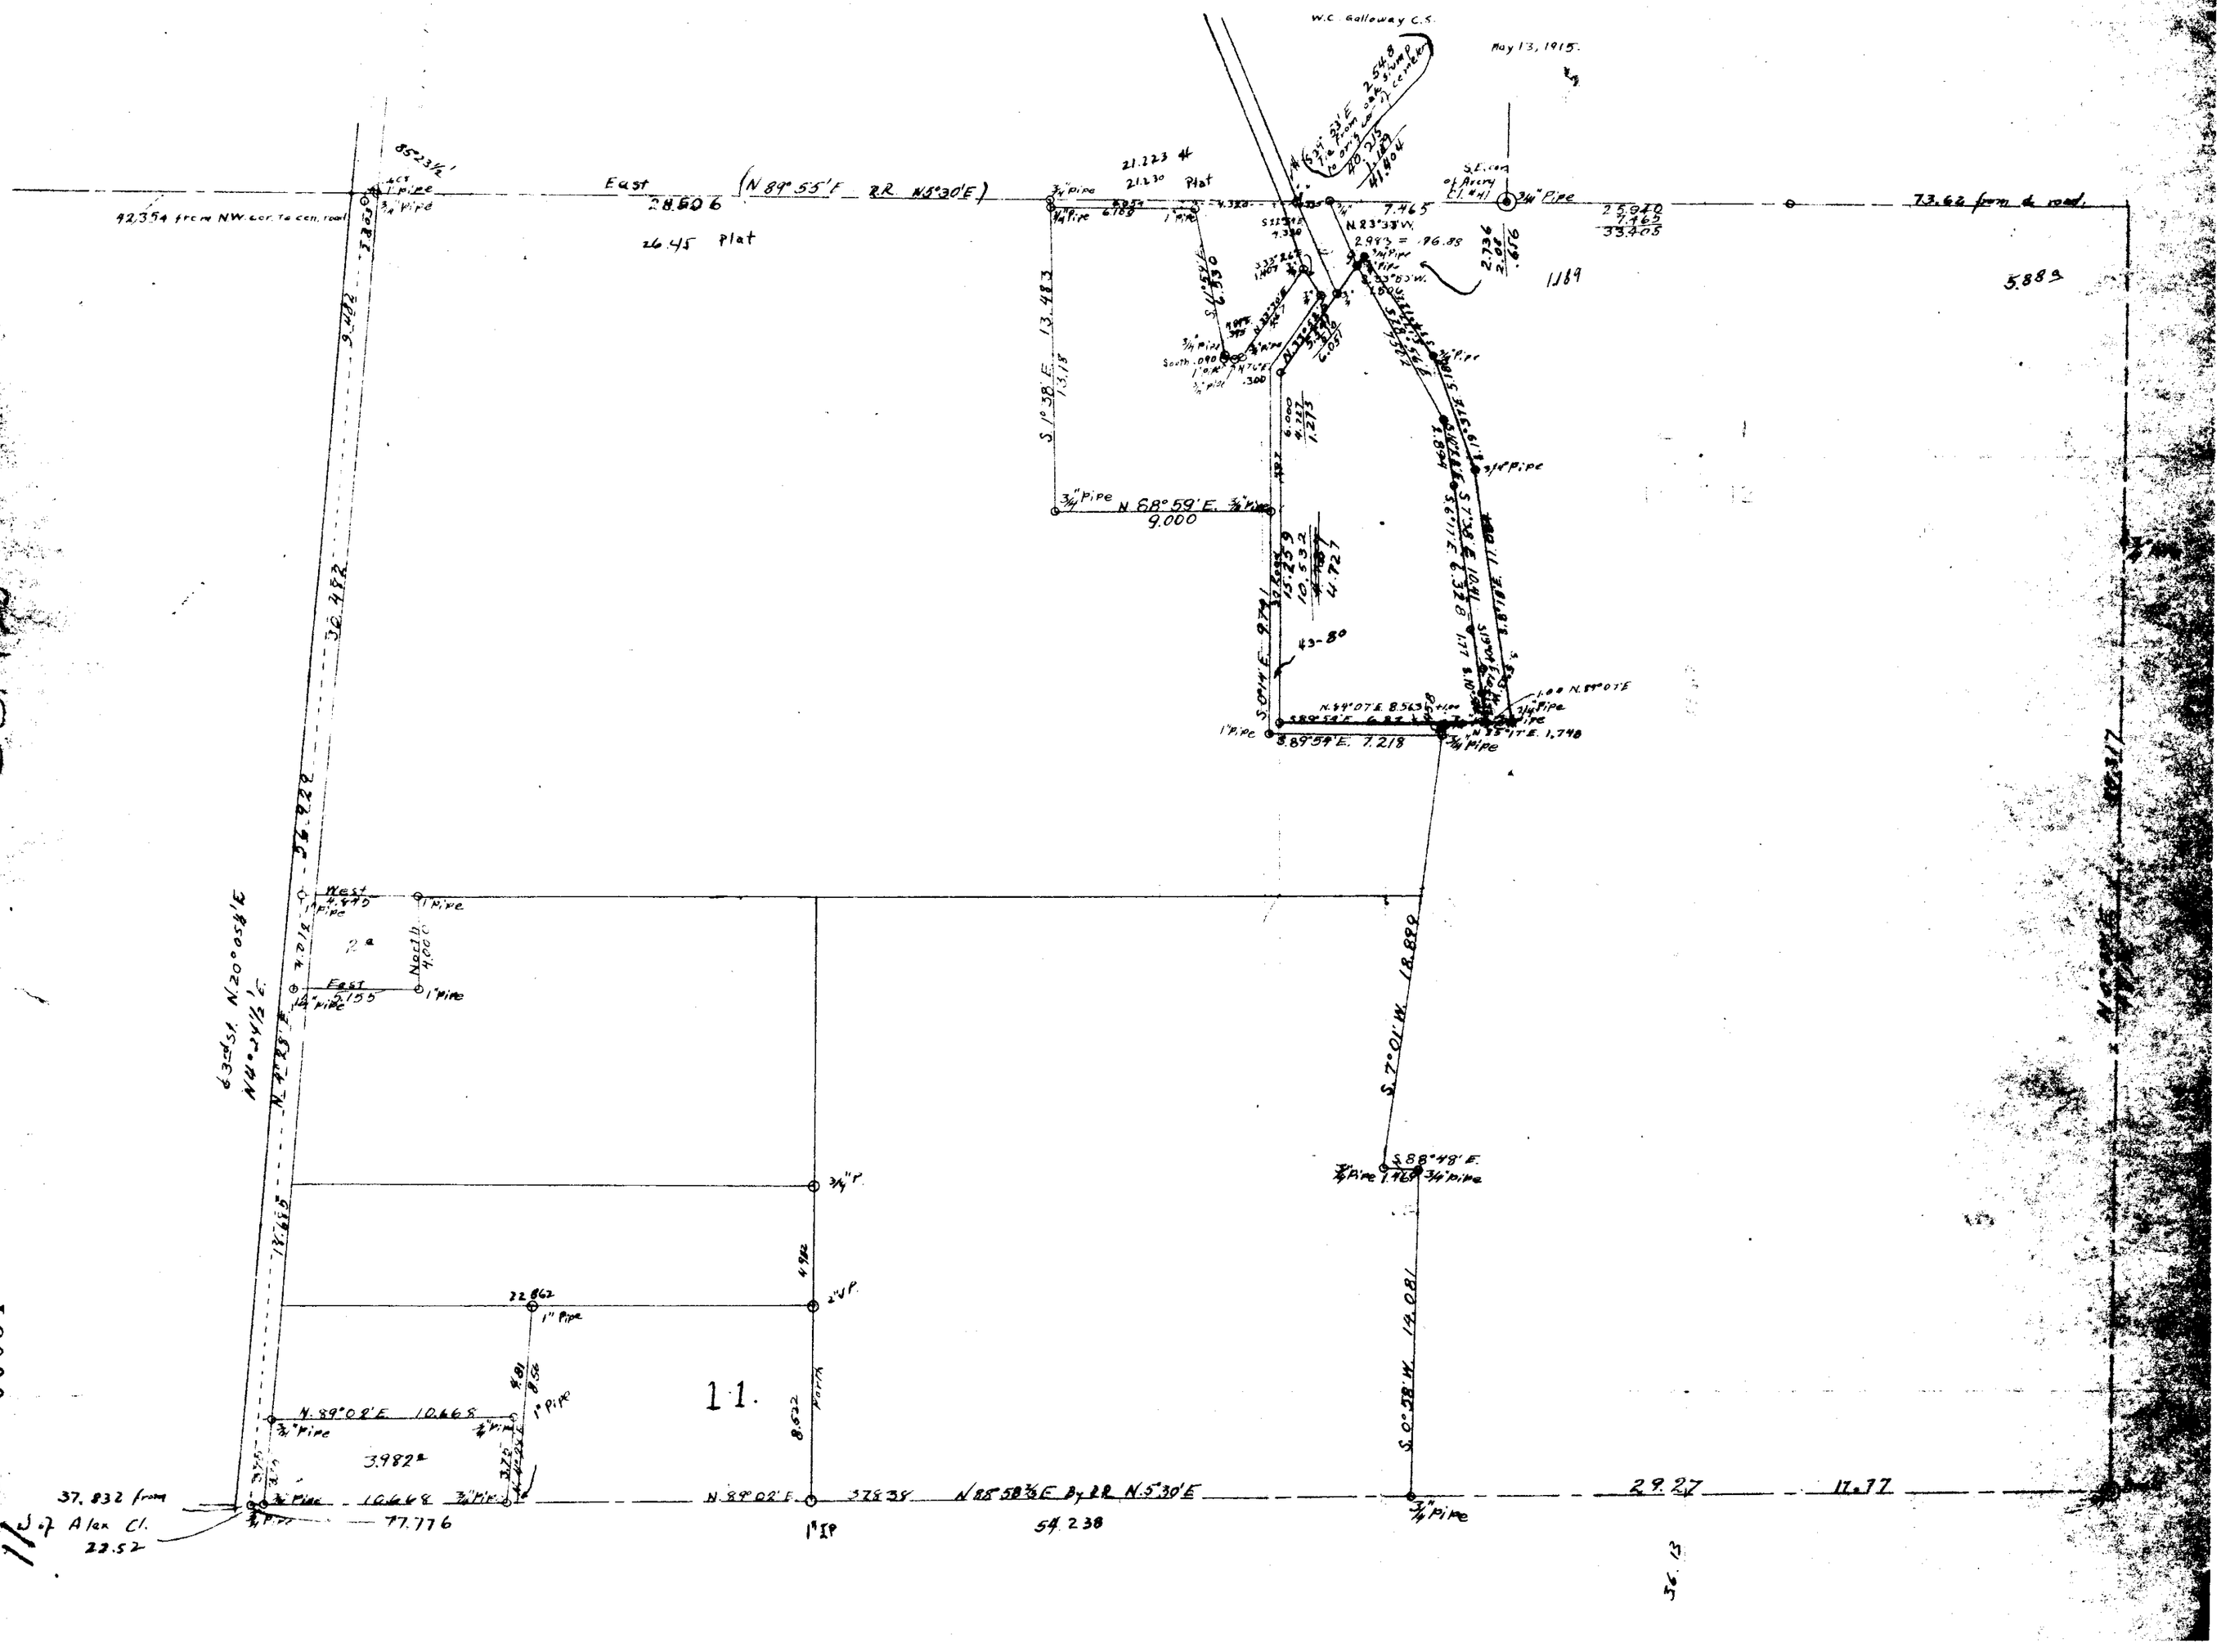

12-5 00034