12-5 00035

14

COUNTY SURVEY #303
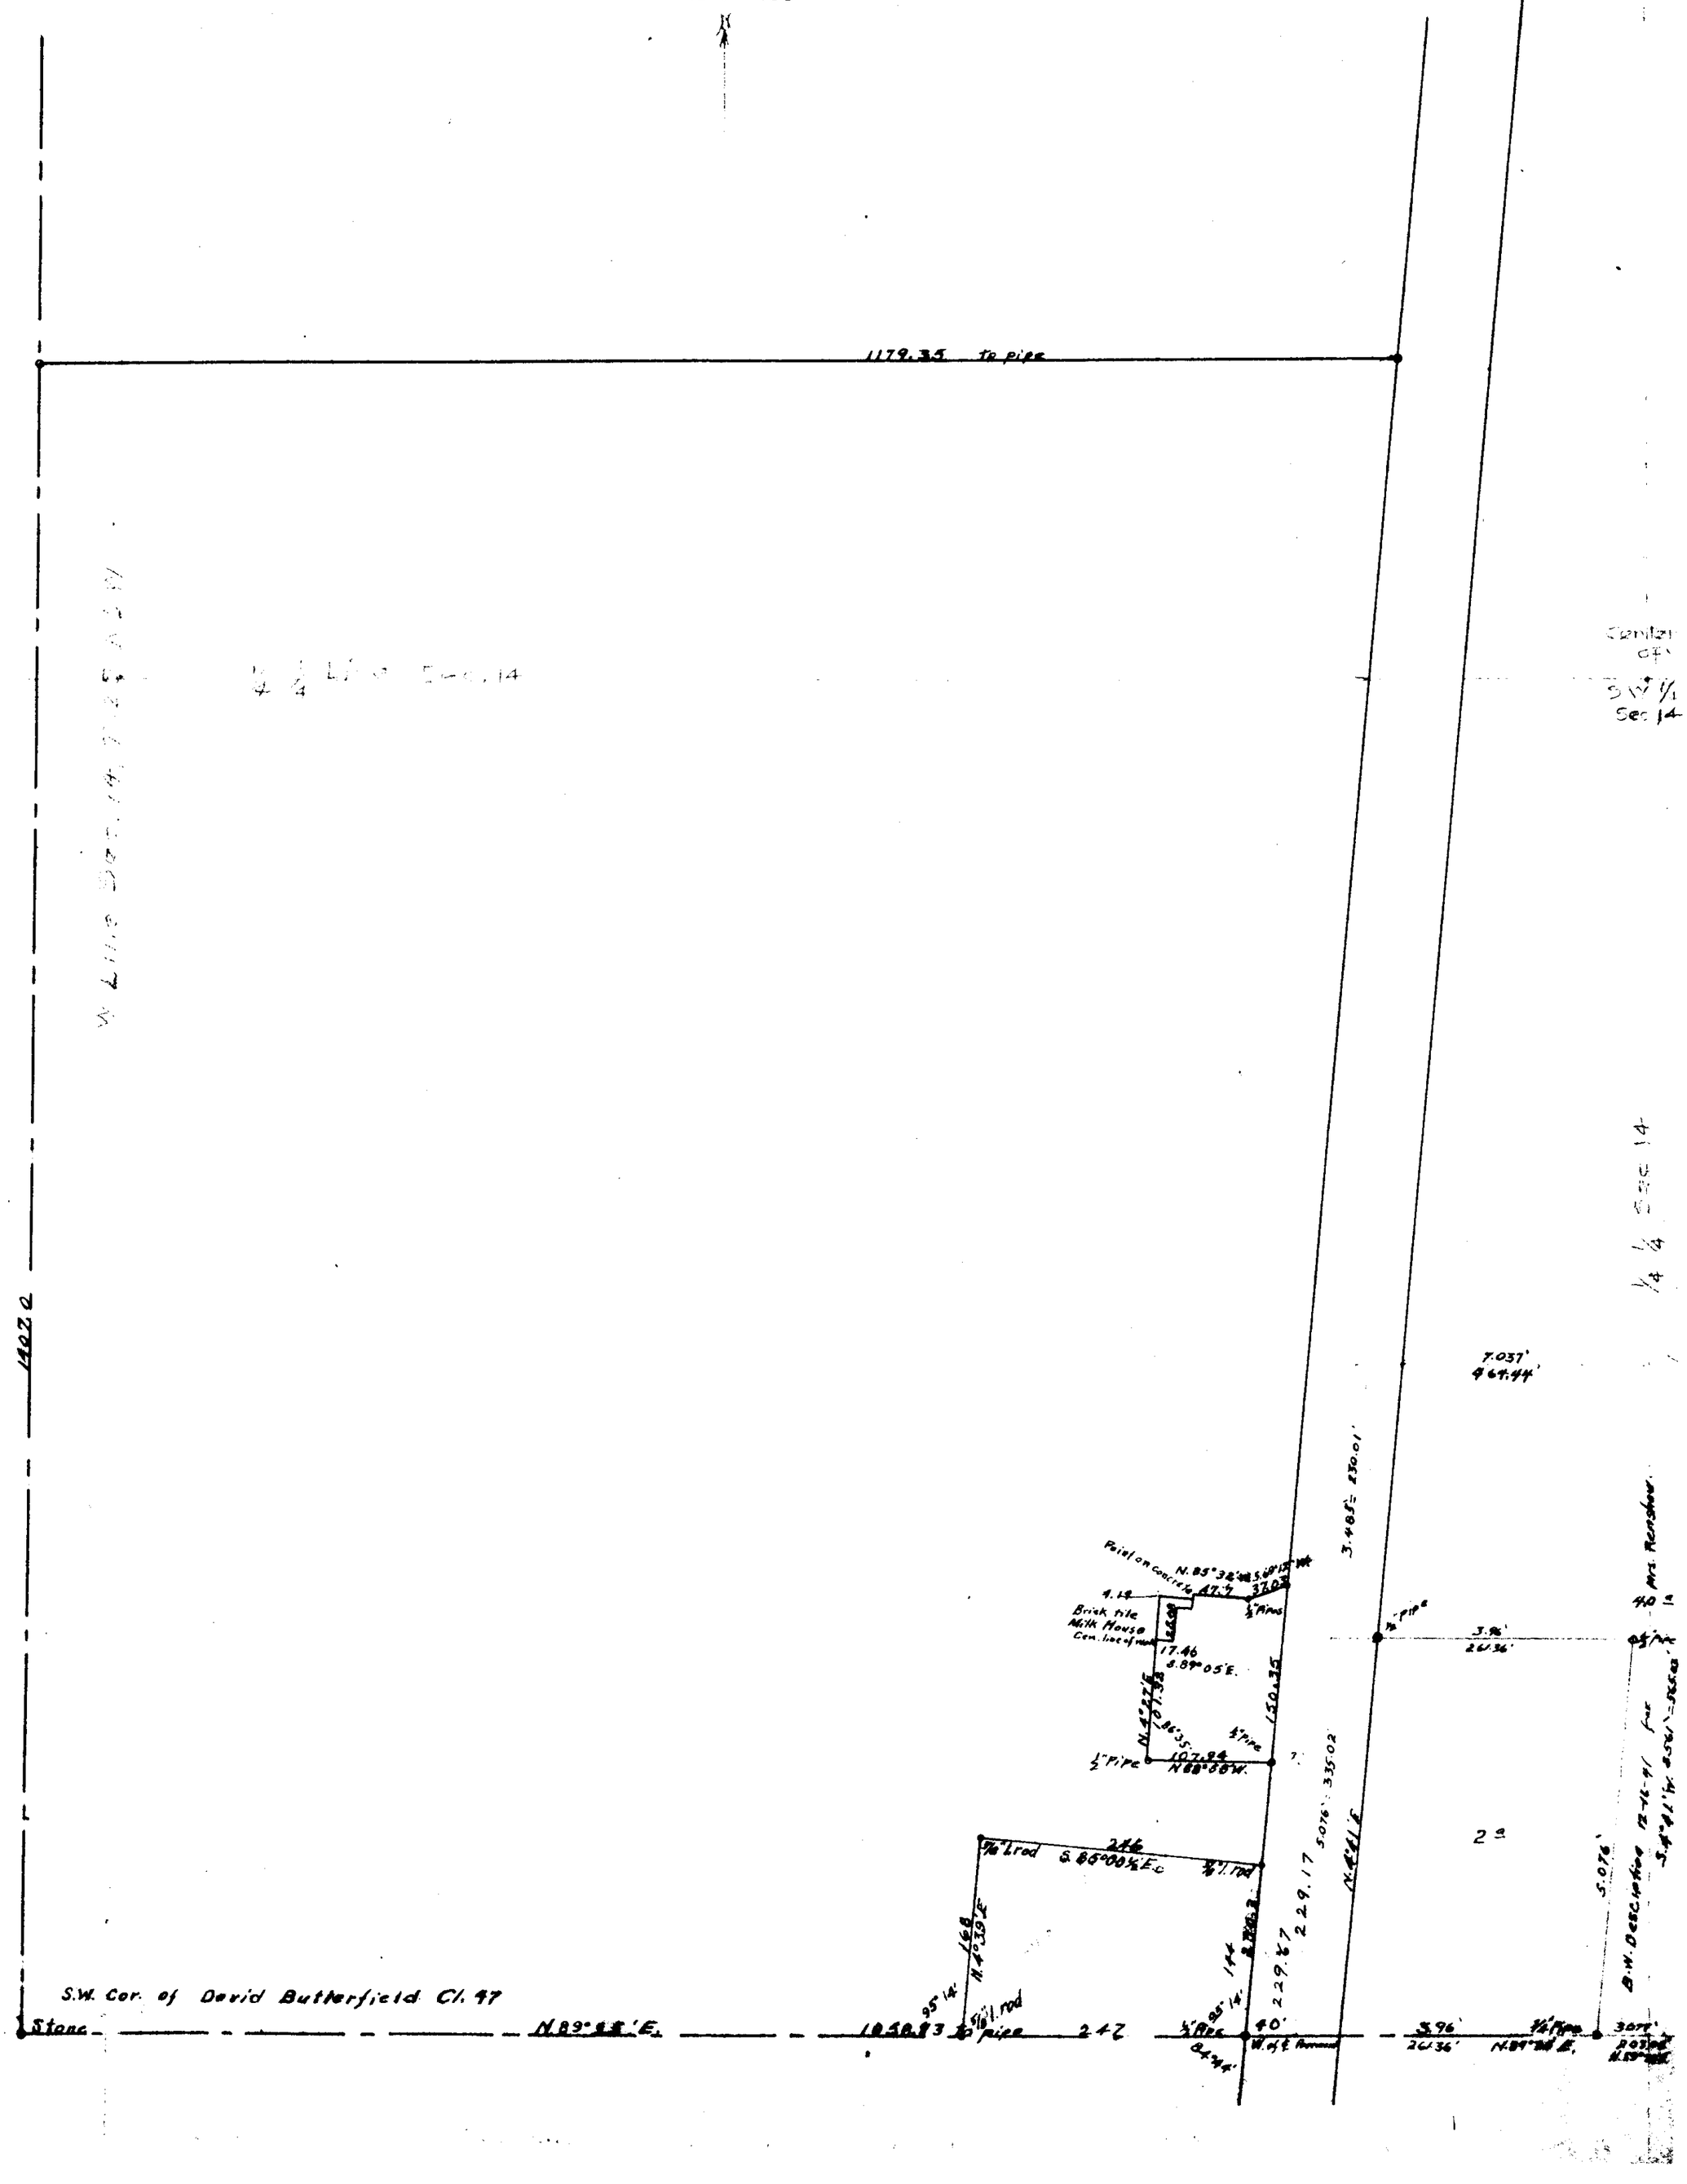
SCALE 1" = 100'