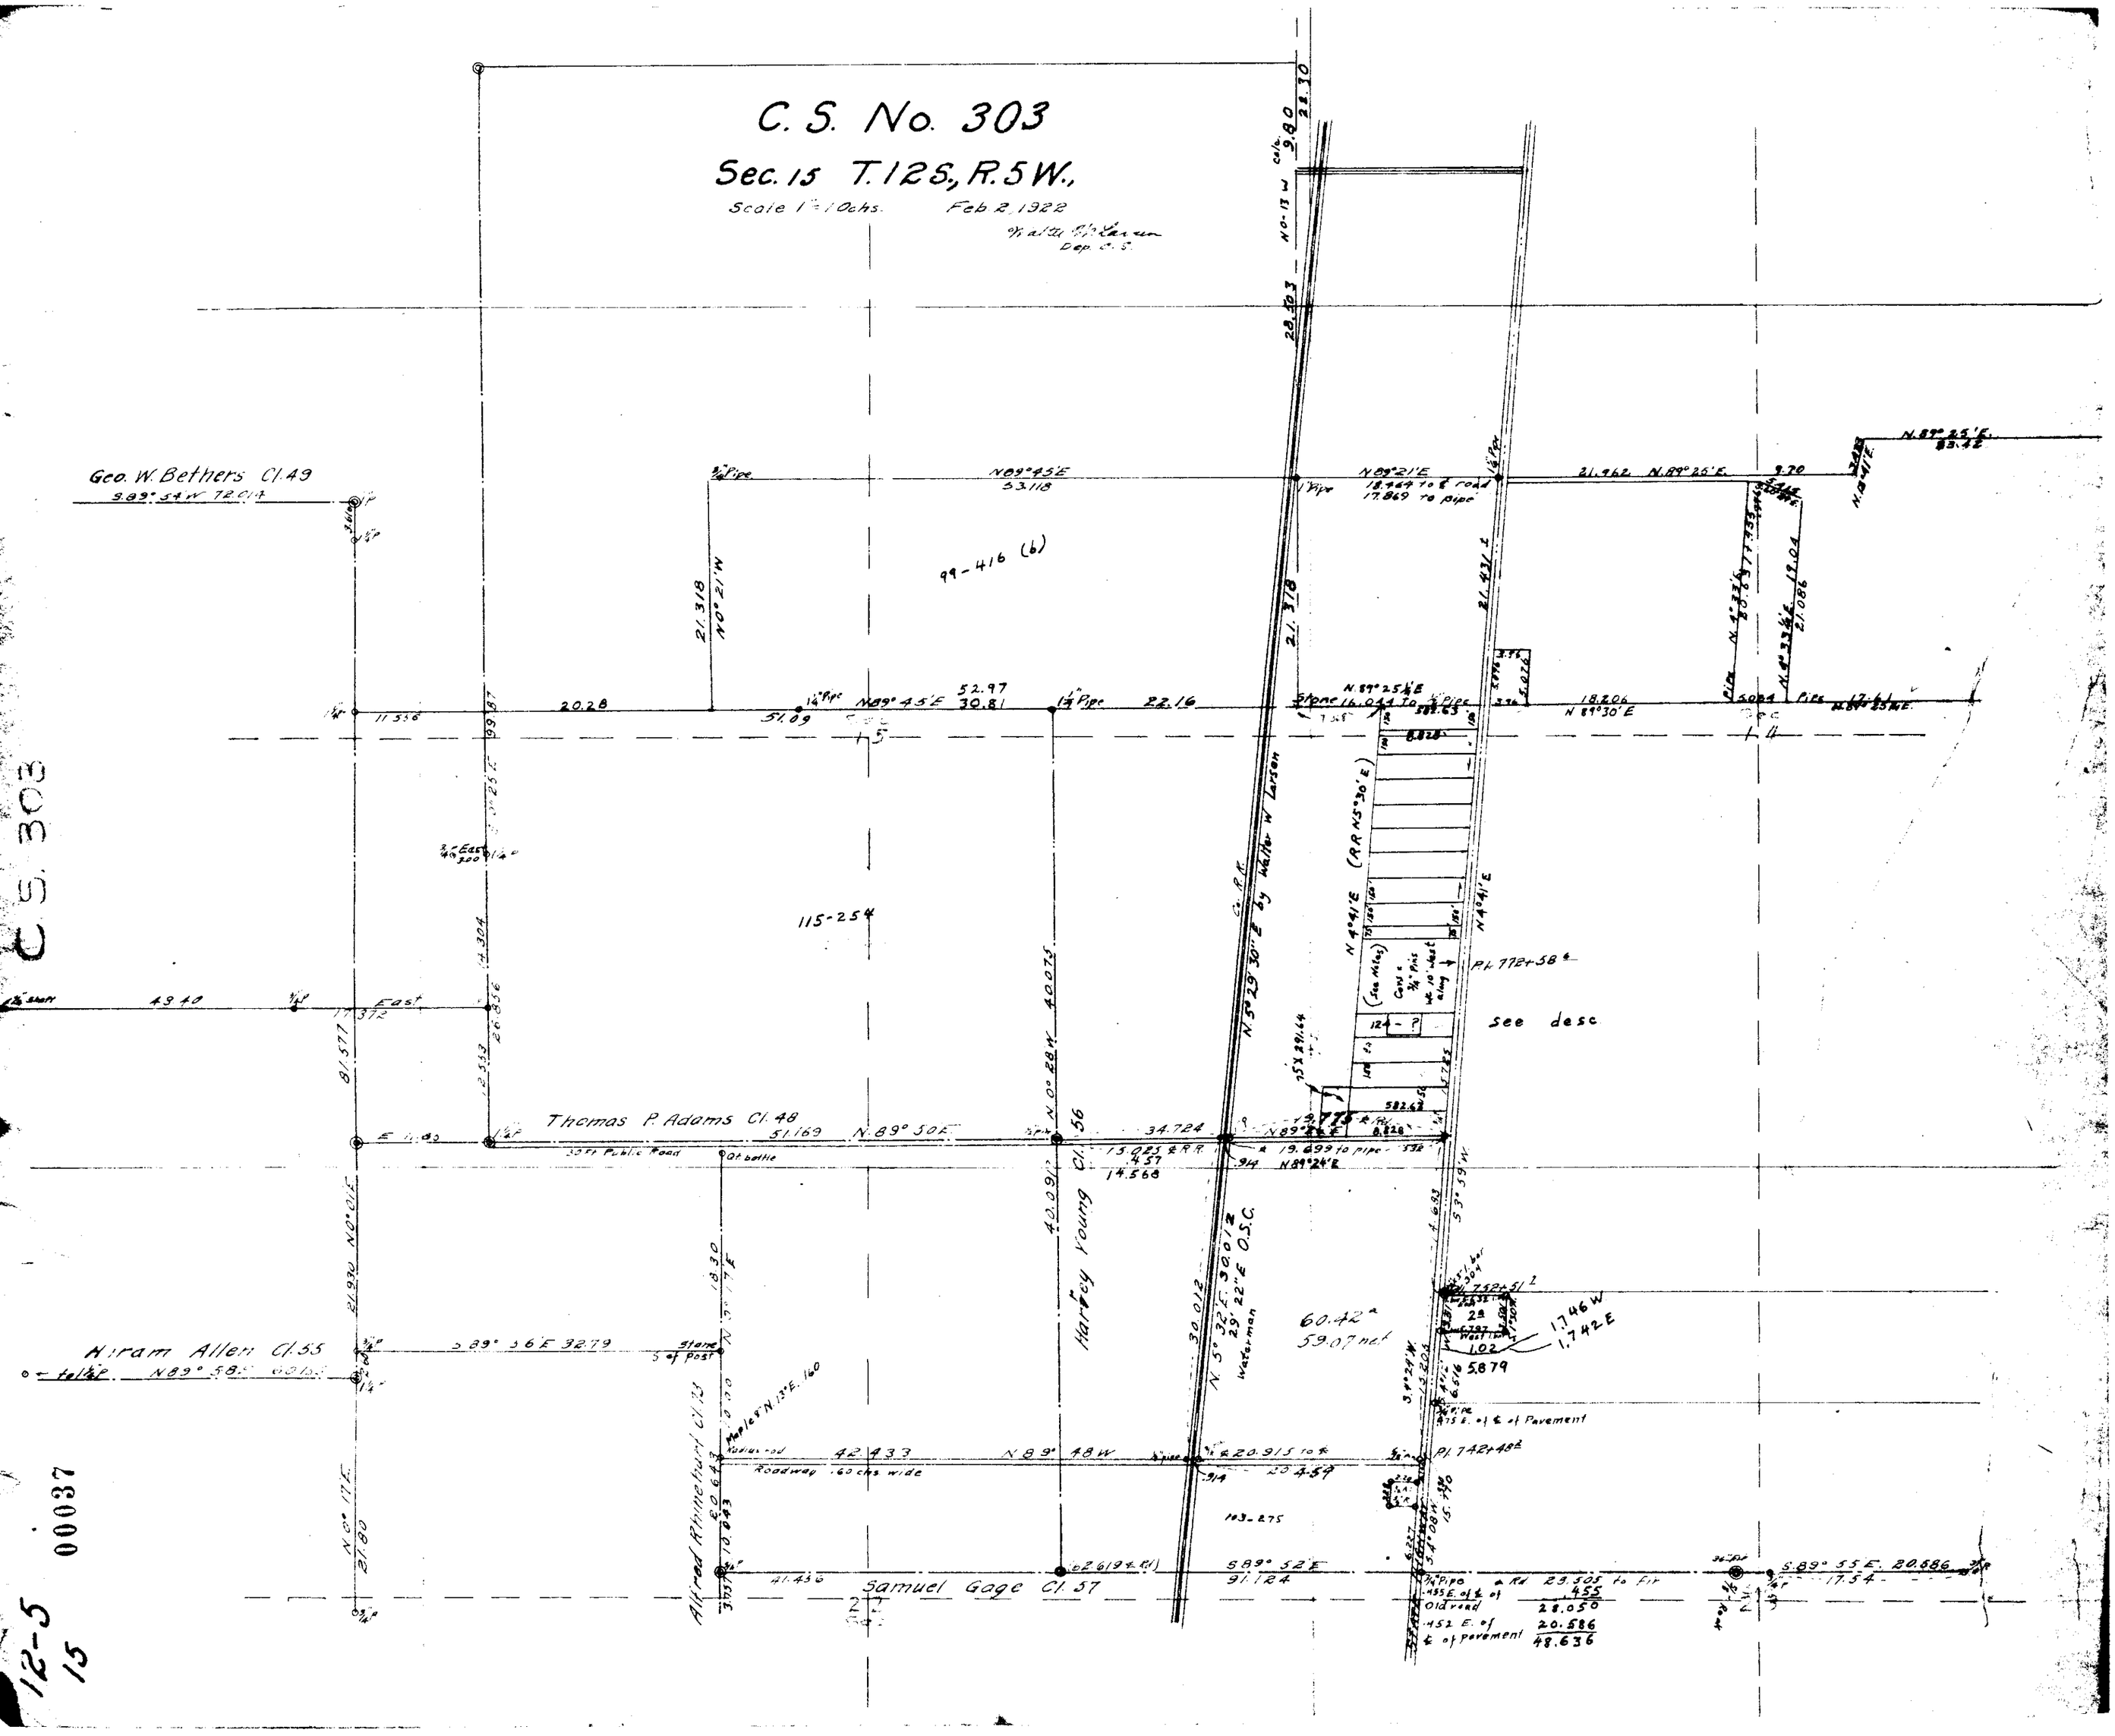

C. S. 303

12-5
15

00037