12-5
31-32 00046
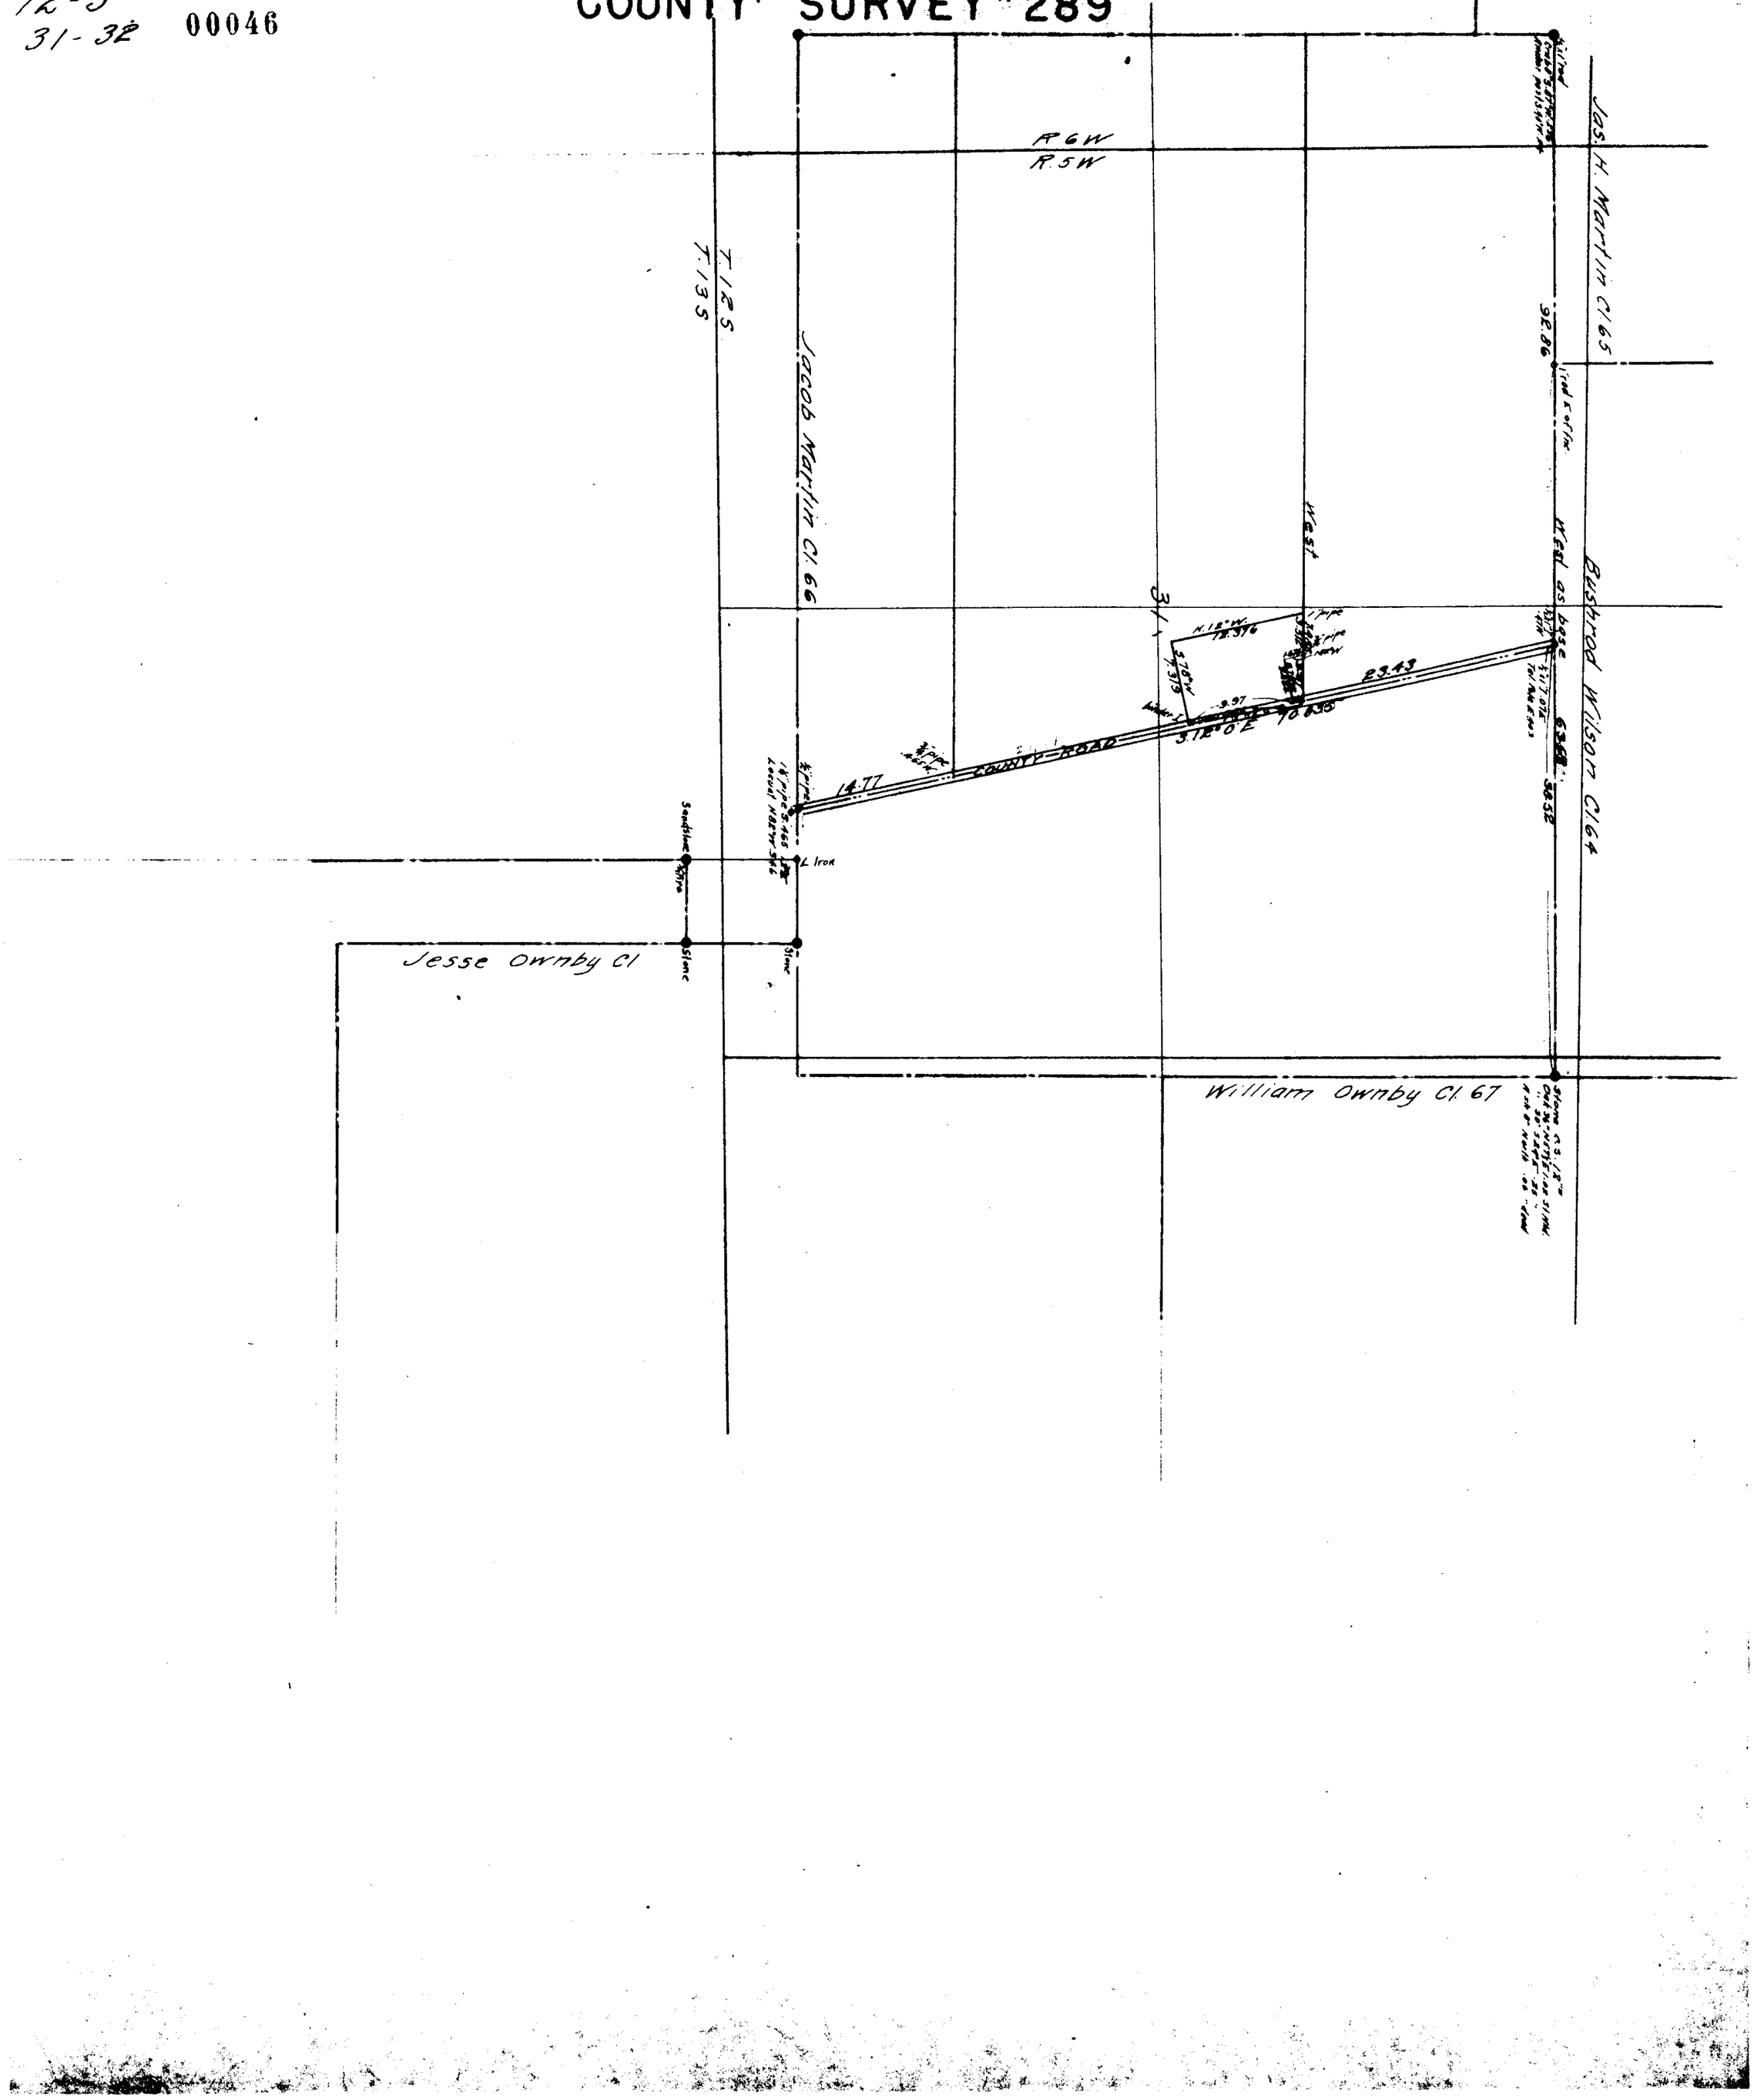
COUNTY SURVEY #289