

12-5-00051

506

C.S.#186


506

Dick Kiger

Sec. 24 T. 12 S. R. 5 W.

Scale 1" = 5 chs.

W.C. Galloway VCS.

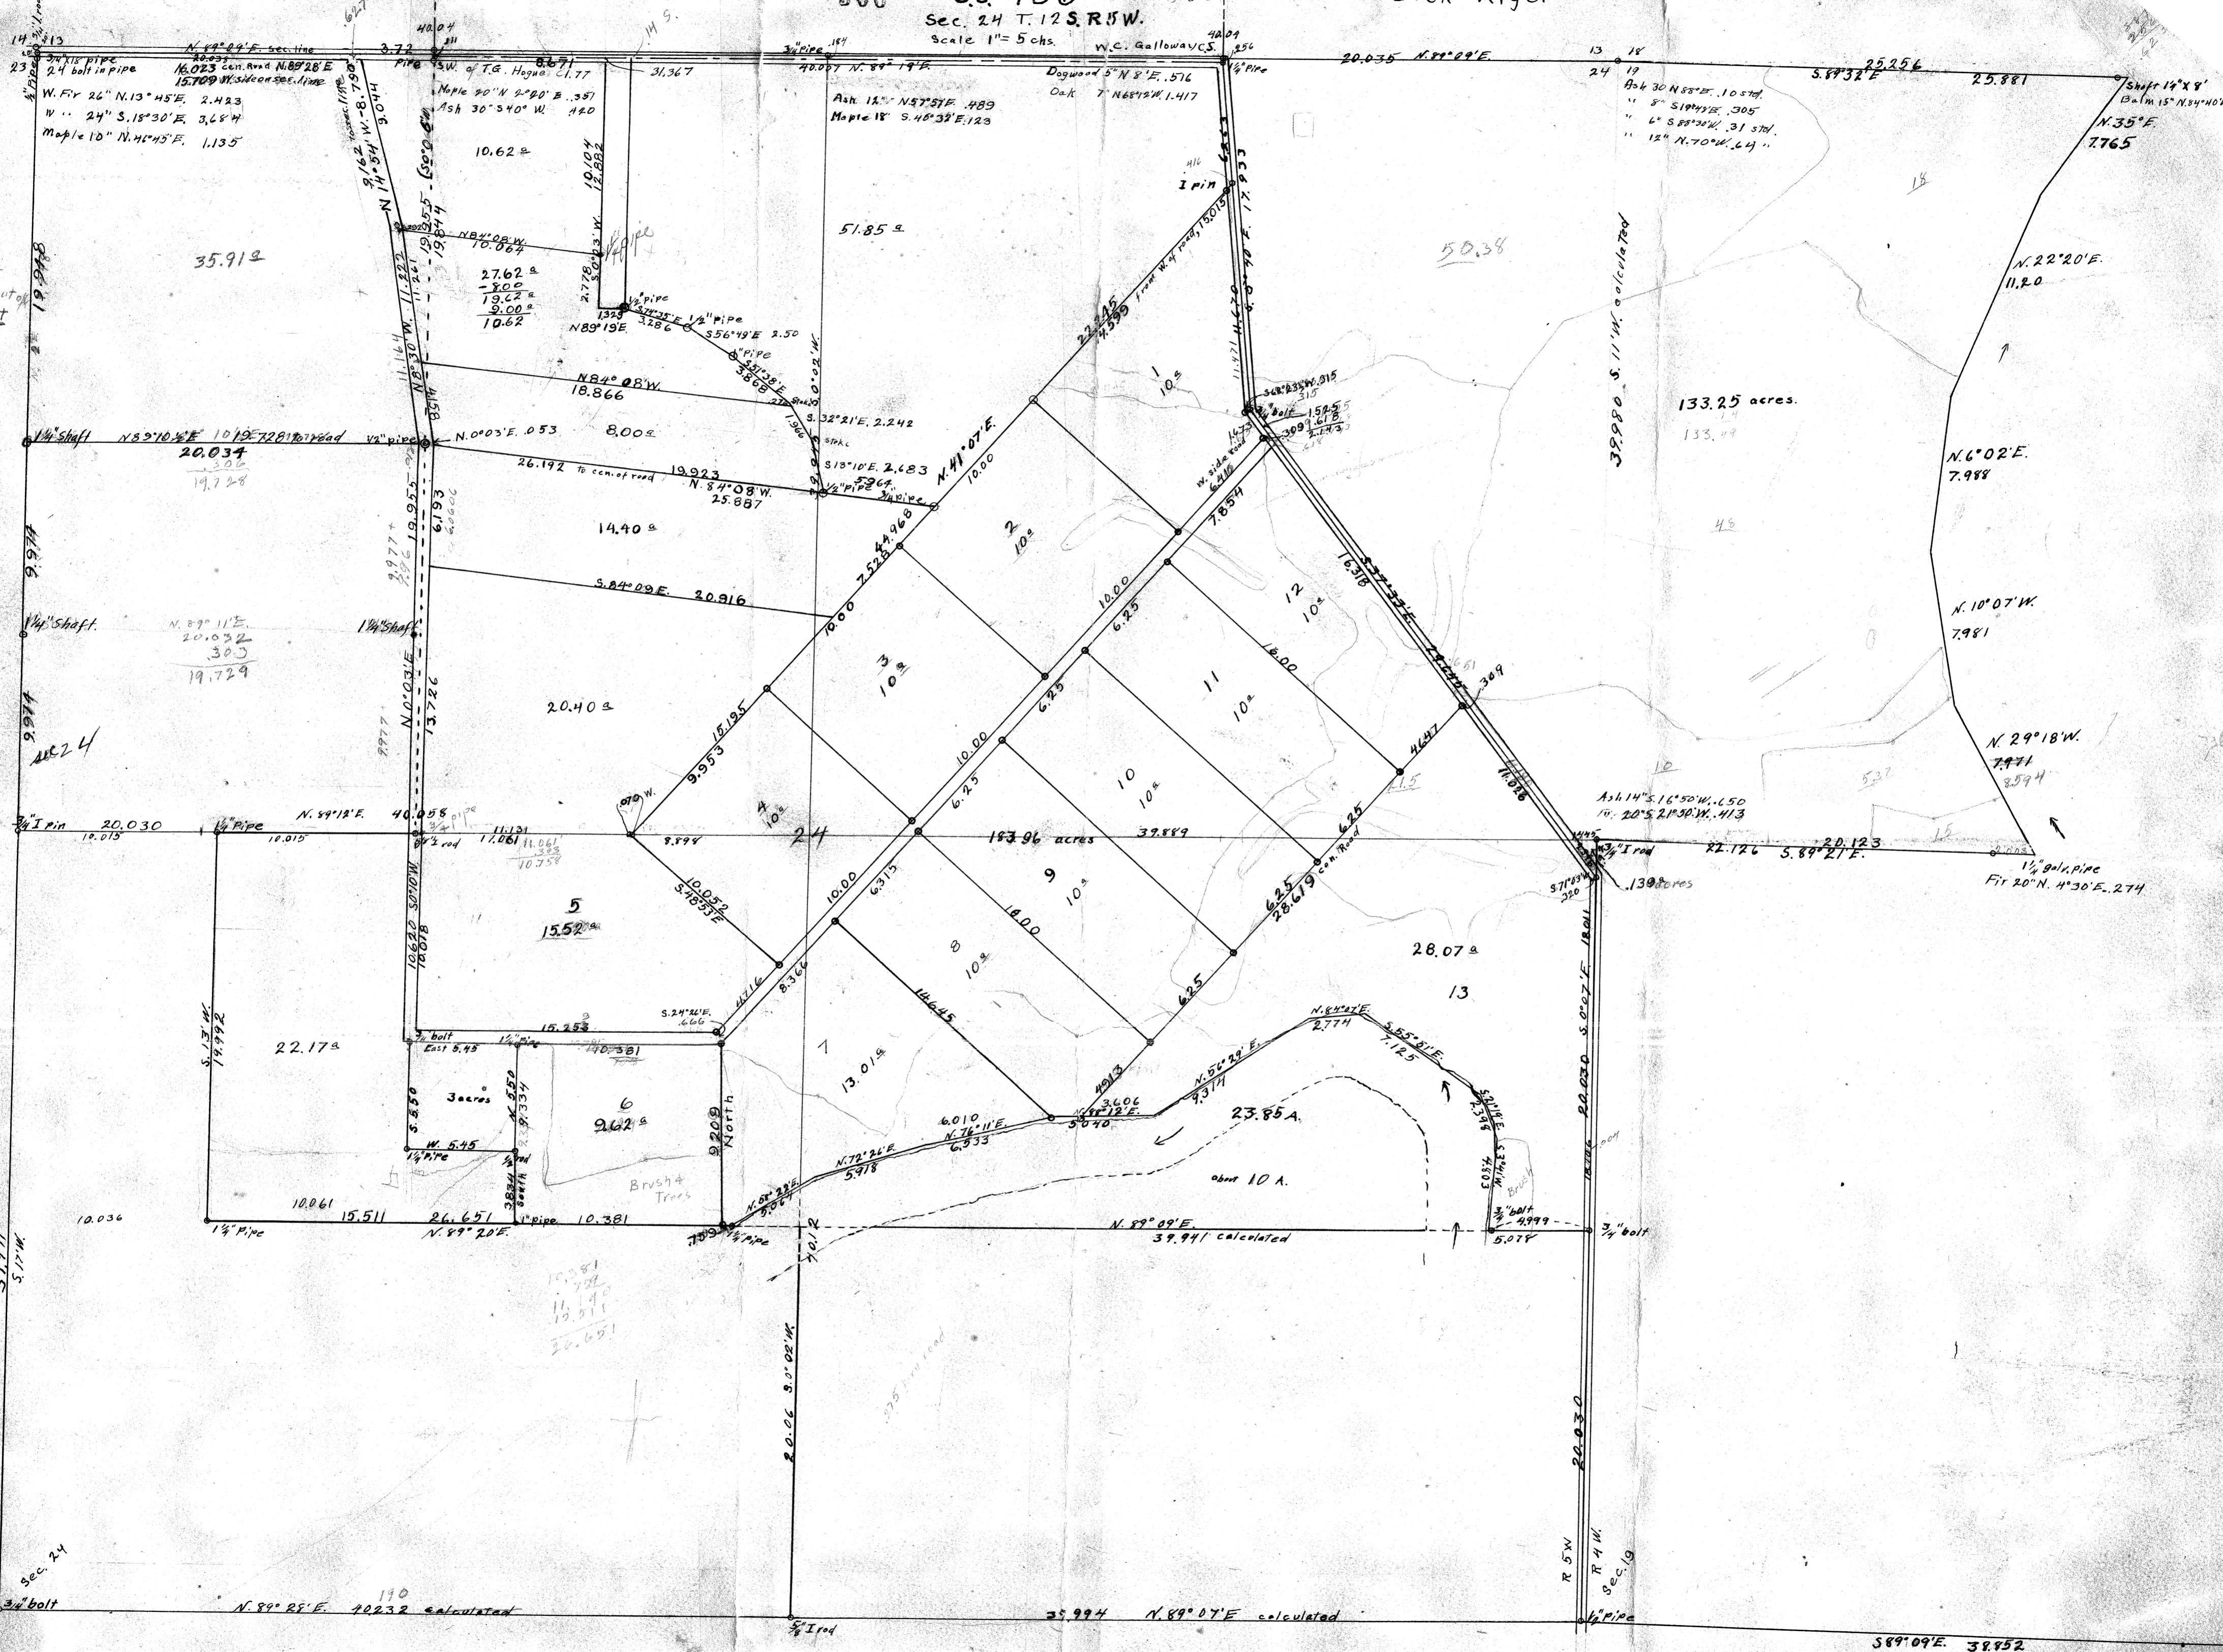

Lot 1
44.892
- 1.81^a cut off
43.082 ±

Lot 2
31.012

sec. 23

12-4-19
12-5-24

3600
120
3600
3600
3600

589°09'E. 38.952