00002

12-6

2

COUNTY SURVEY

SCALE 1" = 2 CHAINS
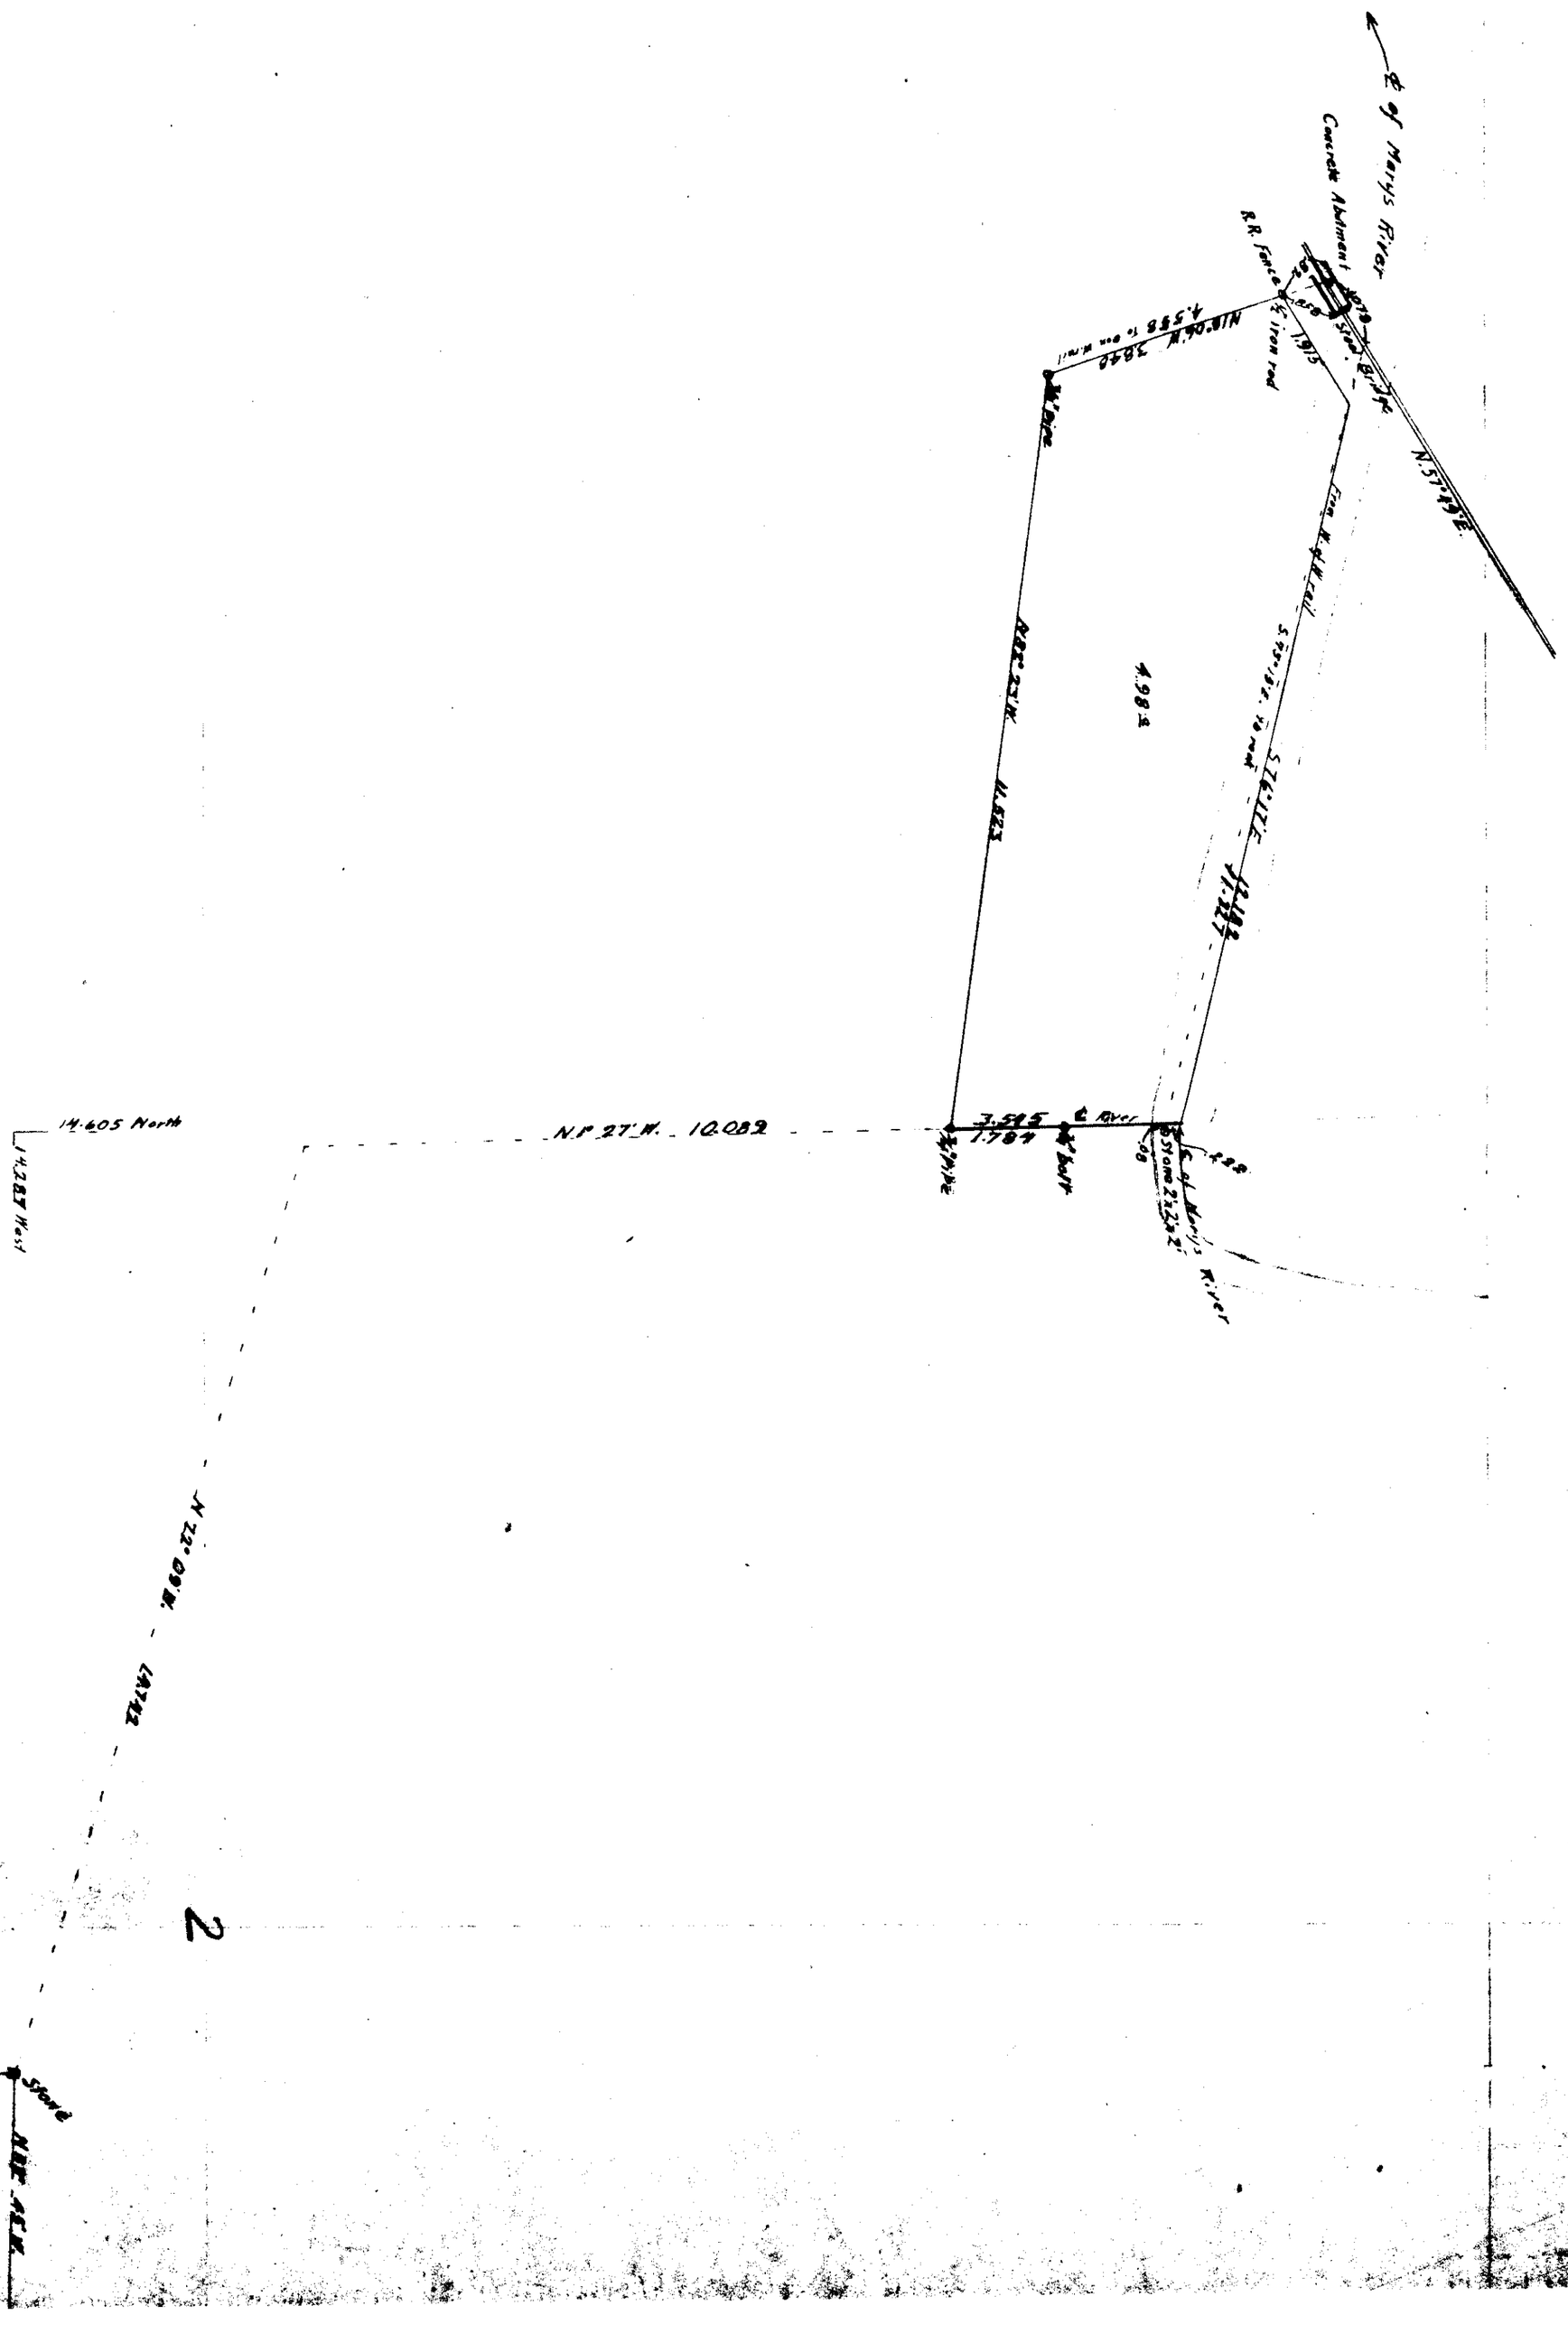
For Miss Gibson 1930