COUNTY SURVEY Nº 197

T. 12 S. R. 6 W. W. M.

For J. B. Arrants

Jan. 20. 1915.

Scale 1" = 10 chs.
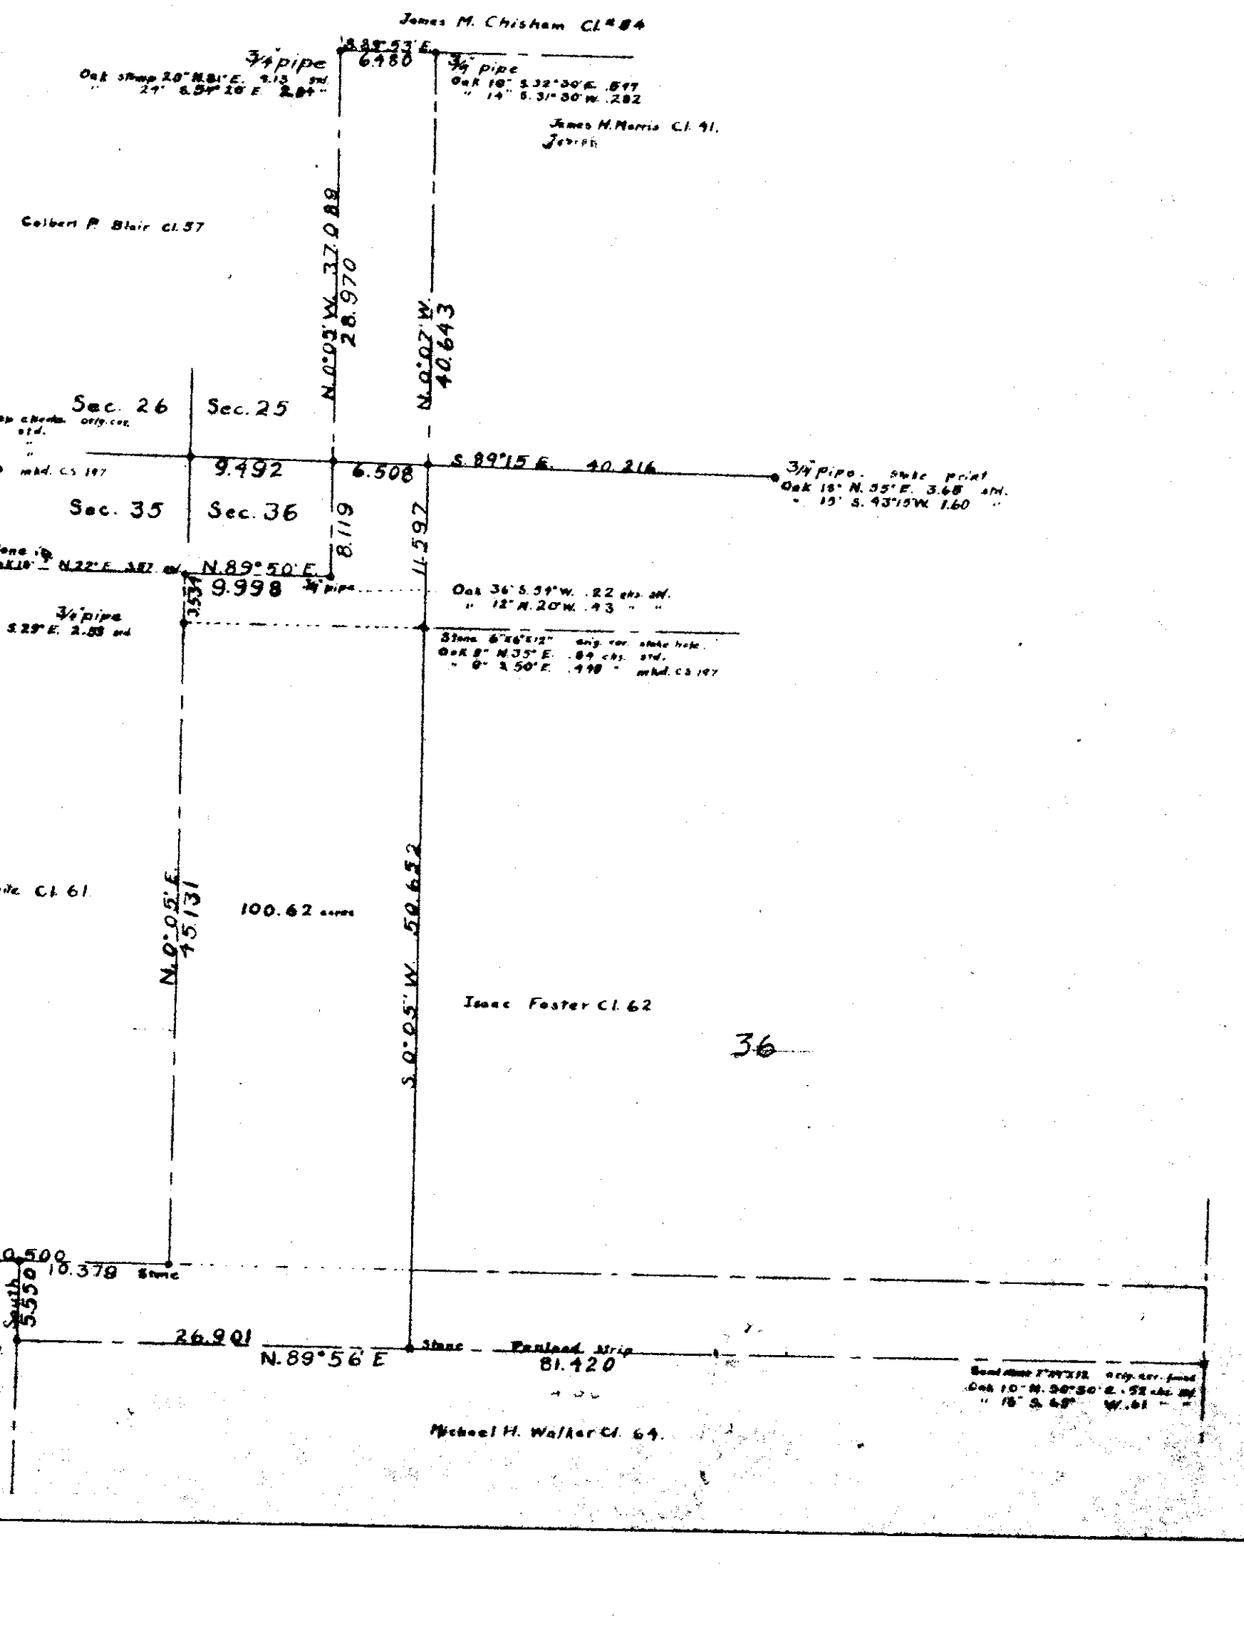
W. C. Galloway C.S.