12-6-00037

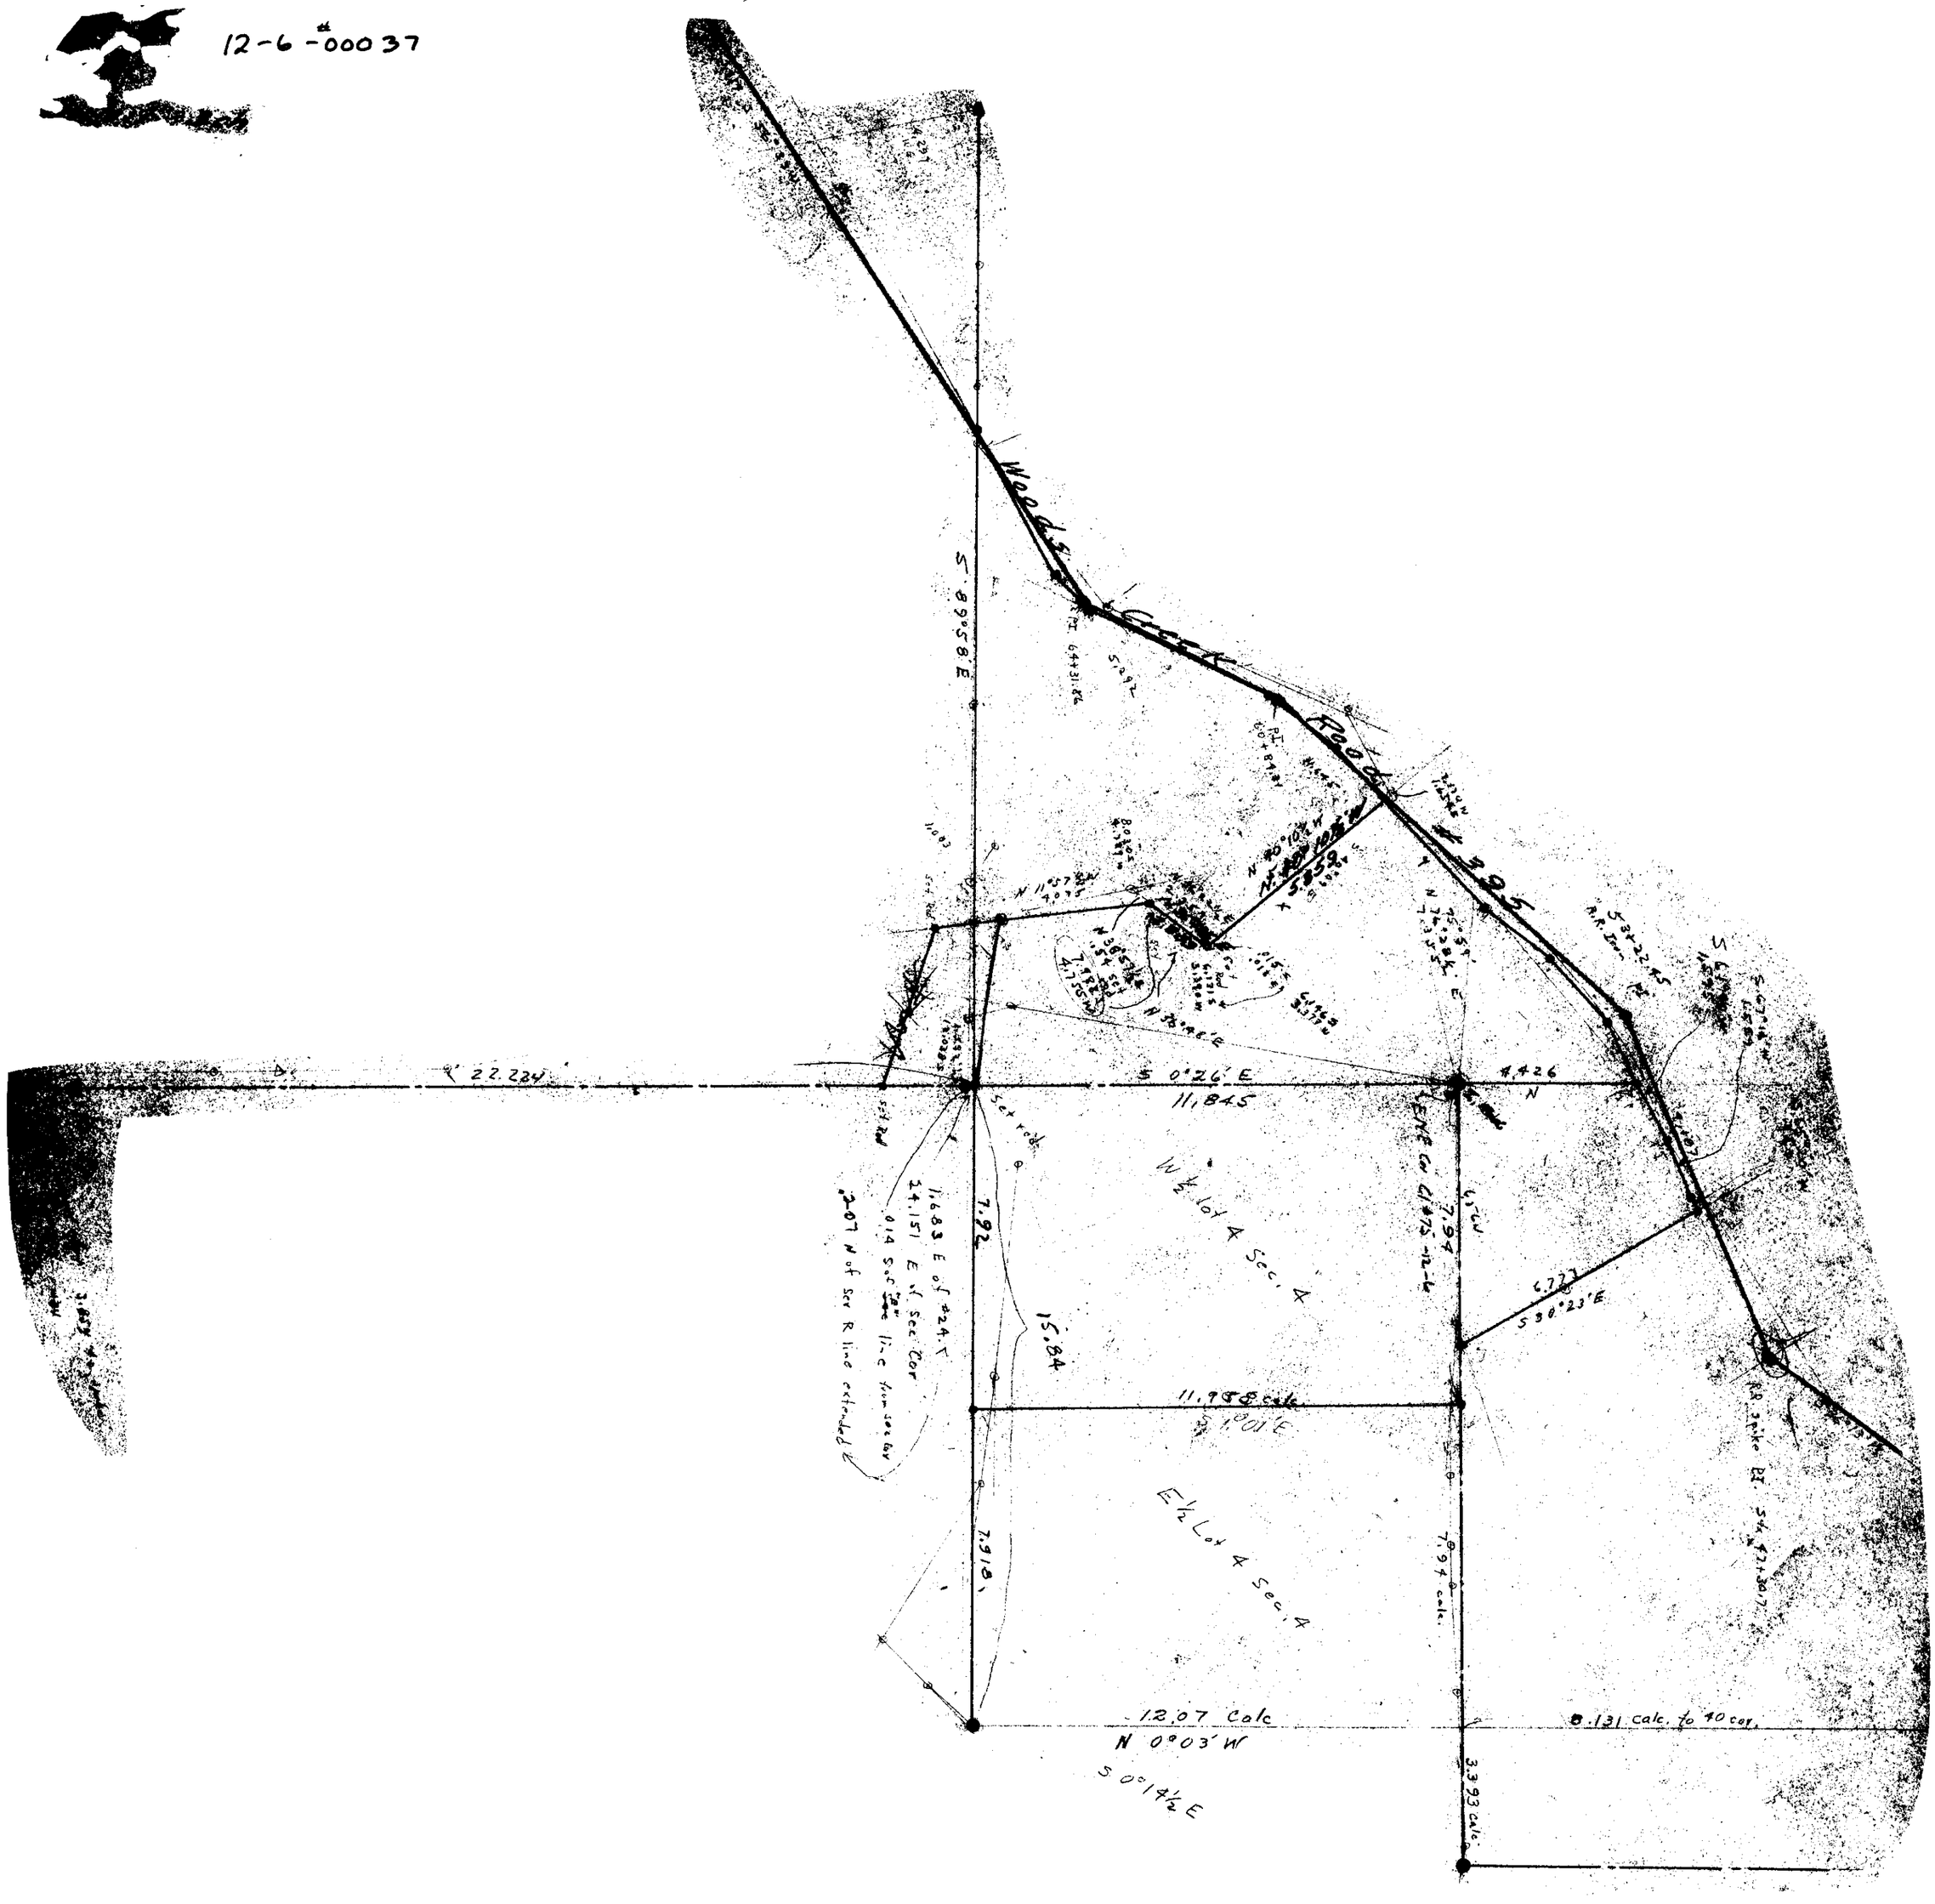
Road
S 89°58' E
S 0°26' E
111,845
22.224'
7.92
15.84
11,988 calc.
S 1°00' E
7.918
12.07 Calc
N 0°03' W
S 0°17½ E
0.131 calc. to 40 cor.
3.393 calc.
4.426
7.94
4.722
S 30°23' E
W½ Lot 4 Sec. 4
E½ Lot 4 Sec. 4
Fence on Cl #75-12-6
Sec Rd
Sec rock
R.R. Spike
Sta 42+31.82
Sta 60+81.81
Sta 64+12.82
Sta 54+30.77
5.297
