12-7 00007
13 & 14

County Survey 357

Secs. 13 & 14 T. 12 S. R. 7 W N.M.
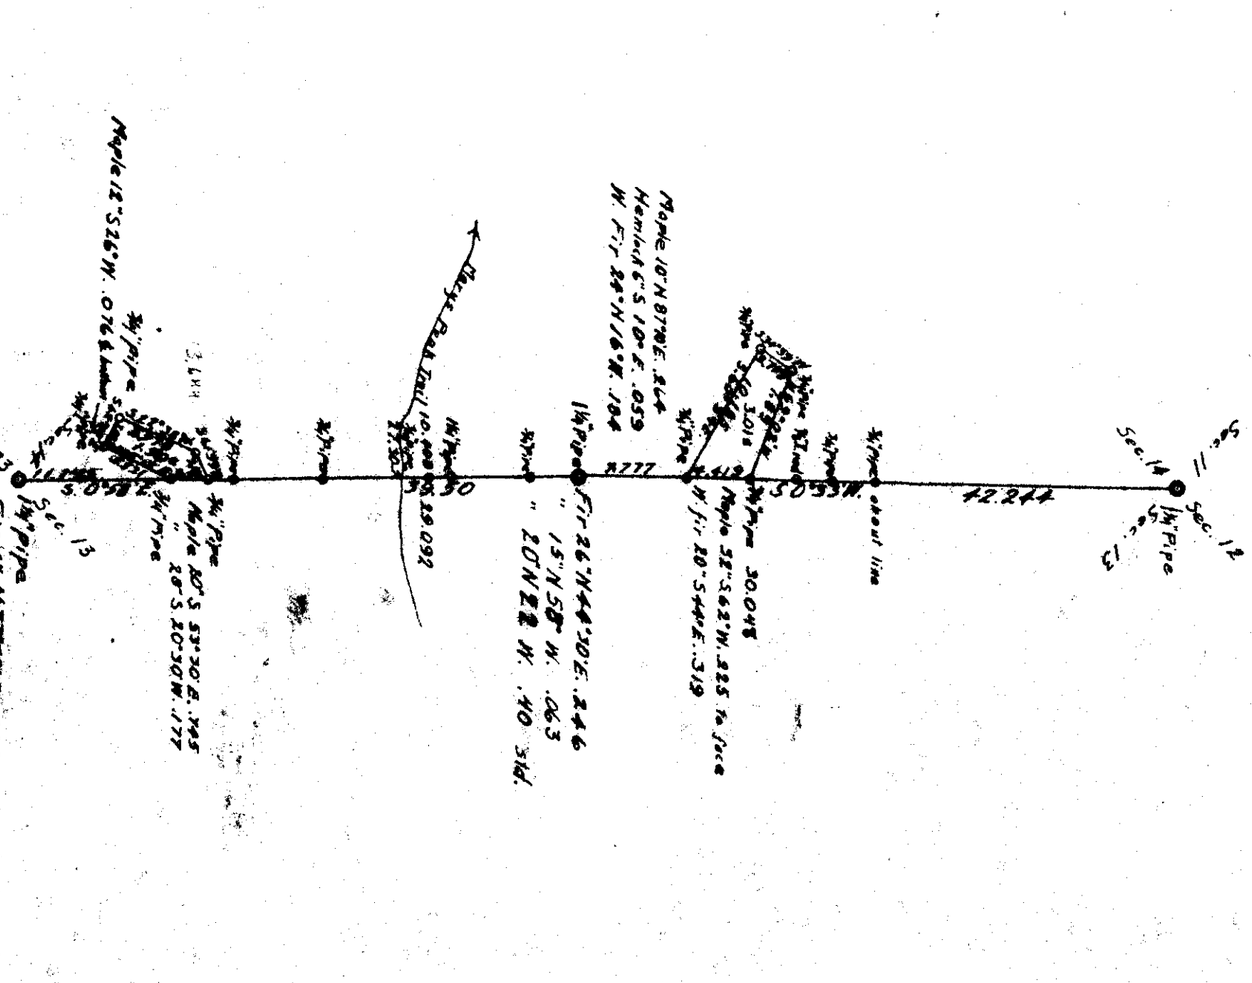
Scale 1" = 10 chs.