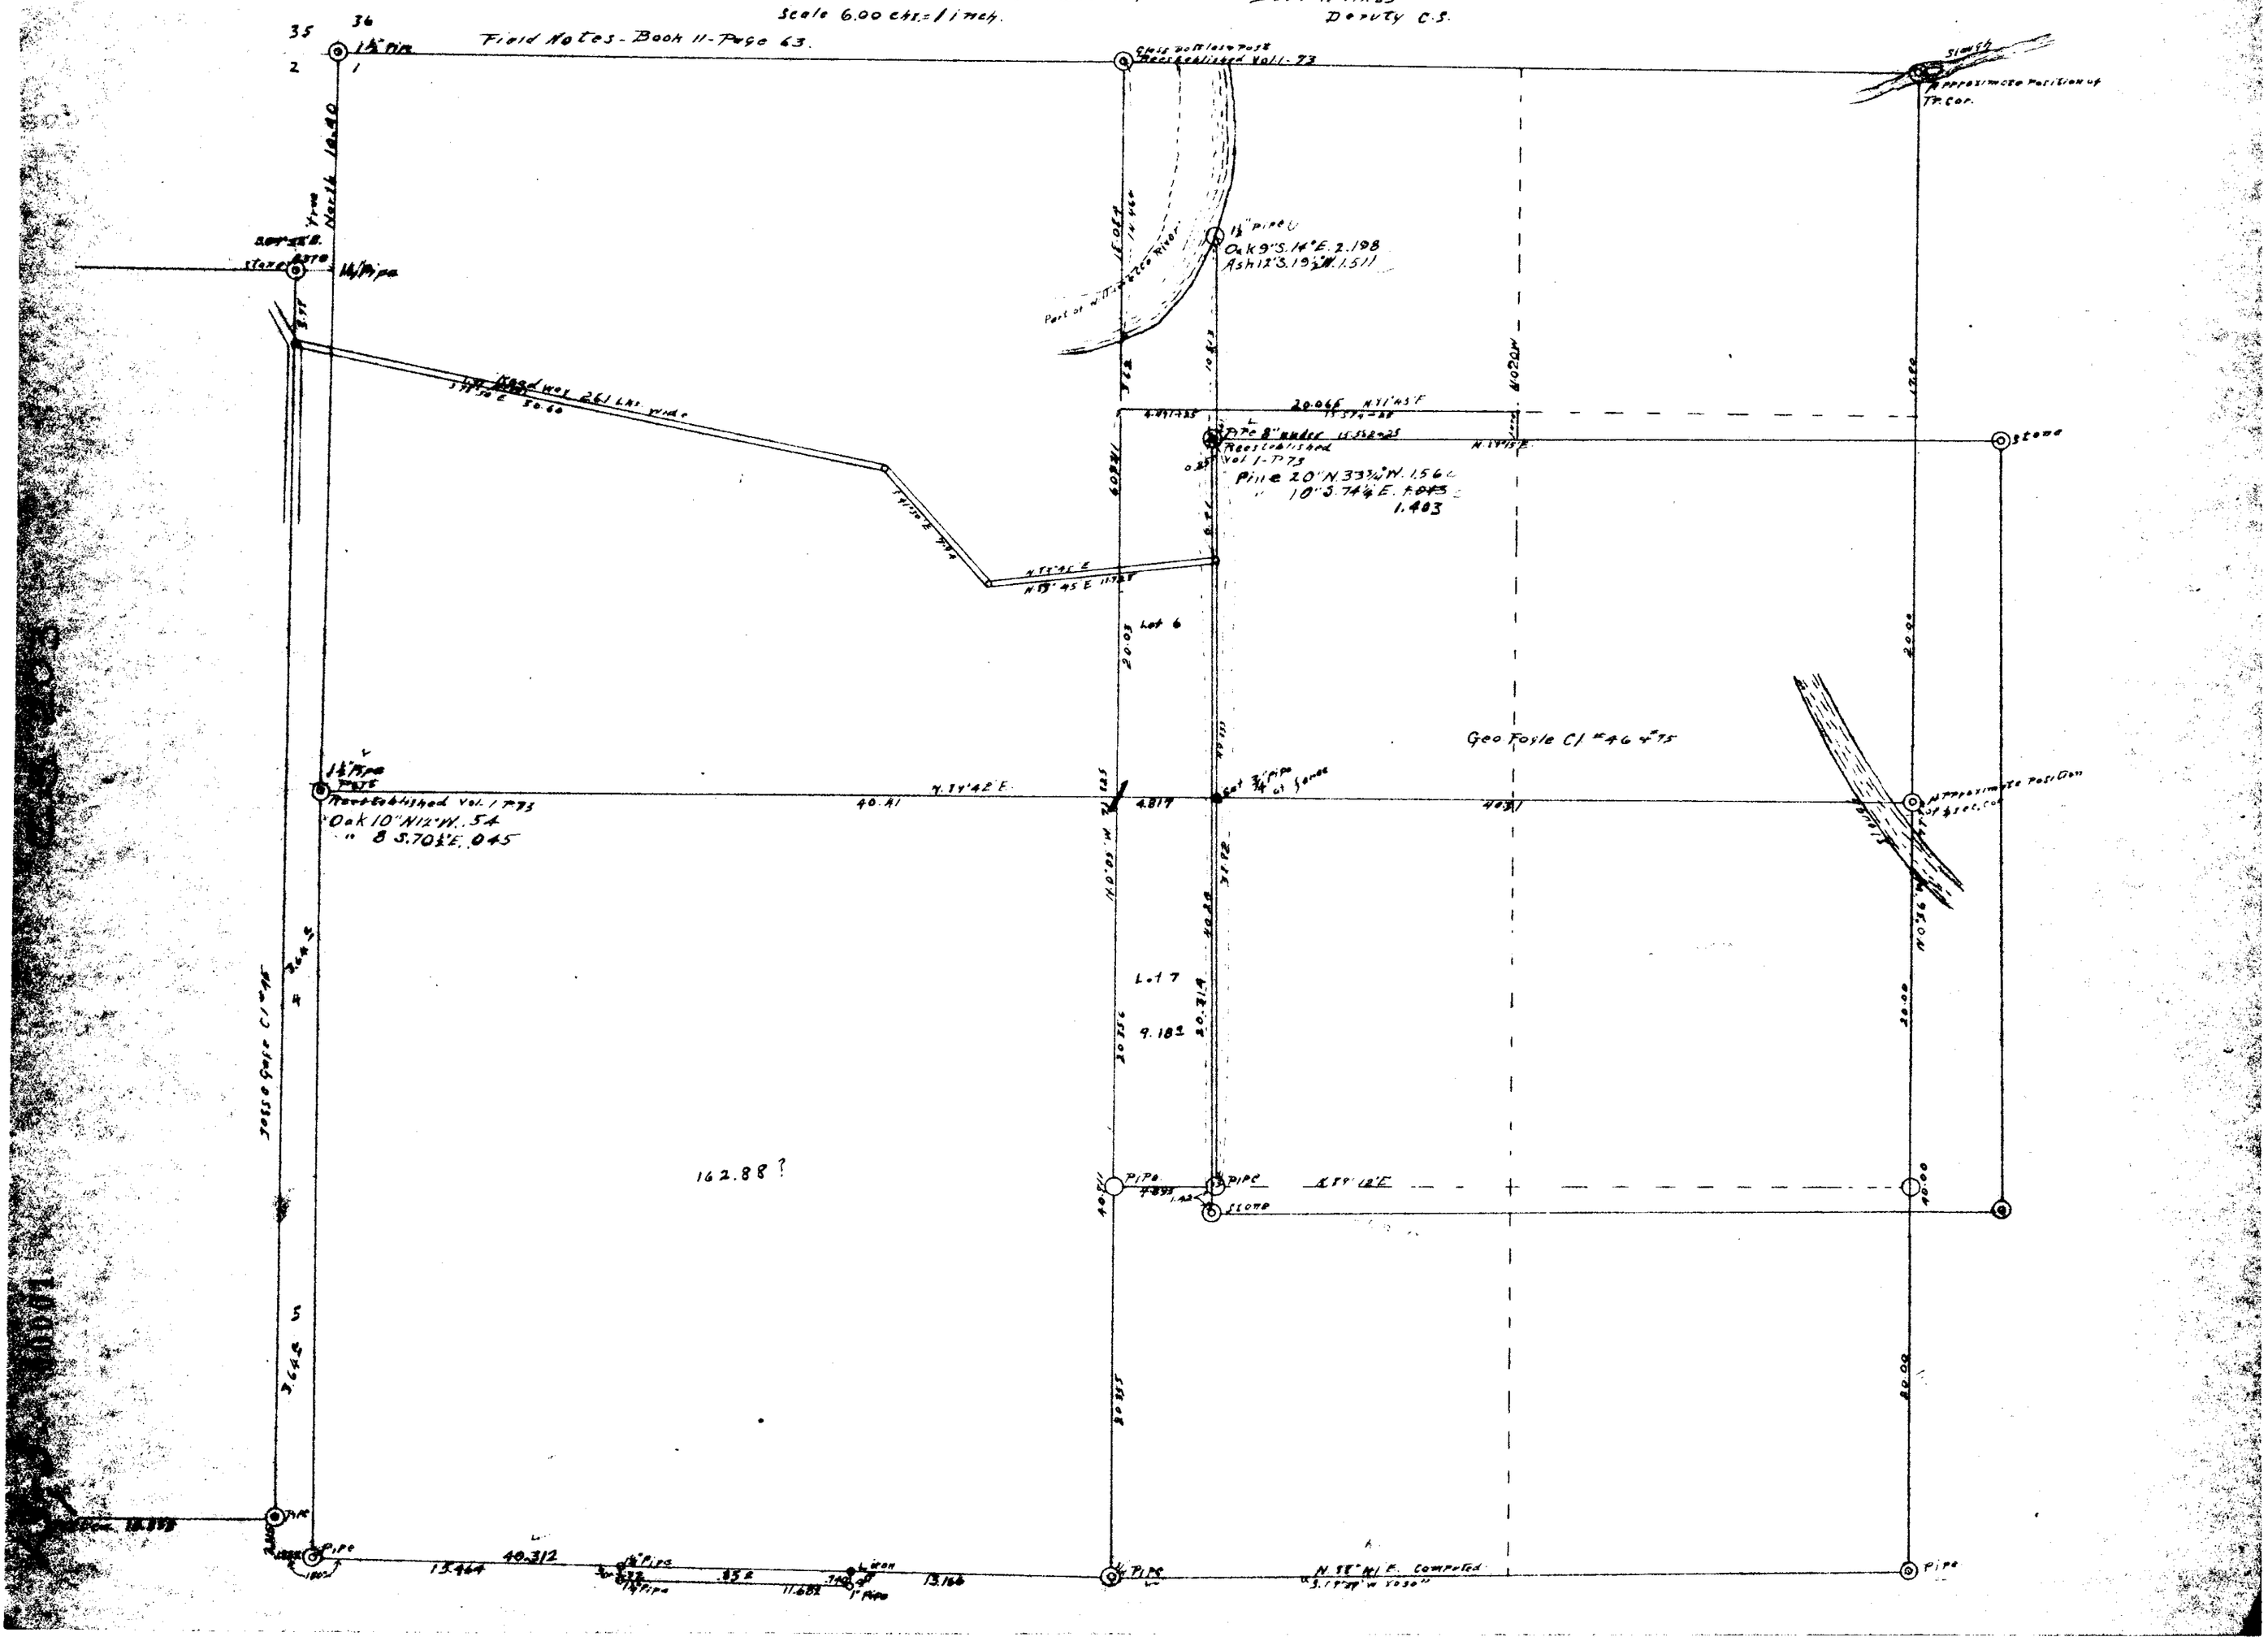Plat of Survey #203 - Sec. 1. T.13S. R5W.
For
J.G. Smith and C.F. Hahn
Begin. Jan 16 - Complete Jan 29 - 1914
Scale 6.00 chs. = 1 inch.
Burt Wilkes
Deputy C.S.