


SURVEY No. 304


Date - 1920

Surveyed By: M. W. ...


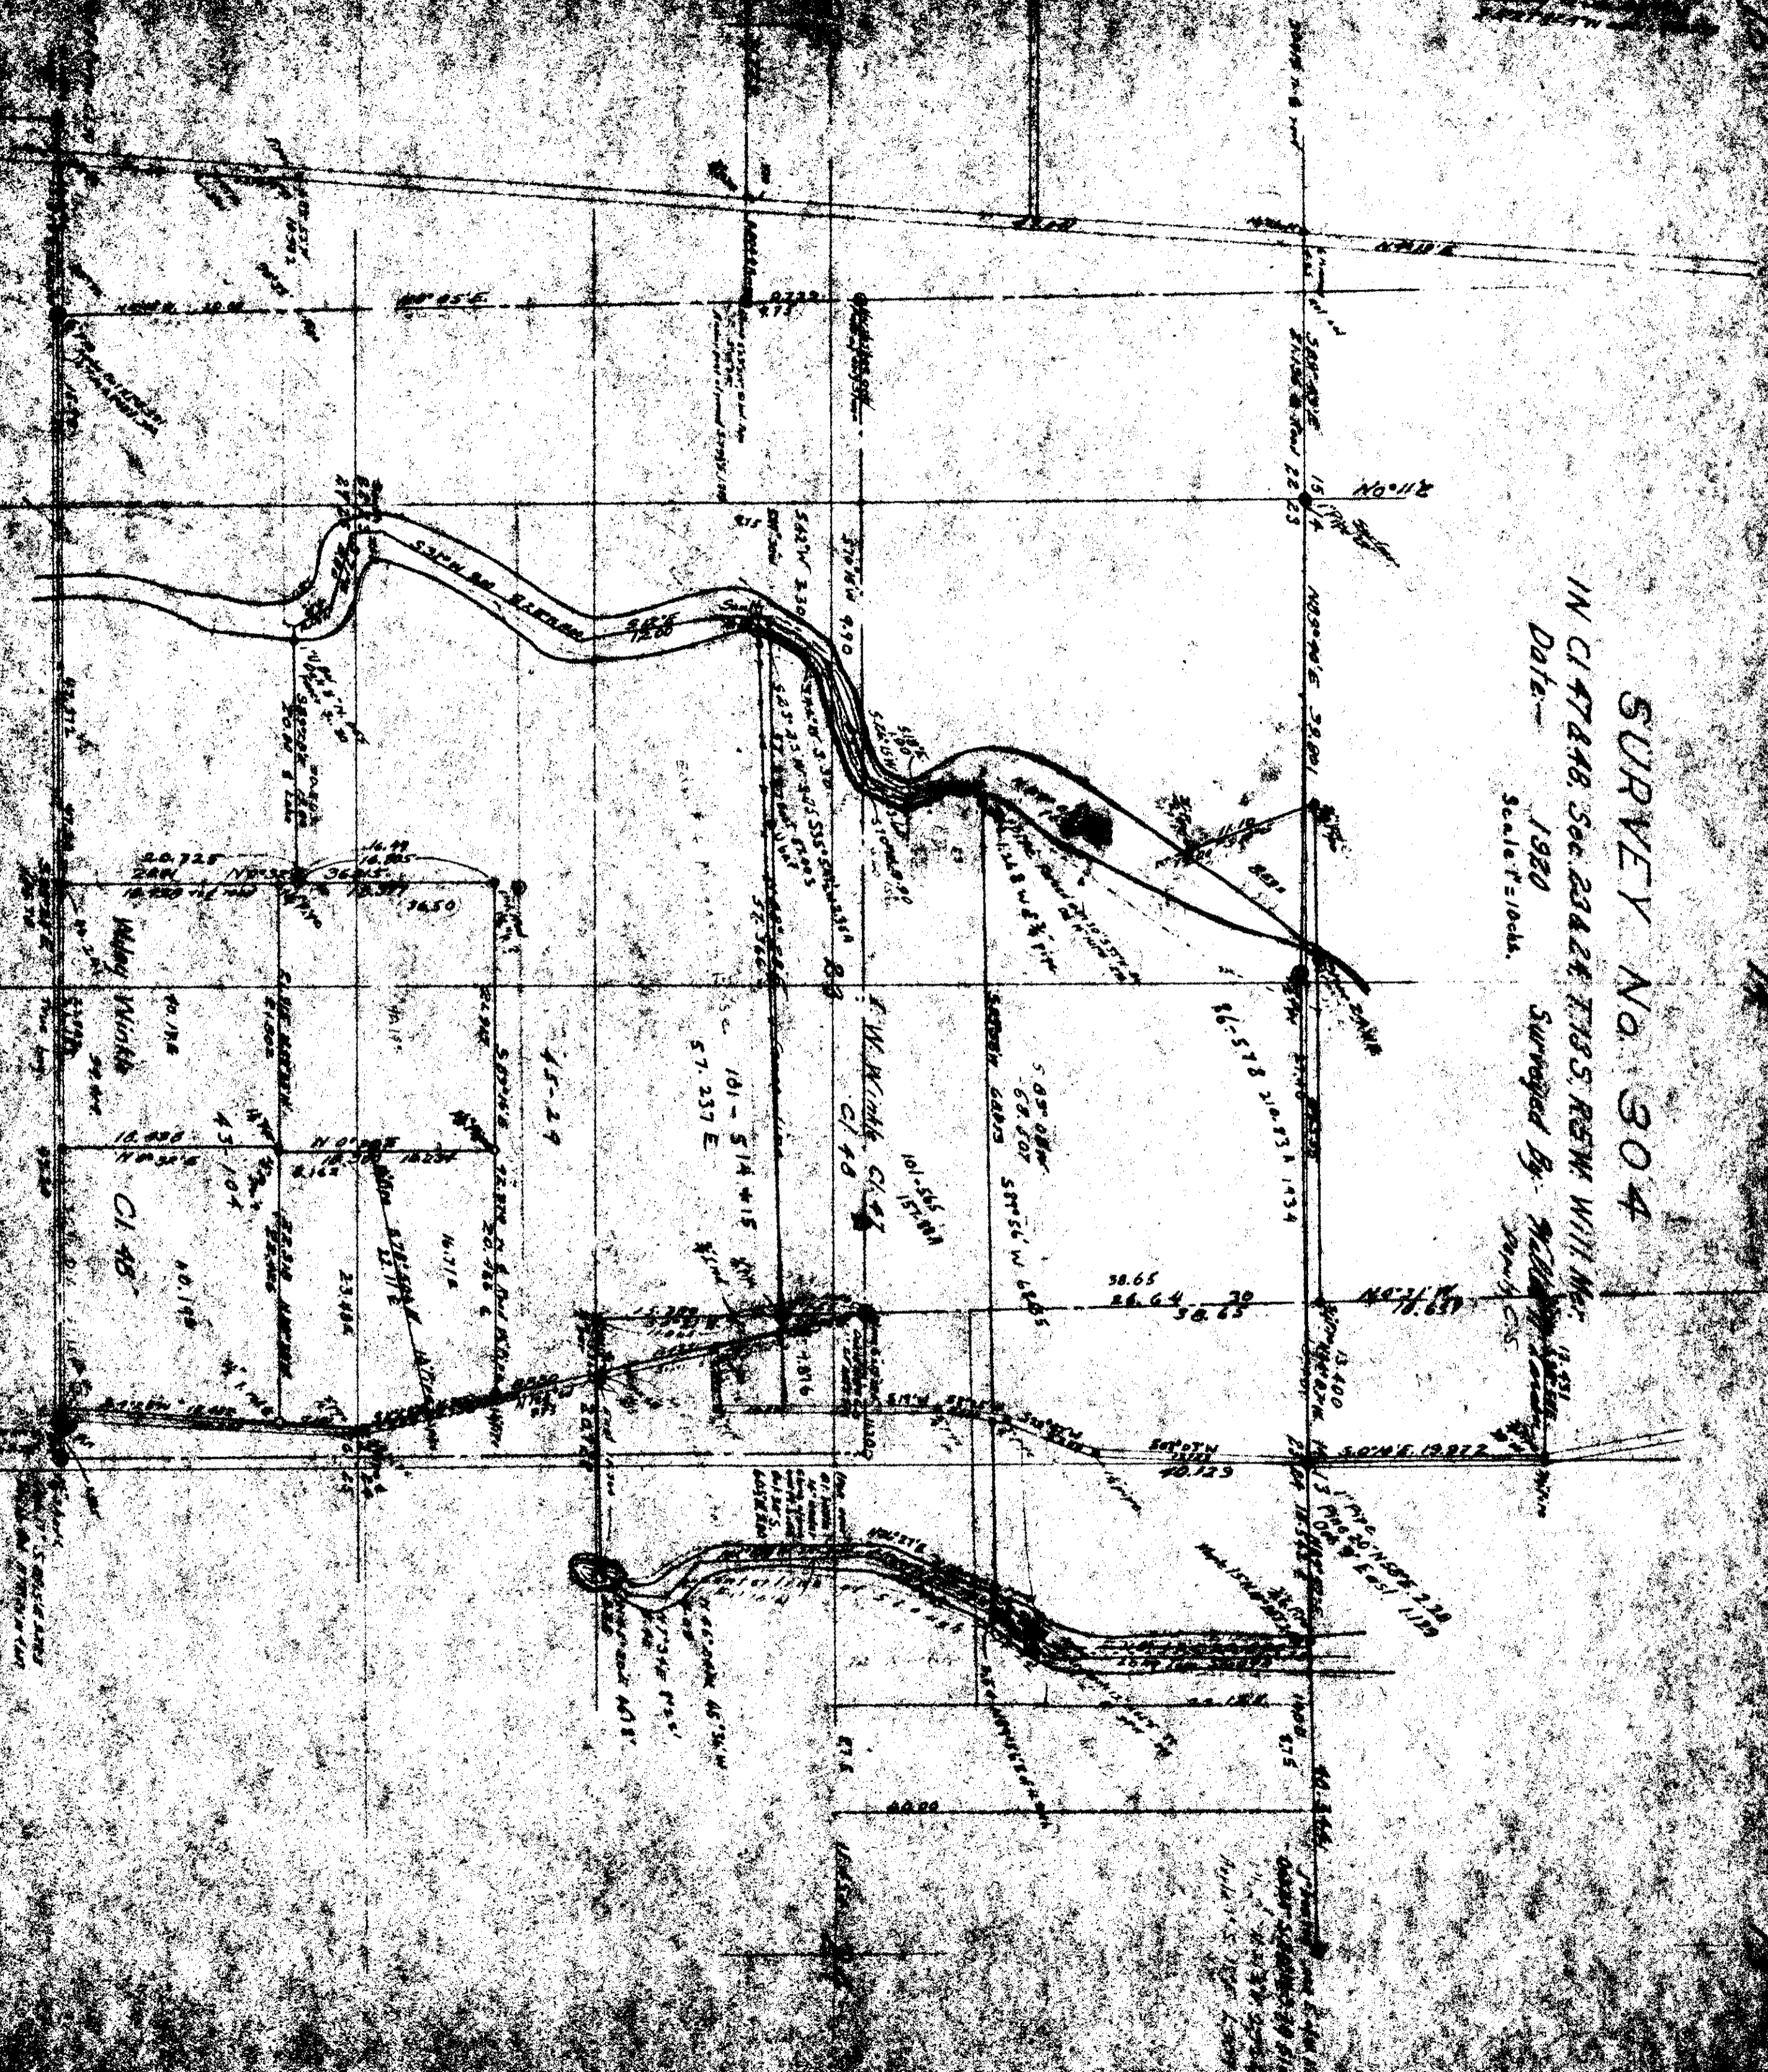

C1 48



Valley ...

F. W. ...

38.65

26.64

30

58.65

15.400

20.725

40.125

40.125

