C.S. ROAD #359 & C.S. 245

Tps. 13 & 14 S.R. 5 W. W. M.

Scale 1" = 20 chs.

W.C. Galloway

April 1915.
Oct. 1913.

For County

John Rickard
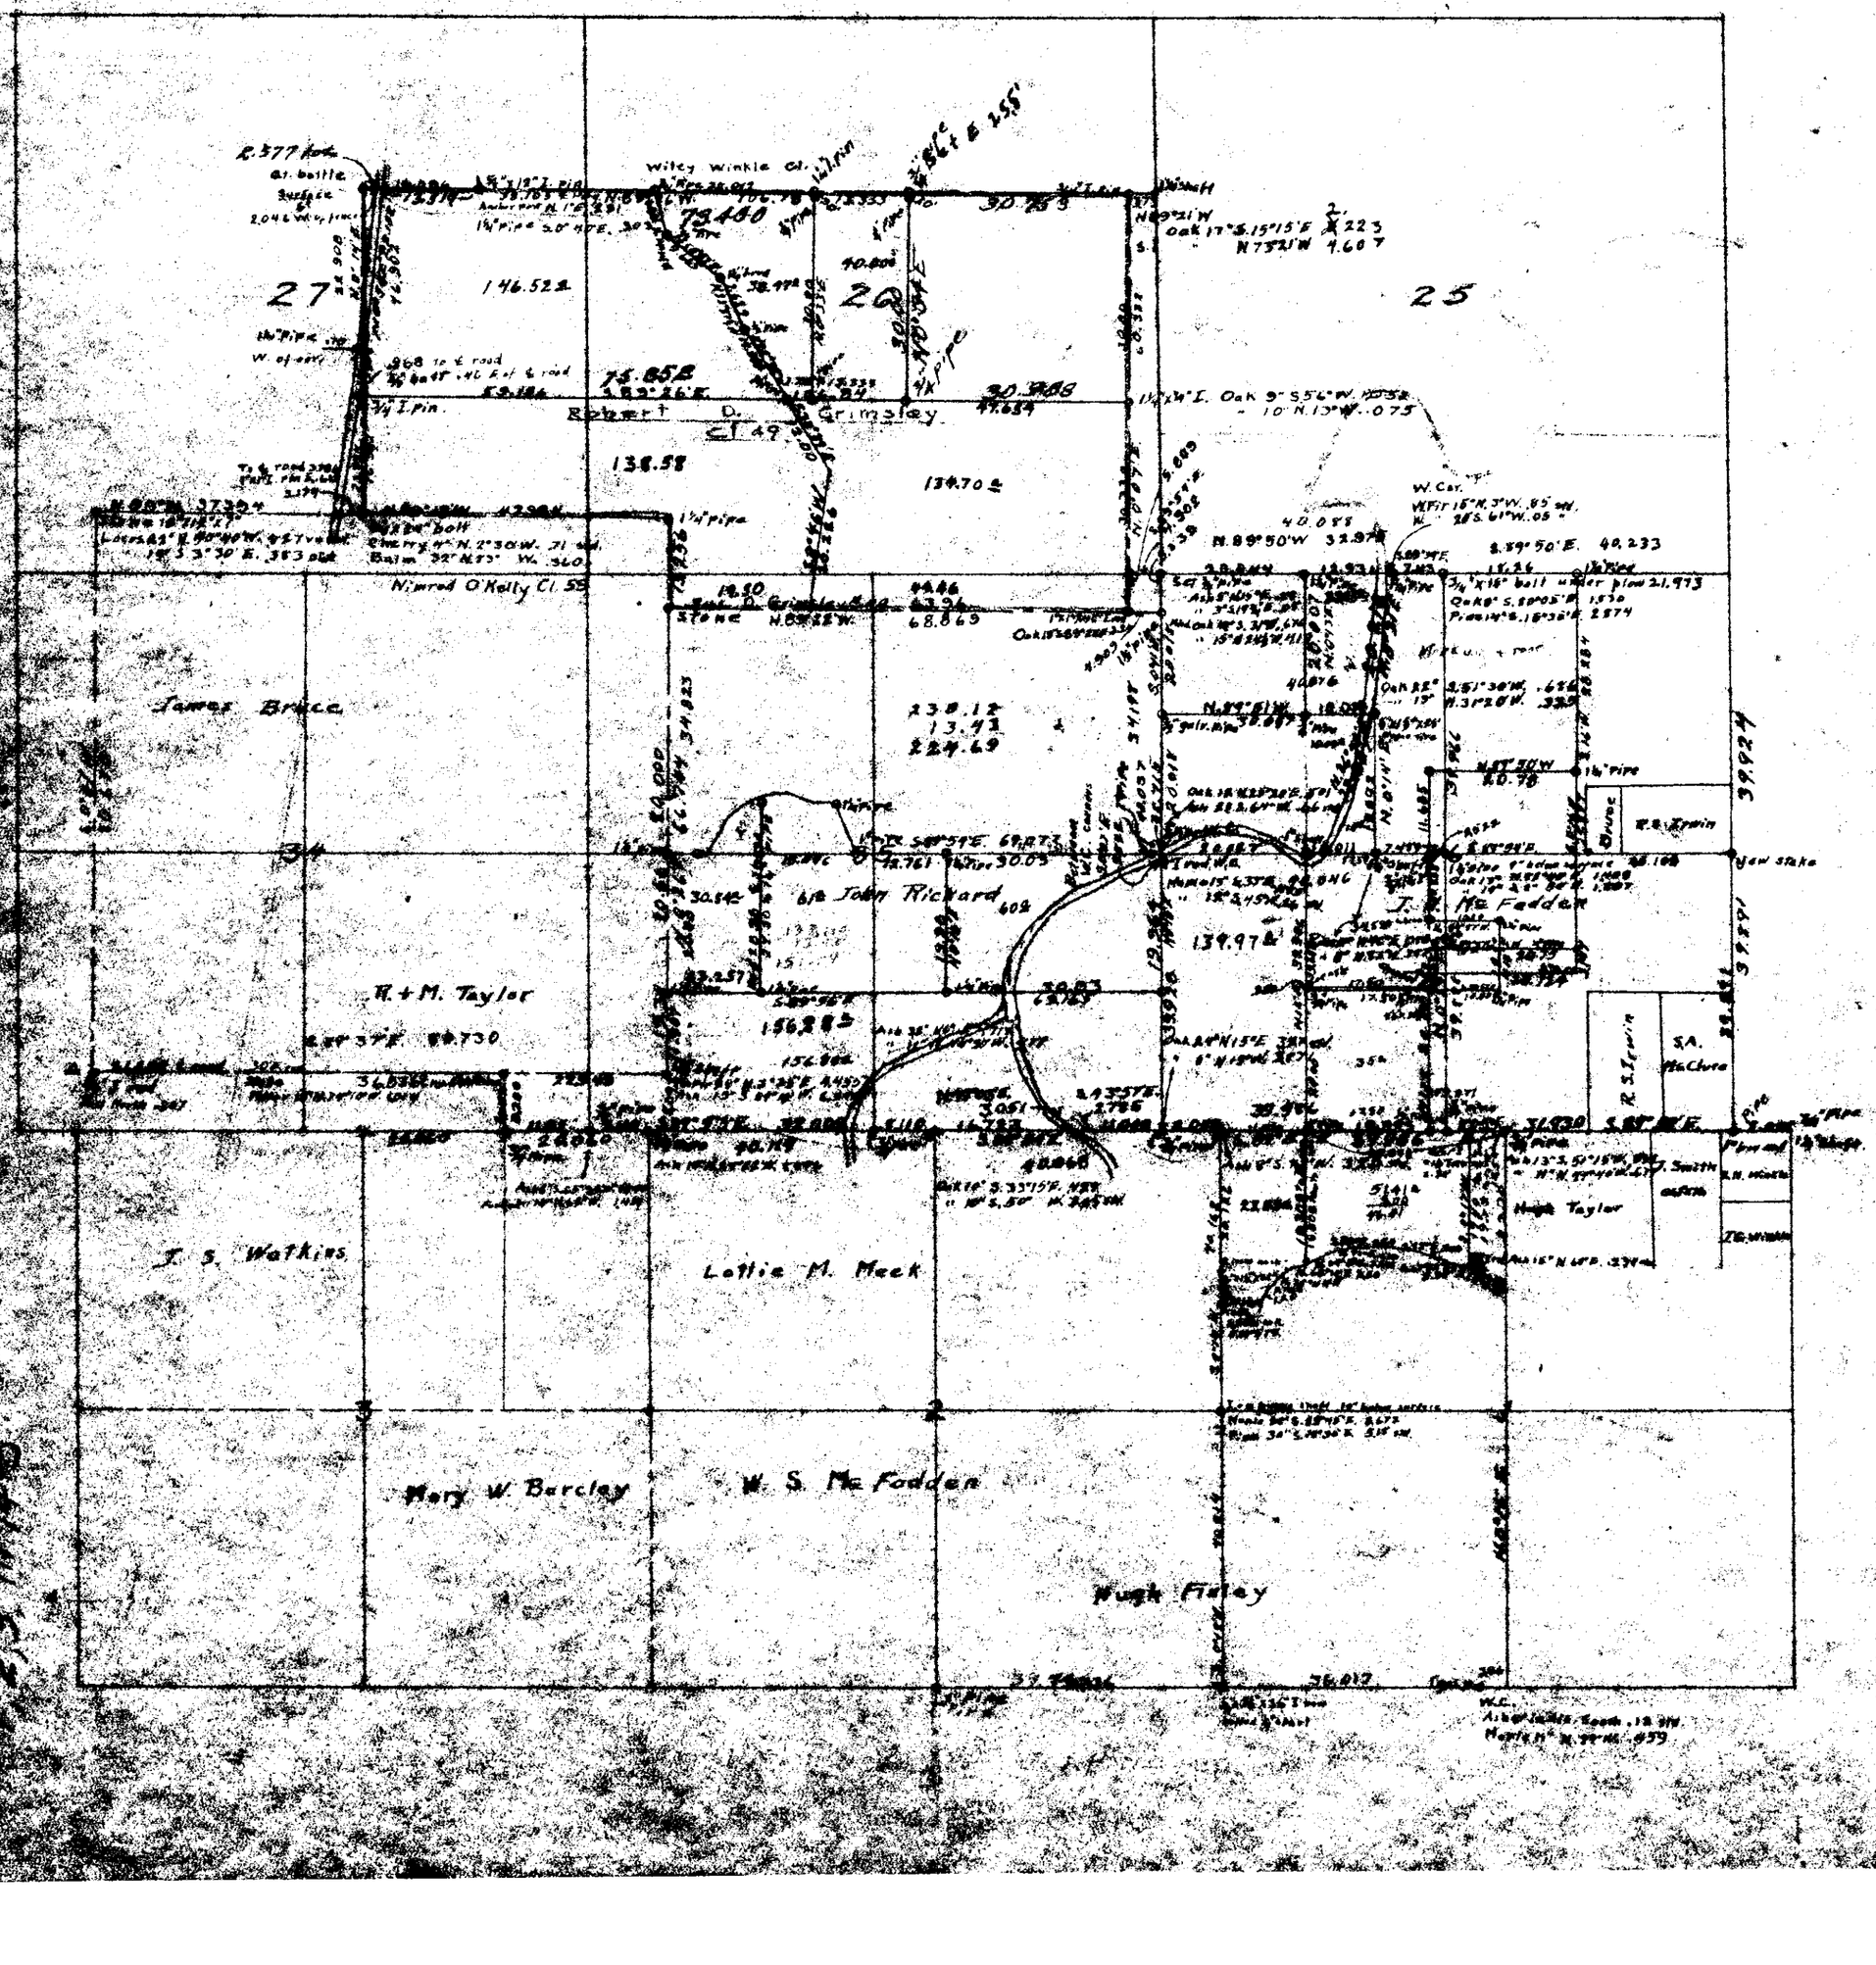
J. N. McFadden