136 00003

COUNTY SURVEY # 308
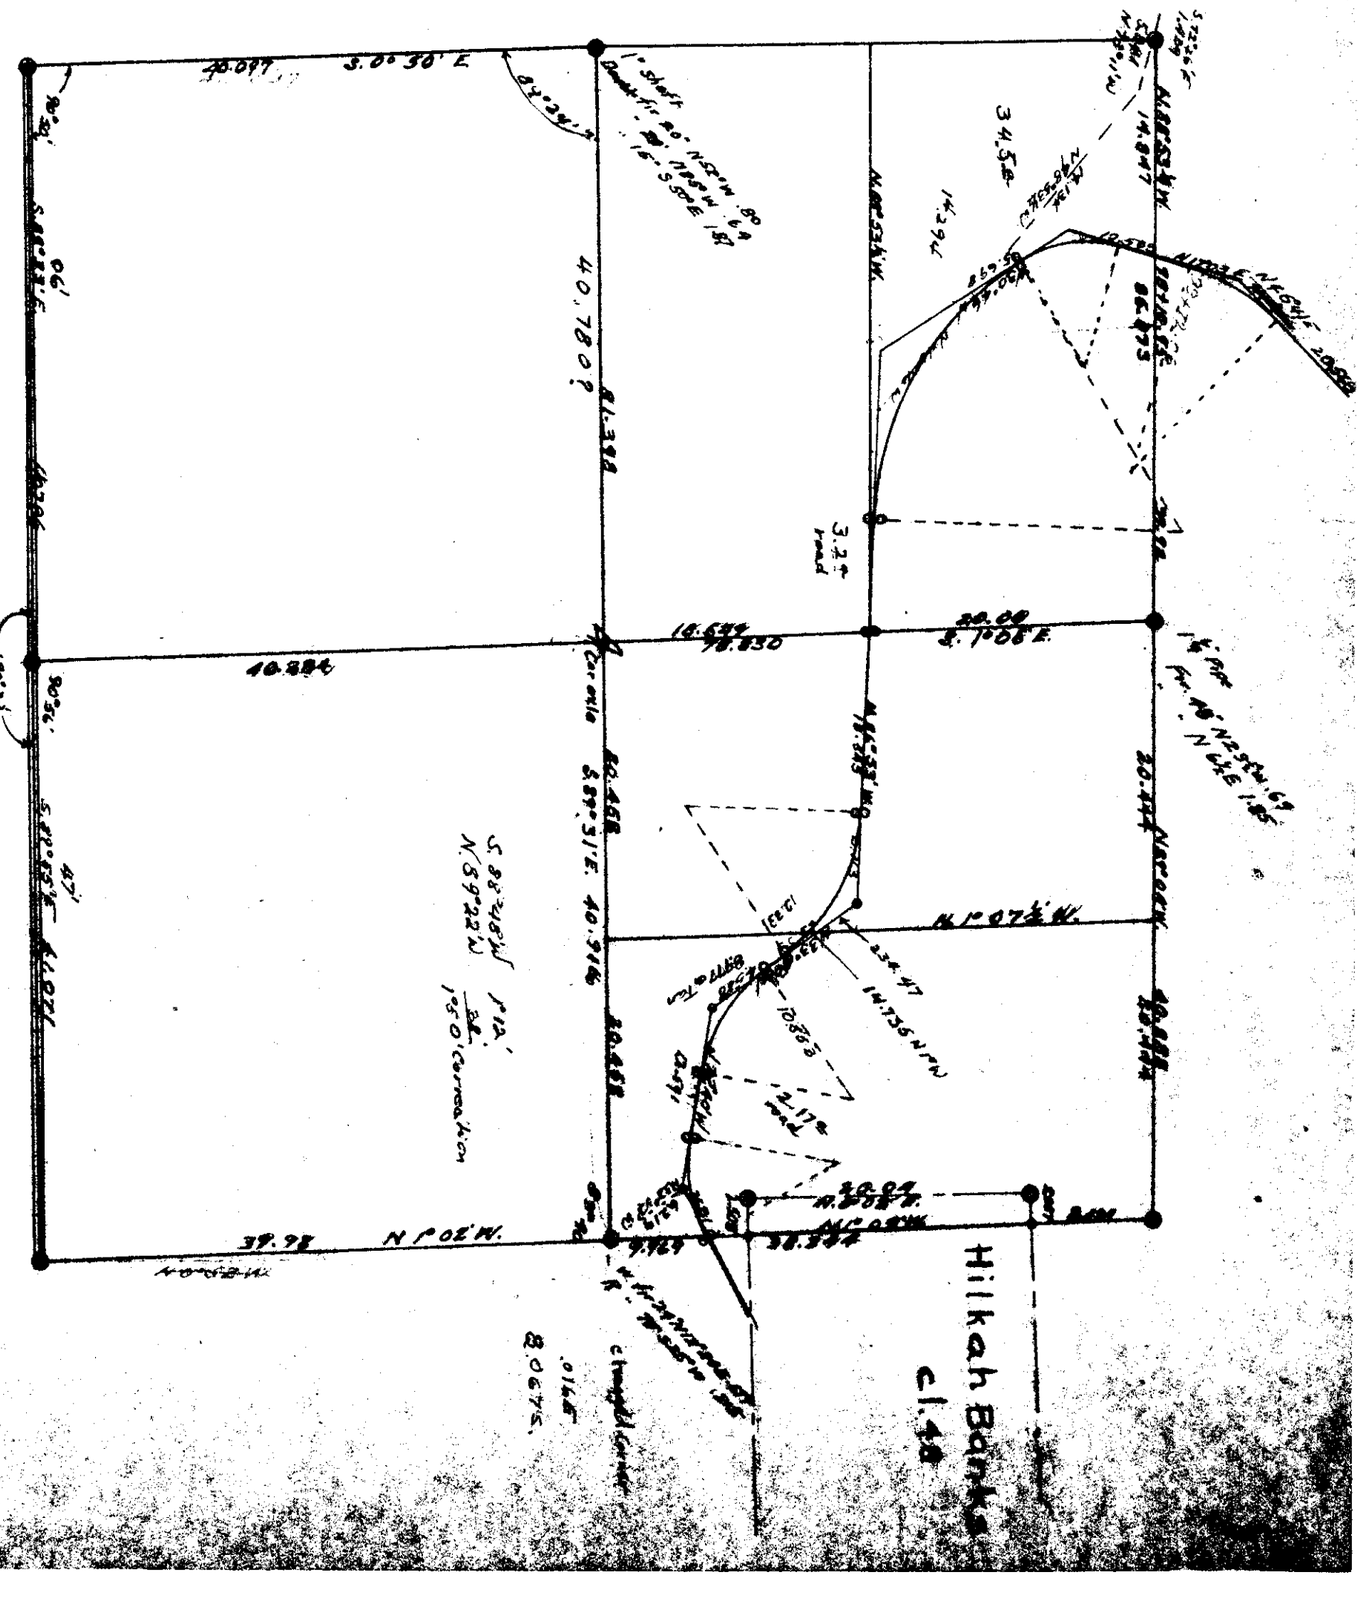
SCALE 1" = 10 CHS.