14-4 00001
30

COUNTY SURVEY #18 & #222

Sec. 30 T. 14S R 4 W.W.M.

Scale 1"=6 chs.

W.C. Galloway C.S.
Jan. 2, 1918.

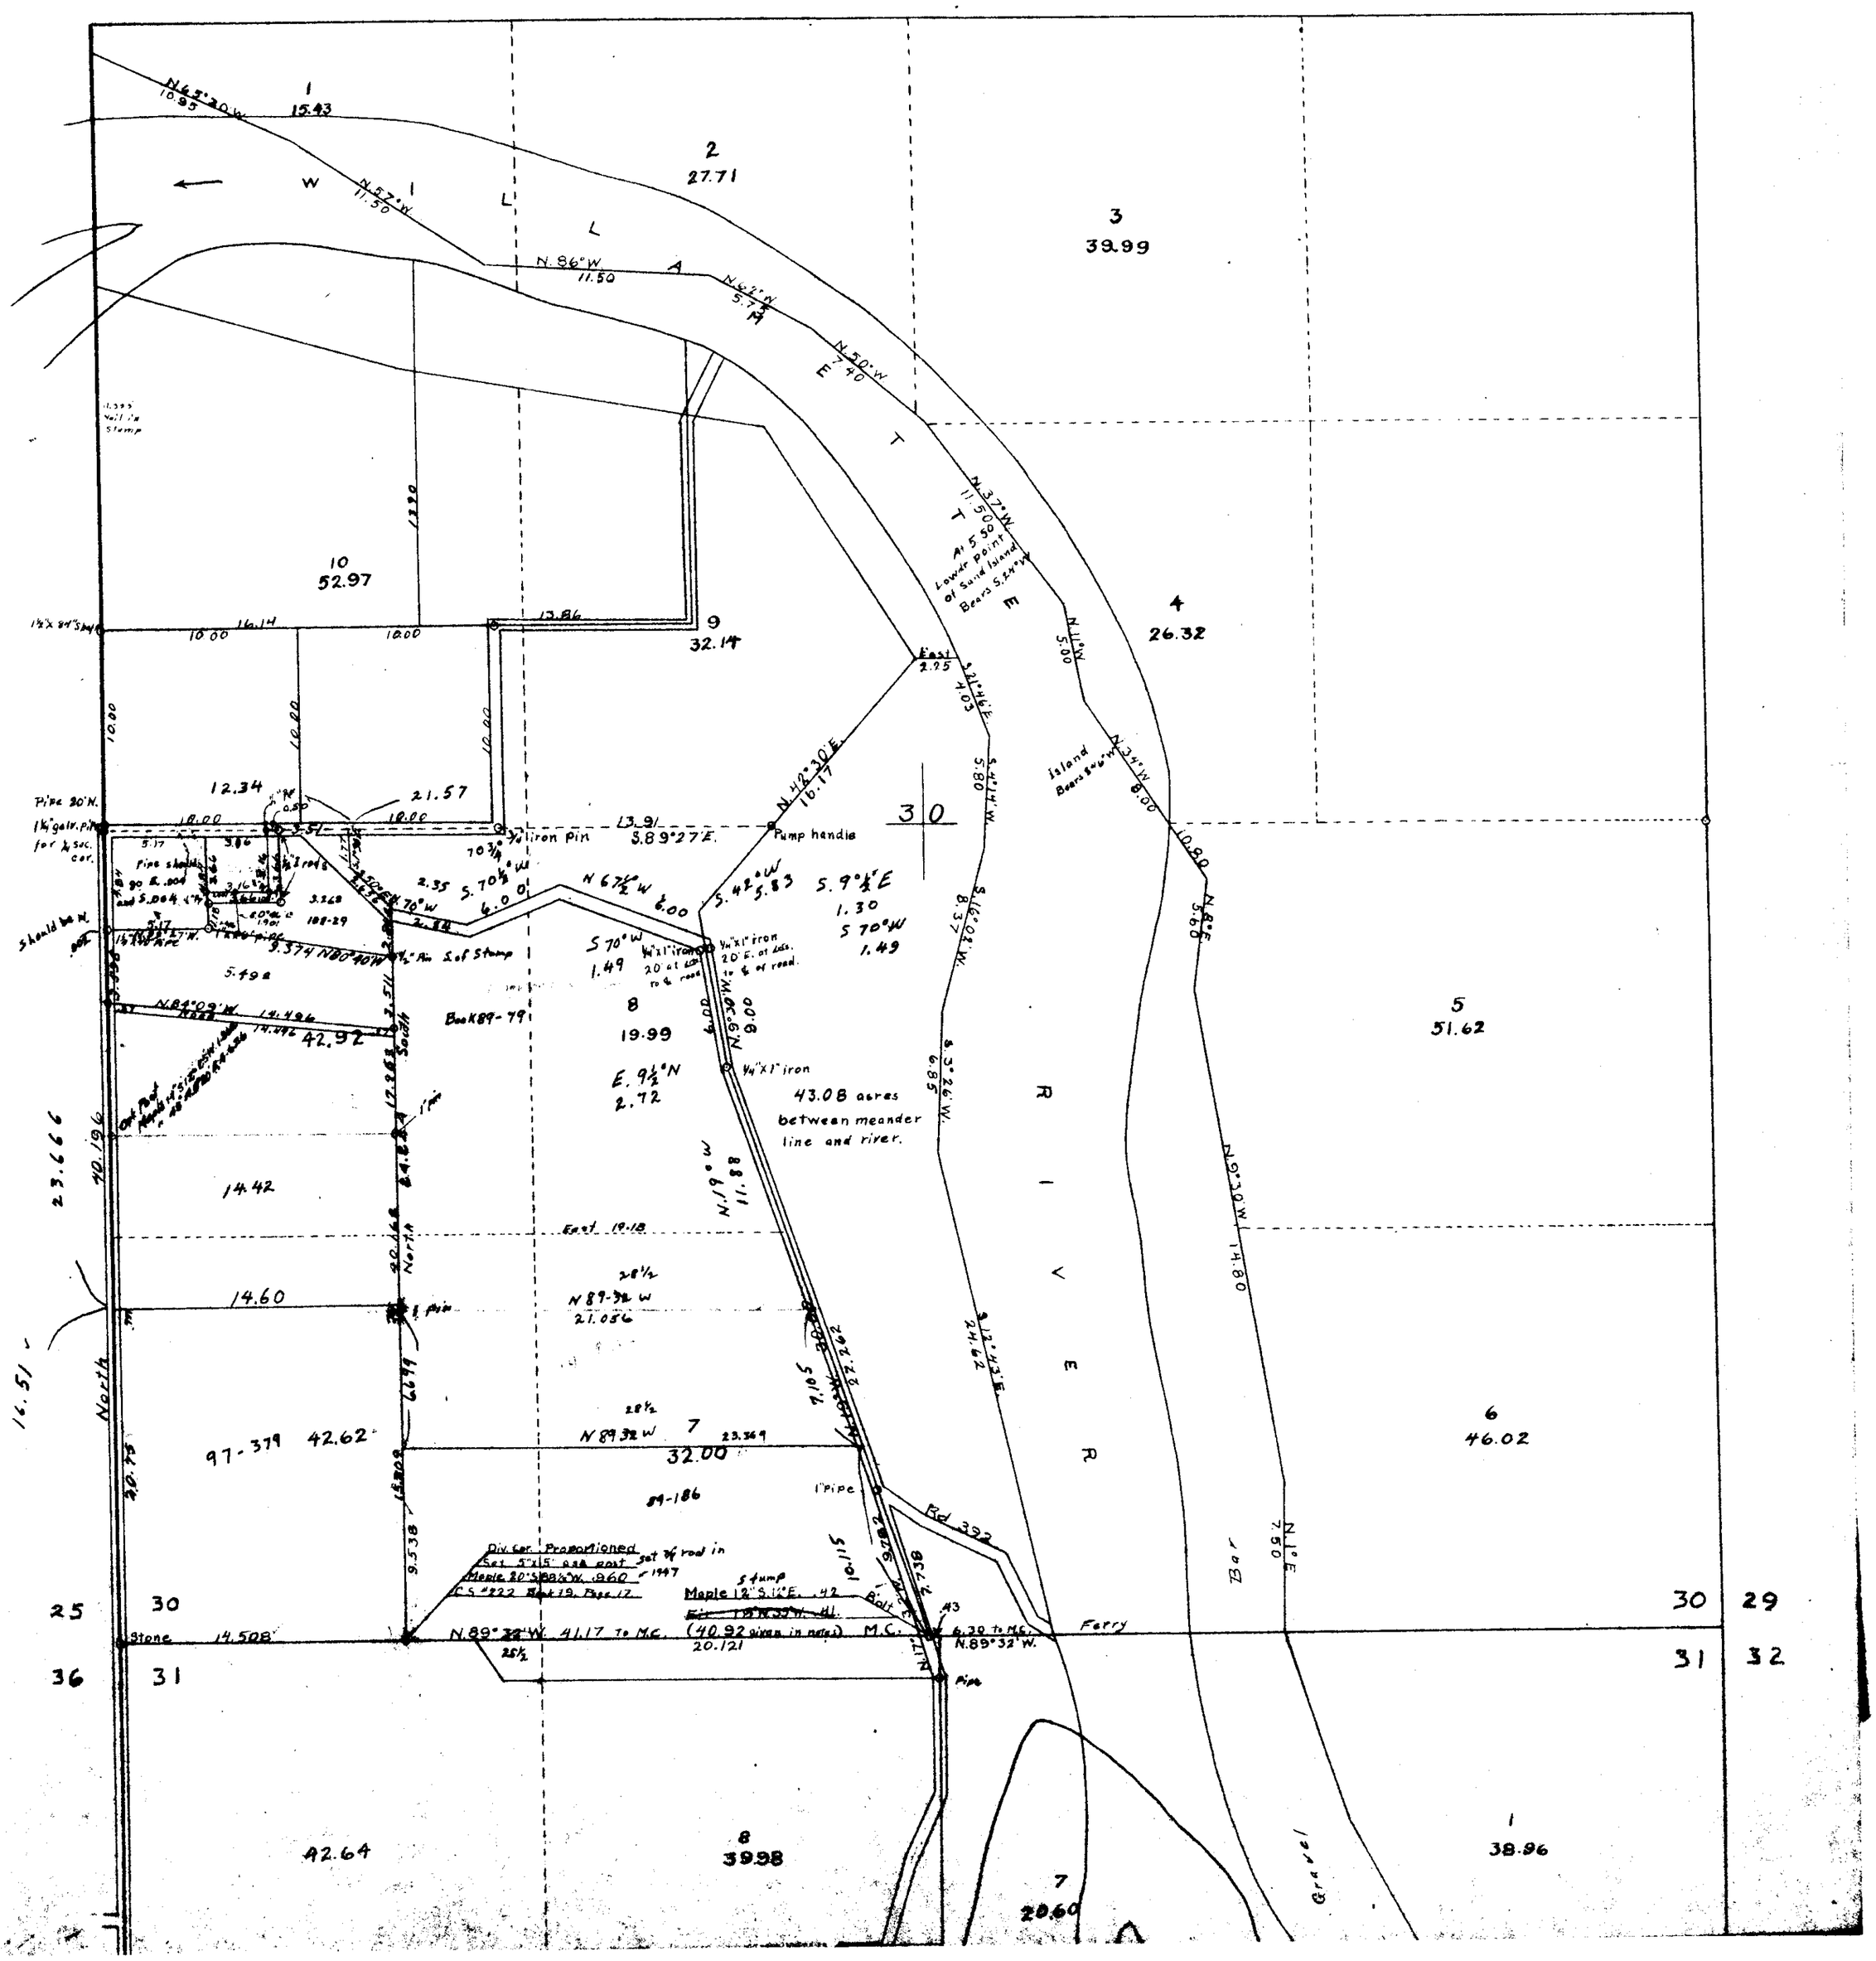
1
15.43
2
27.71
3
39.99
4
26.32
5
51.62
6
46.02
7
20.60
8
39.98
9
32.14
10
52.97
1
38.96
42.64
14.42
97-379 42.62
42.92
19.99
43.08 acres between meander line and river.
30
N57°W 11.50
N.86°W 11.50
N62°W 5.75
N.50°W E 7.40
N.37°W 11.50
At 5.50 Lower point of said Island Bears S.54°W
N.11°W 5.00
N.34°W 8.00
N.8°E 5.66
N.42°30'E 10.17
East 2.25
N.21°45'E 4.03
S.44°14'W 5.80
S.46°08'W 8.37
S.3°26'W 6.85
N.9°30'W 14.80
Island Bears S.6°W
Pump handle
Iron Pin
S.89°27'E. 13.91
Pipe 20'N. 1½" galv. pipe for ¼ sec. cor.
Pine shoulder 90 E. .004 and S.004 W
Shoulder bet N.
Stump
Book 89-79
East 19.18
North 20.196
N.89°32'W 14.60
N.89°32'W 21.056
N.89°32'W 23.369
N.89°32'W 41.17 to M.C.
(40.92 given in notes) M.C.
20.121
Set ¾" rod in 1947
Maple 12"S.W.E. .42
Maple 12"S.W.E. .41
Ash 6"N.E. .42
6.39 to M.C. N.89°32'W.
Ferry
Road 39.2
Bar
Gravel
Stone
Pin
Book 89-186
Div. cor. Proportioned
Set 5"x15" ash post
Maple 20"S.88½°W. .960
C.S. #222 Book 19, Page 17
Set ¾" rod
Set ¾" rod in
1" Pipe
Old Post
