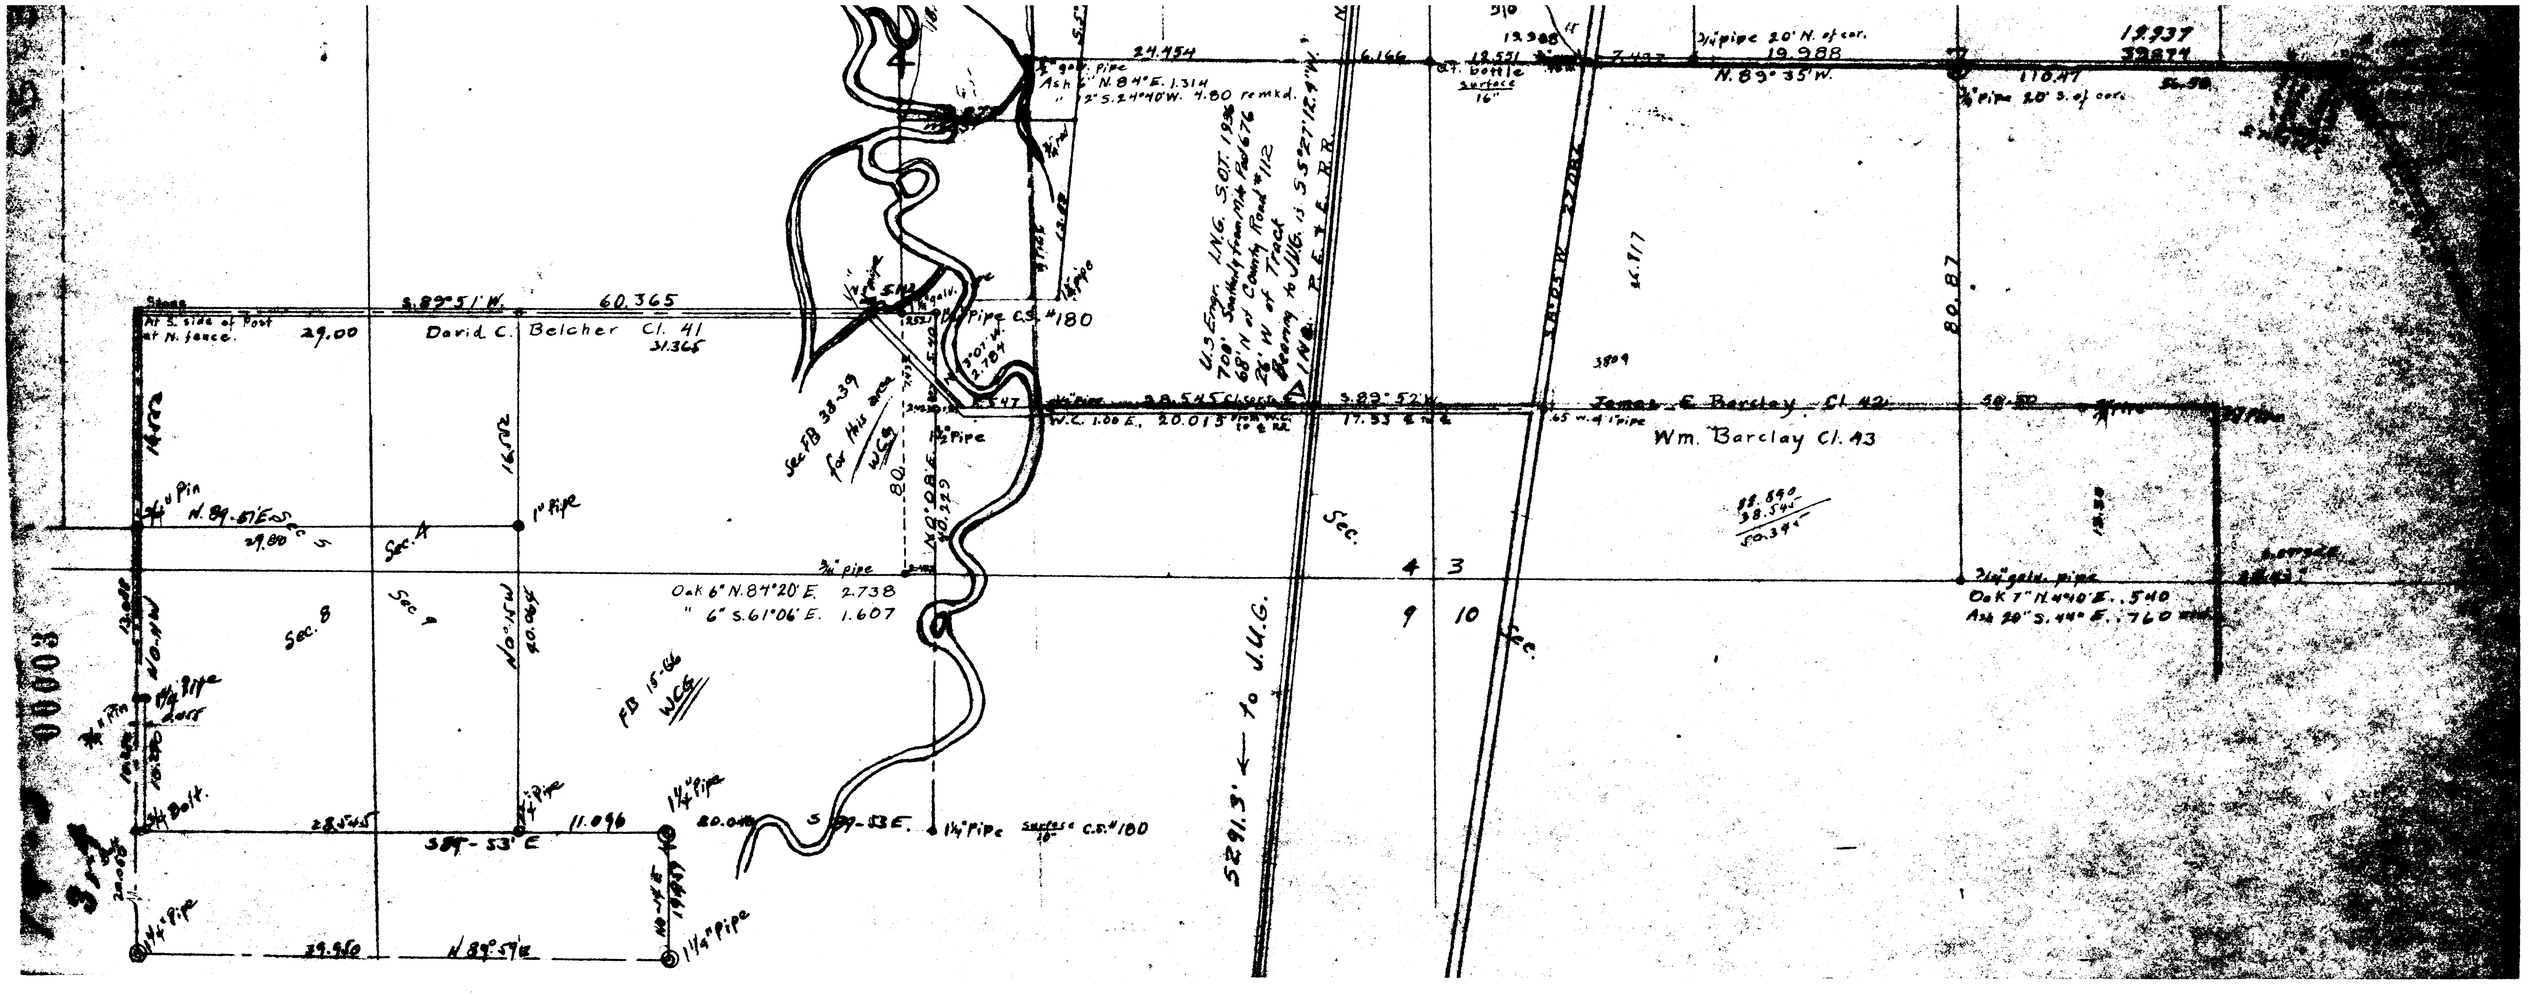
David C. Belcher Cl. 41
31.365
S. 89° 51' W. 60.365
Stone N. & S. side of Post at N. fence.
29.00
Sec. A
Sec. B
Sec. 9
Sec. 4
Sec. 3
Sec. 10
1" Pipe
¾" Pipe
¾" Pin N. 89° 51' E. 29.80
Oak 6" N. 87° 20' E. 2.738
" 6" S. 61° 06' E. 1.607
FB 15-46 WCG
S. 89° 53' E. 11.096
1¼" Pipe
20.00
S. 89° 53' E.
1¼" Pipe Surface C.S. #180
N. 89° 57' E. 29.960
1¼" Pipe
S. 89° 52' W. 28.545
W.C. 1.00 E., 20.013
17.33
¾" Pipe
James E. Barclay Cl. 42
Wm. Barclay Cl. 43
98.890
38.544
60.346
5291.3' ← To U.U.G.
U.S. Engr. U.G. SOT 1938
700' Southerly from Mile Post 676
68' W. of County Road #112
29' W. of Tract
Bearing to U.U.G. is S. 5° 27' 12.9" W.
S. 89° 52' W.
80.87
24.454
6.166
13.591
Ash 6" N. 84° E. 1.314
" 2" S. 24° 40' W. 4.80 re mkd.
¾" gal. pipe
Ash 20" N. 89° 35' W. 19.988
¾" Pipe 20' N. of cor.
¾" Pipe 20' S. of cor.
110.47
¾" gal. pipe
Oak 7" N. 44° E. .540
Ash 20" S. 44° E. .760
12.937
32.874
50.58
3809
3810
13.388
7.483
Surface 16"
Pipe C.S. #180
3.07' W. 2.10' N.
5.47
5.117
80.87
16.532
80.08
N. 0° 08' E. 229
N. 0° 15' W. 40.045
