14-5
7, 18, 19

00006
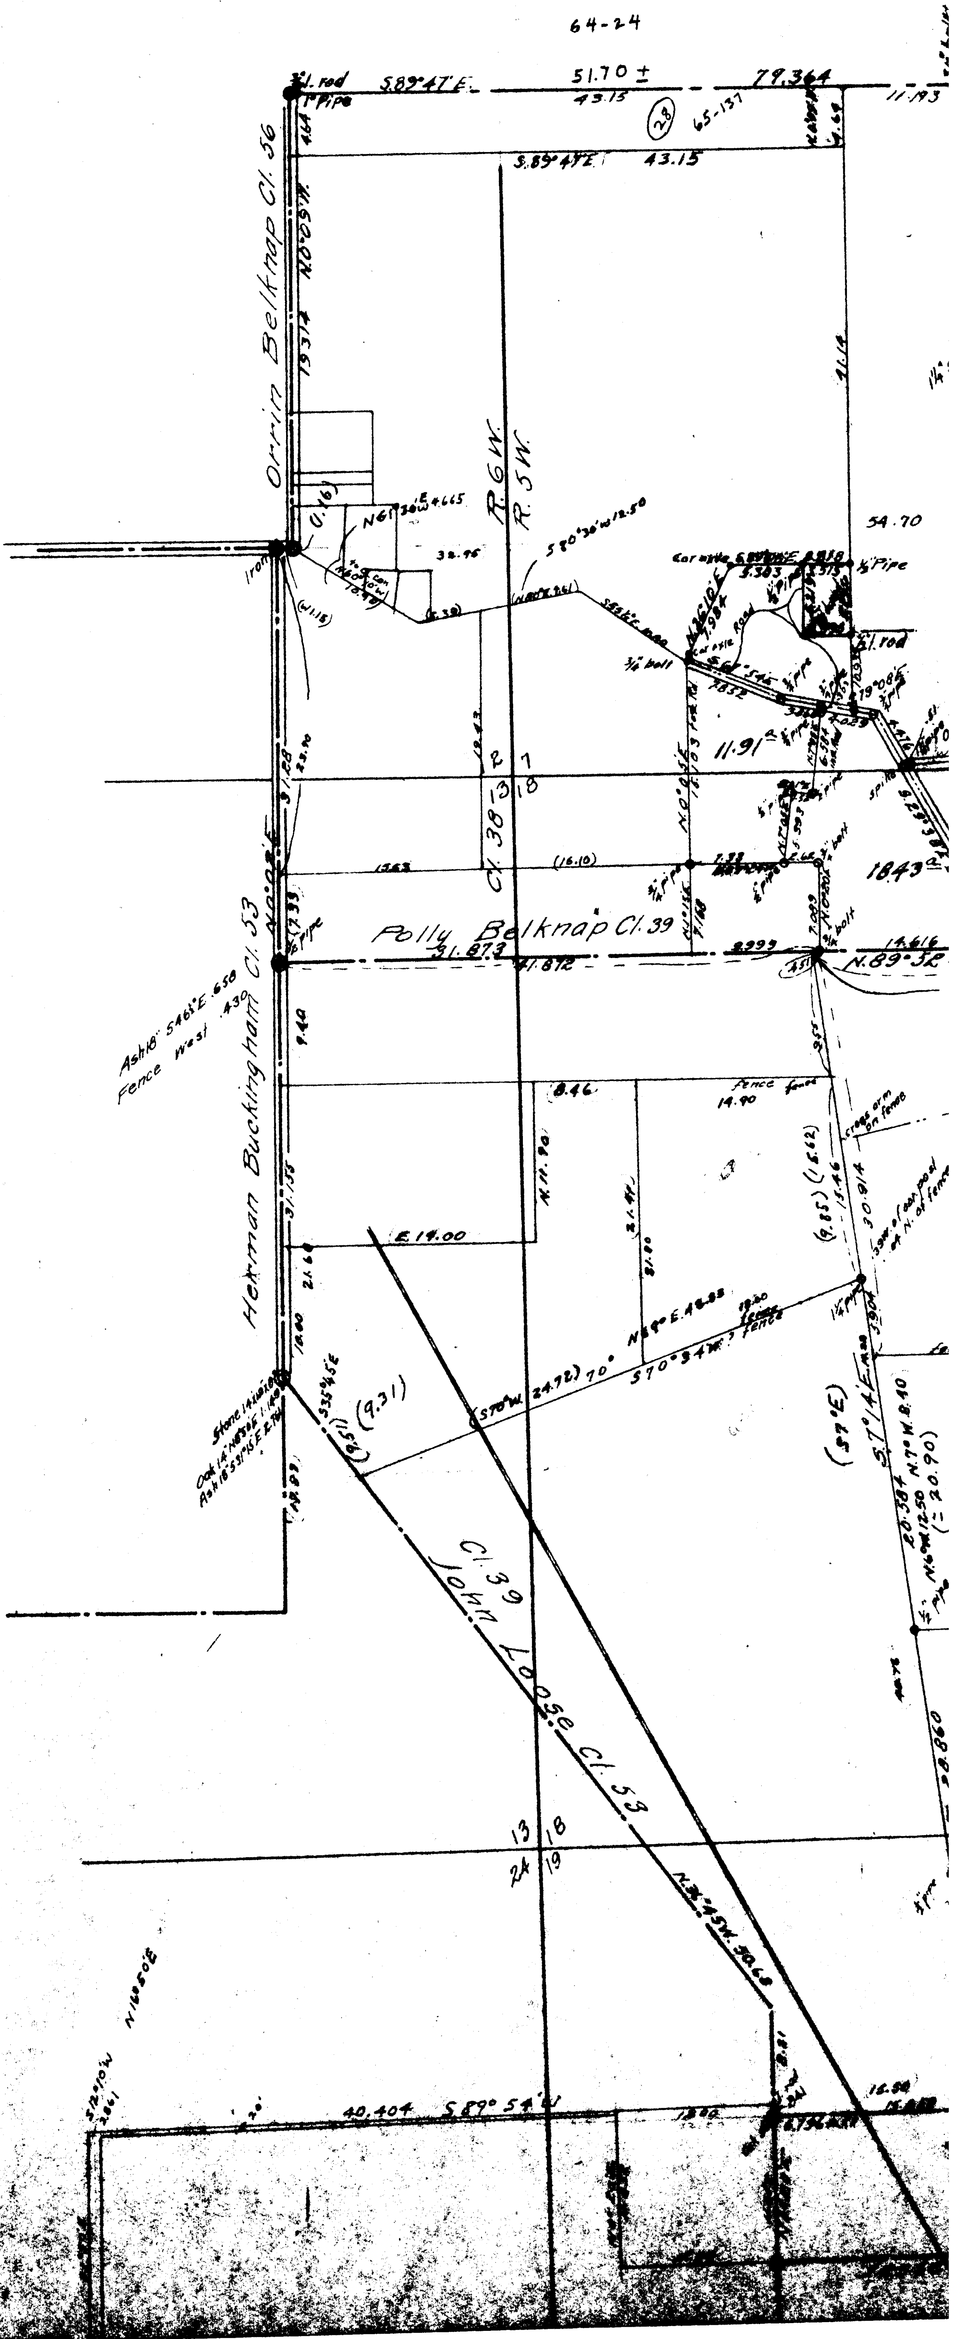
C. S. 334
T. 14 S. R. 5 & 6
Scale: - 1 in. = 10 chs.