00012

COUNTY SURVEY #171

PLAT
OF

F. P. SWINSON'S RANCH

BENTON COUNTY OREGON

T. 14 S. R. 5 W. Will. Mer.

Scale 1" = 6 chs.

County Survey #171
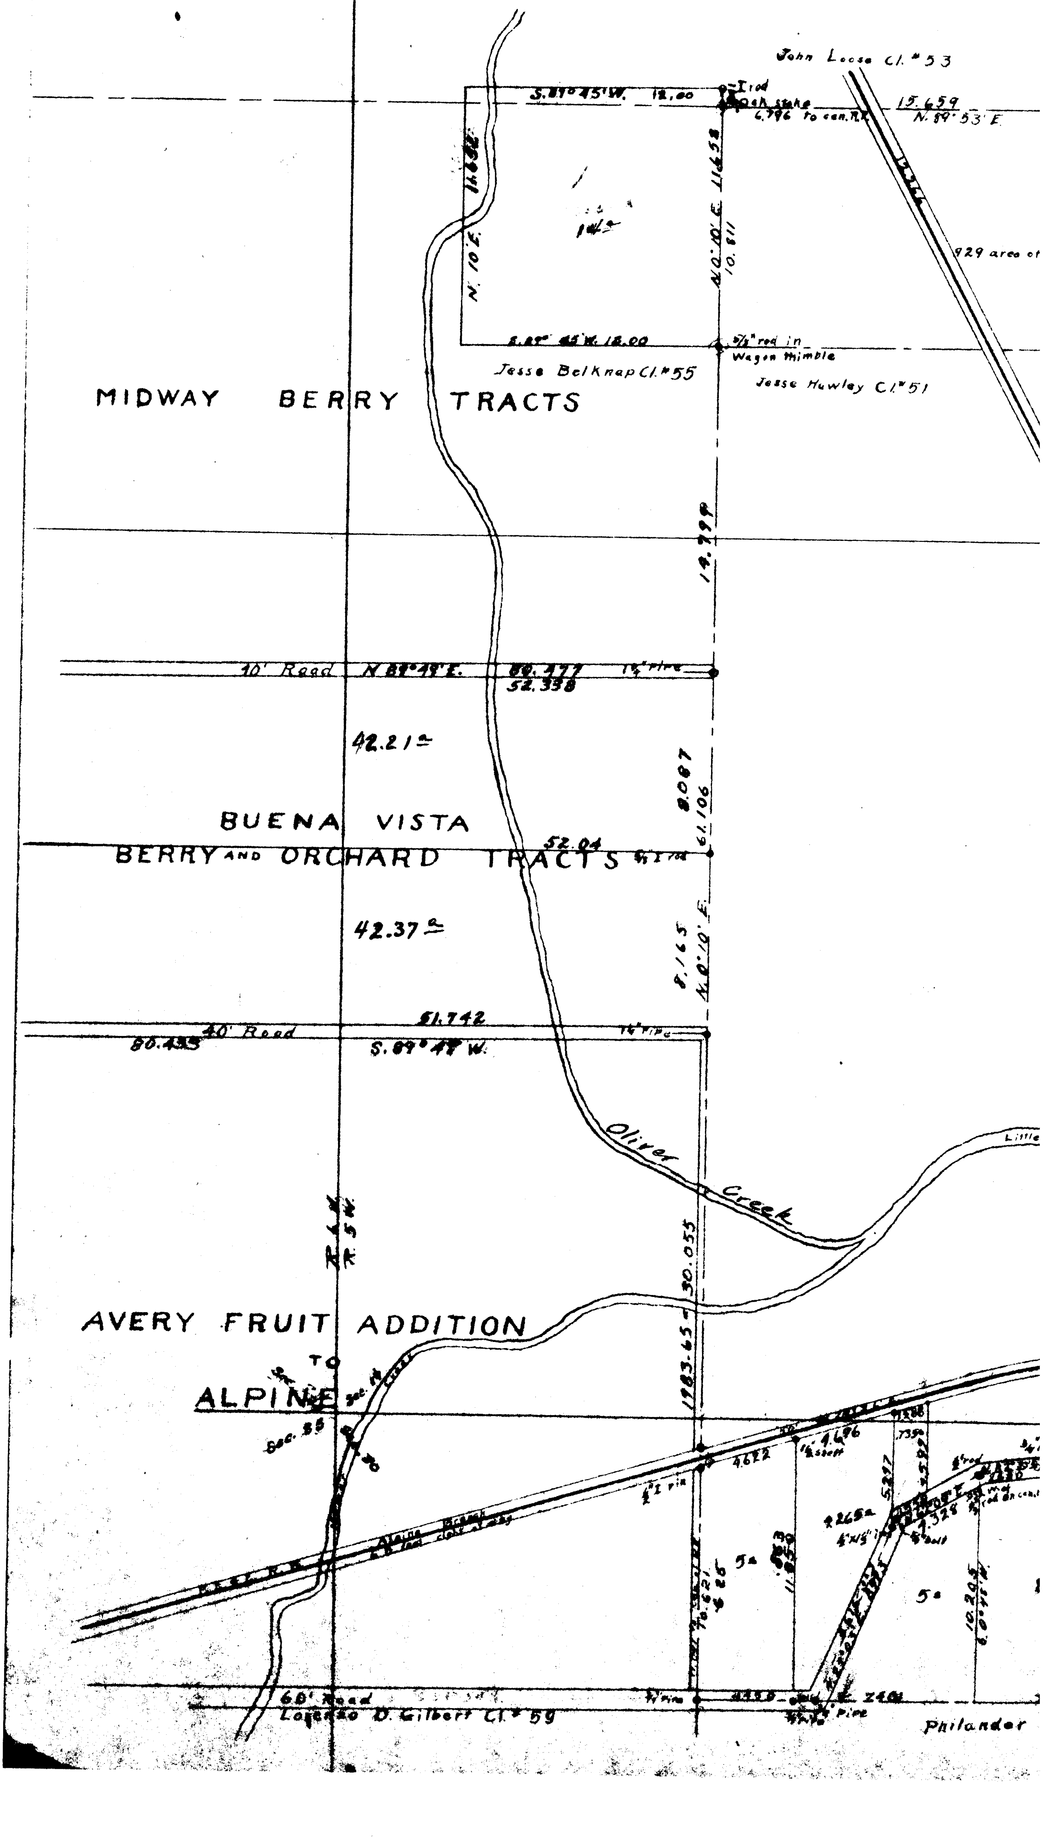
W.C. Galloway C.S.