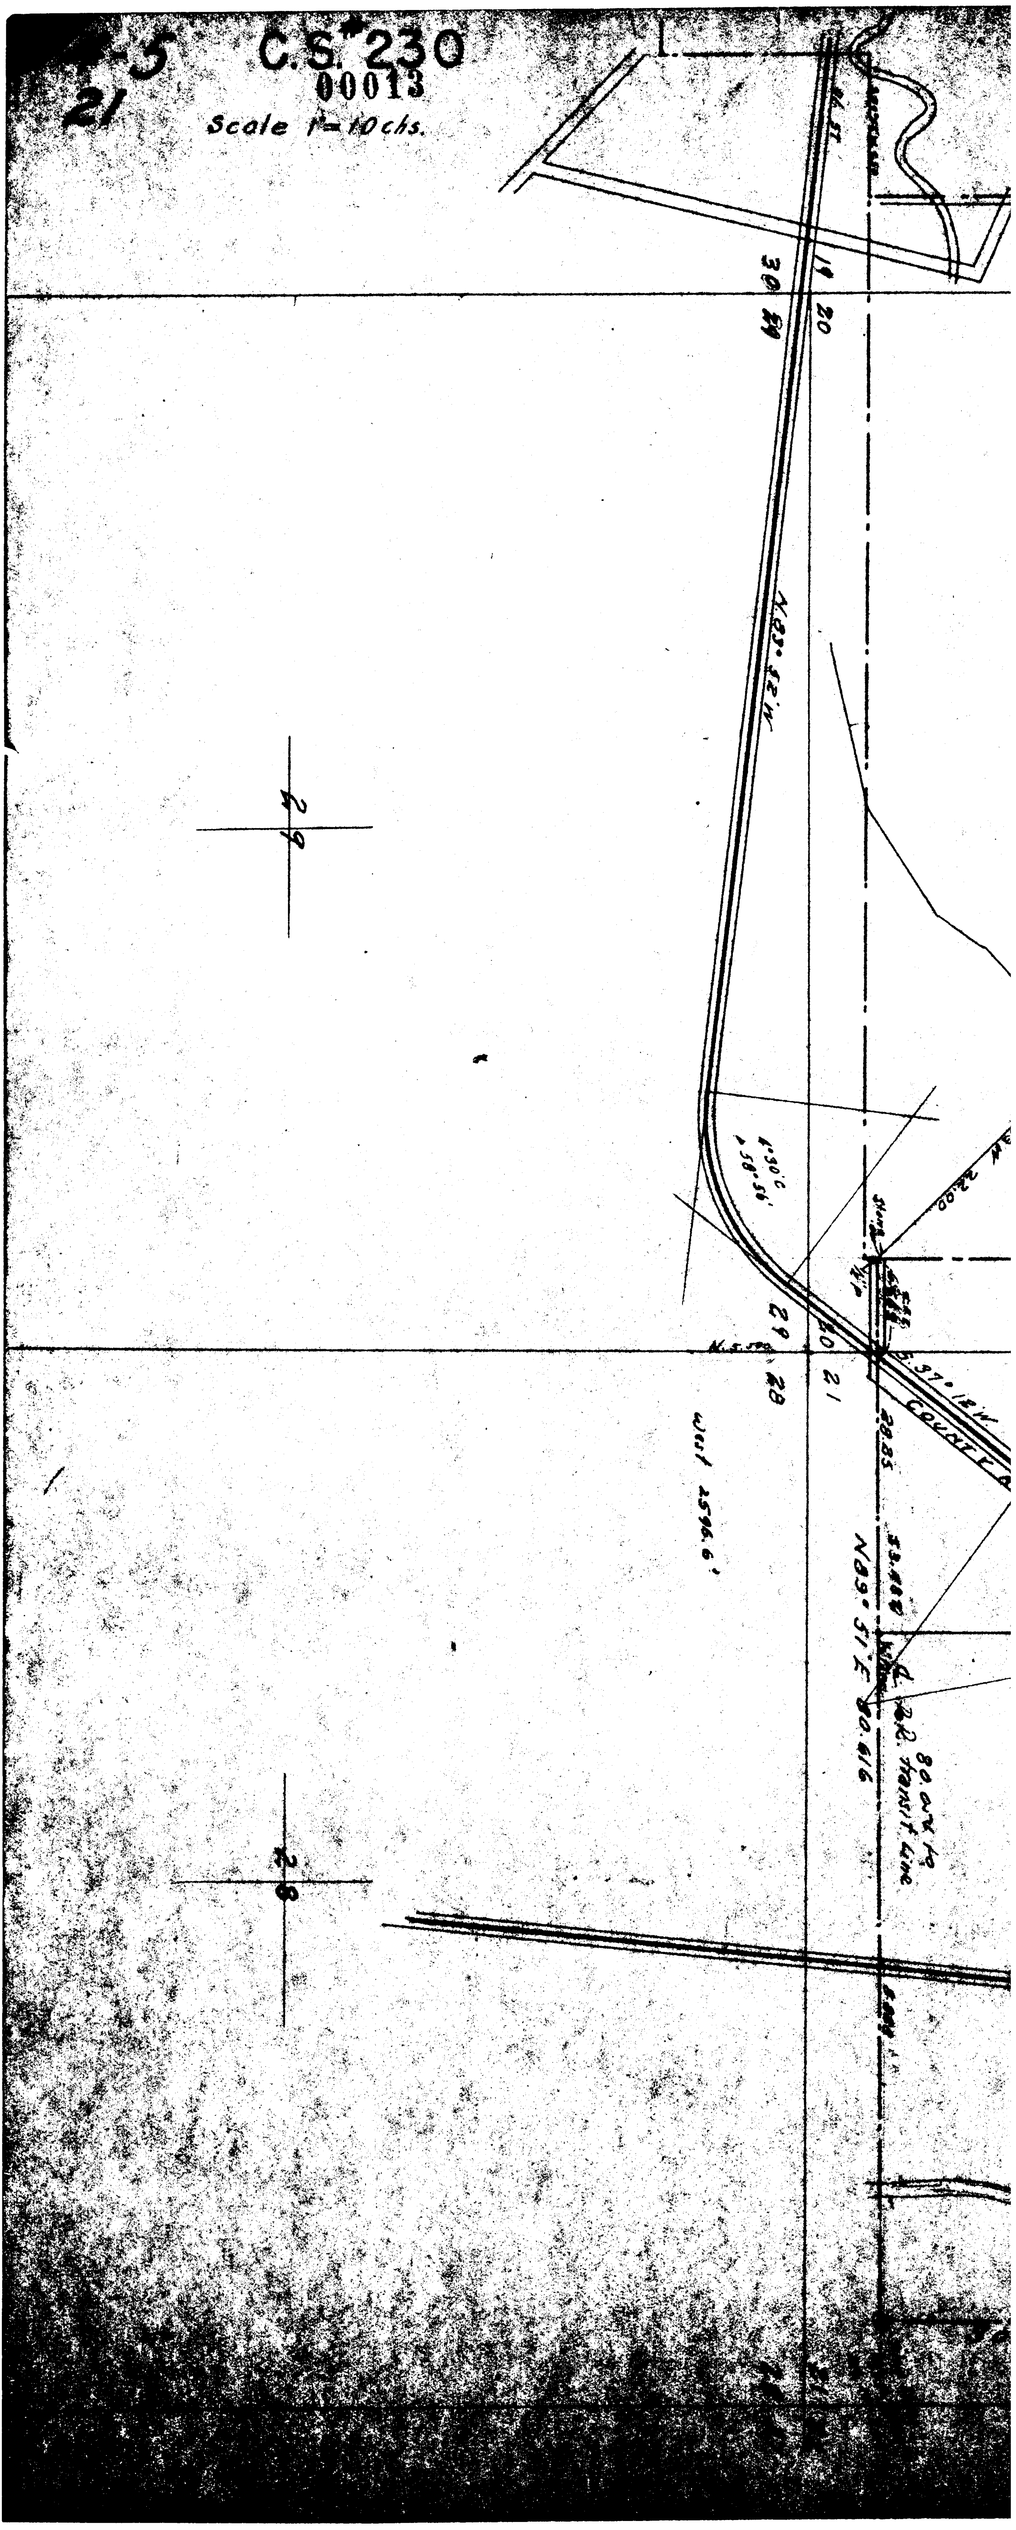

C.S. 230
00013
Scale 1"=10 chs.
N83° 52' W
West 2596.6'
N89° 51' E 80.616