00005

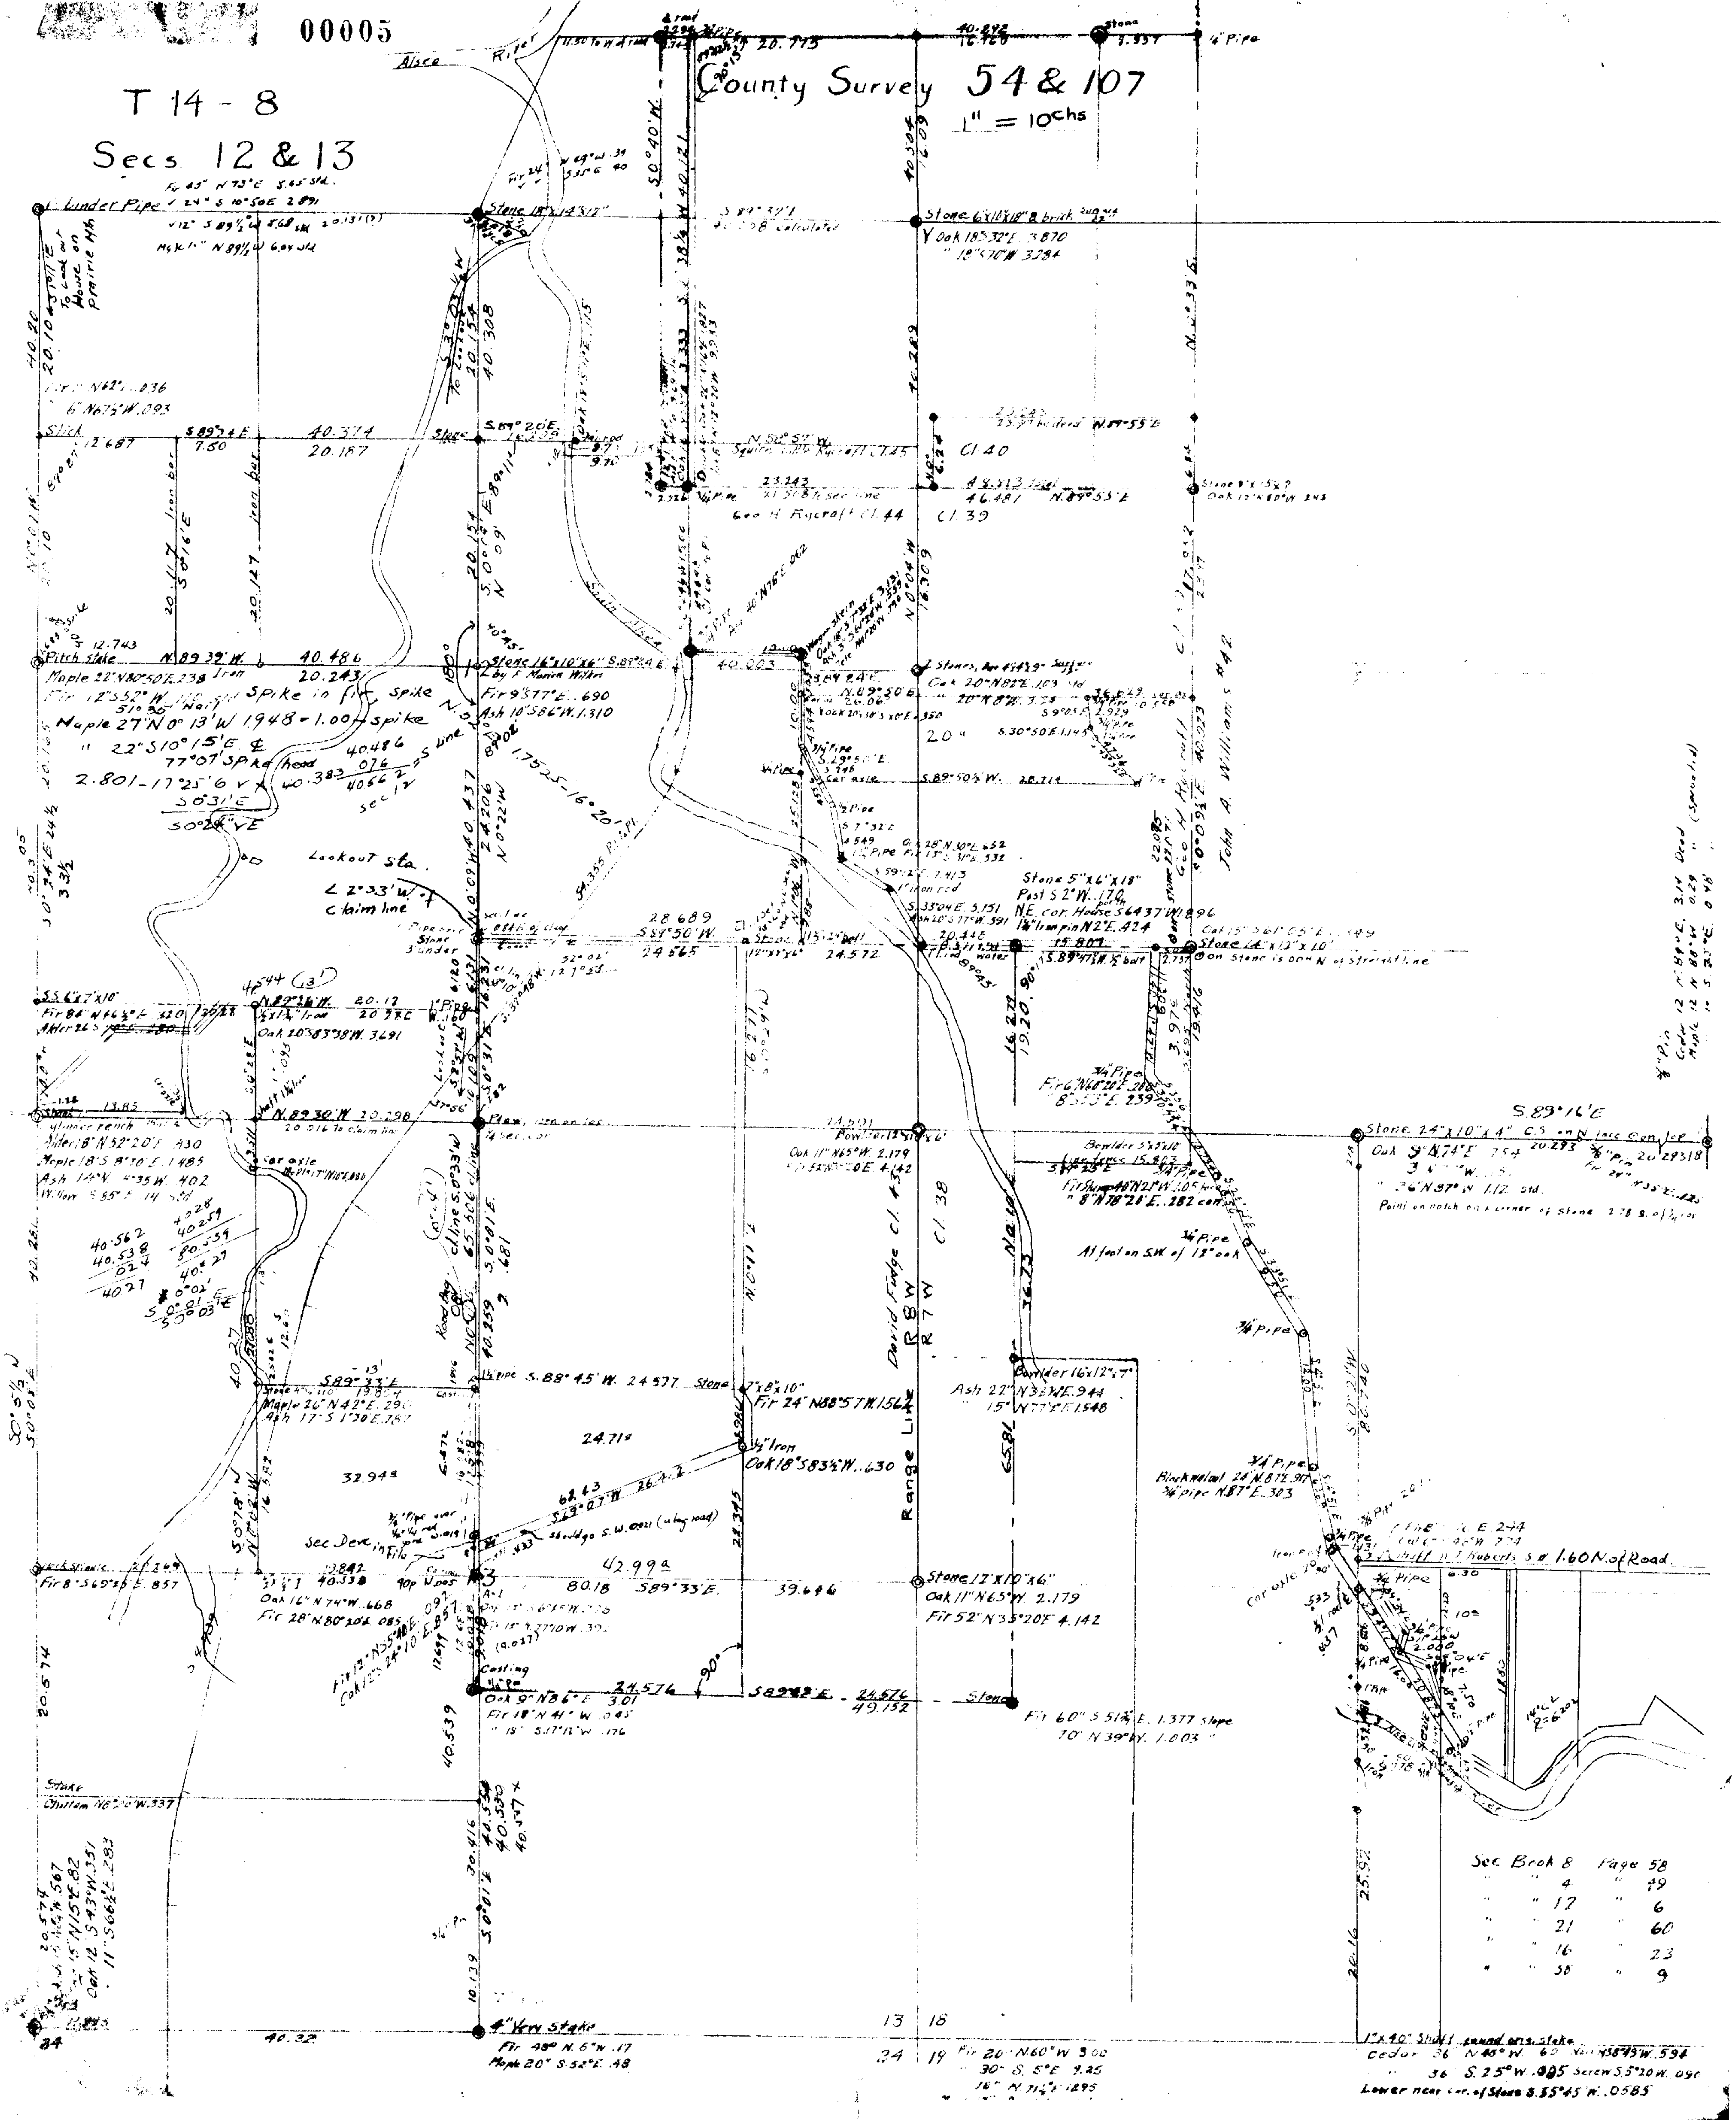

T 14 - 8
Secs 12 & 13
County Survey 54 & 107
1" = 10chs
Alsea River
Stone 18"x14"x12"
Stone 6"x10"x18" & brick
Y Oak 18" S 32° E 3.870
Squire Little Rycroft Cl 45
Geo H Rycroft Cl 44
Cl 40
Cl 39
Stone 16"x10"x6"
Maple 22" N 80°50' E .238
Spike in fir
Maple 27" N 0° 13' W 1.948
Lookout Sta.
claim line
John A. Williams #42
Geo H Rycroft
David Fudge Cl. 43
Cl 38
Range Line
R 8 W
R 7 W
Stone 24"x10"x4"
S. 89° 16' E
Point on notch on corner of Stone 2.78 S. of 1/4 cor
Boulder 16"x12"x7"
Ash 22" N 33 1/4° E .944
15" N 77° E 1.548
Stone 12"x10"x6"
Oak 11" N 65° W. 2.179
Fir 52" N 35°20' E 4.142
Fir 60" S 51 1/4° E. 1.377 slope
70" N 39° W. 1.003
Sec Dev in File
42.99a
24.71a
32.94a
1.60 N. of Road
Sec Book 8 Page 58
" " 4 " 49
" " 12 " 6
" " 21 " 60
" " 16 " 23
" " 38 " 9
4" Yew Stake
Fir 48" N. 6° W. .17
Maple 20" S. 52° E. .48
13
18
24
19
Fir 20" N. 60° W 3.00
" 30" S. 5° E 4.25
16" N. 71 1/4° E 12.95
1"x40" Shaft found orig. stake
Lower near cor. of Stone S. 55°45' W. .0585