14-8 00007

18 & 19

COUNTY SURVEY Nº 362

Scale: 1" = 10 chains
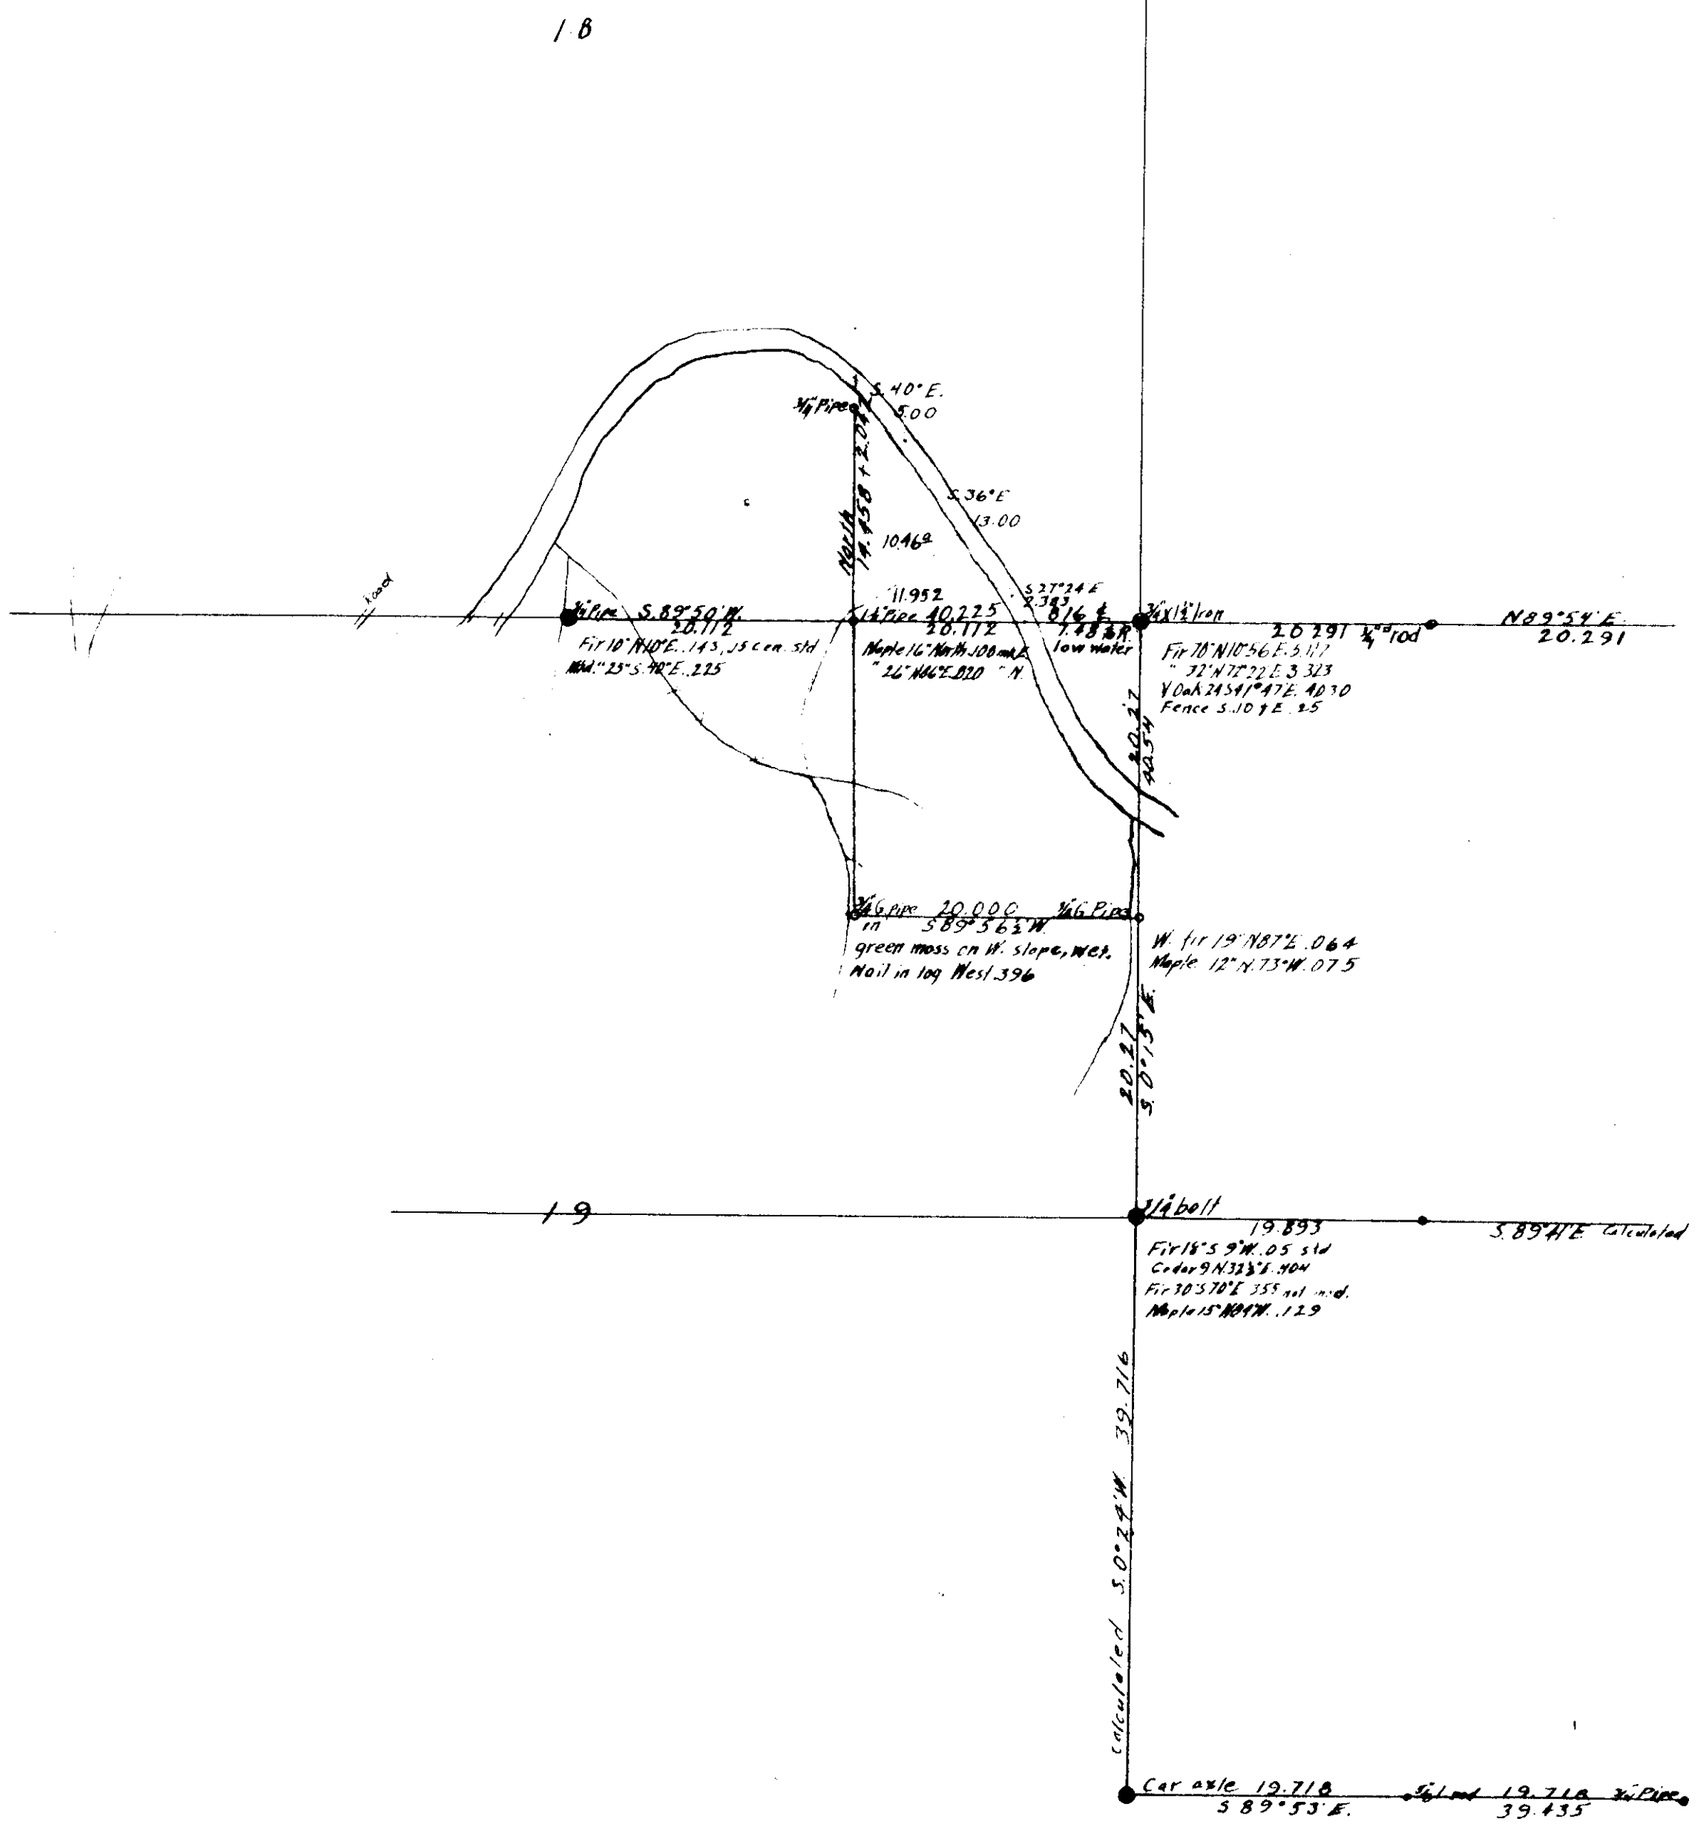
W. C. Galloway C.S.
Dec. 2, 1944.