COUNTY SURVEY No. 362

Scale: 1 in. = 10 chains

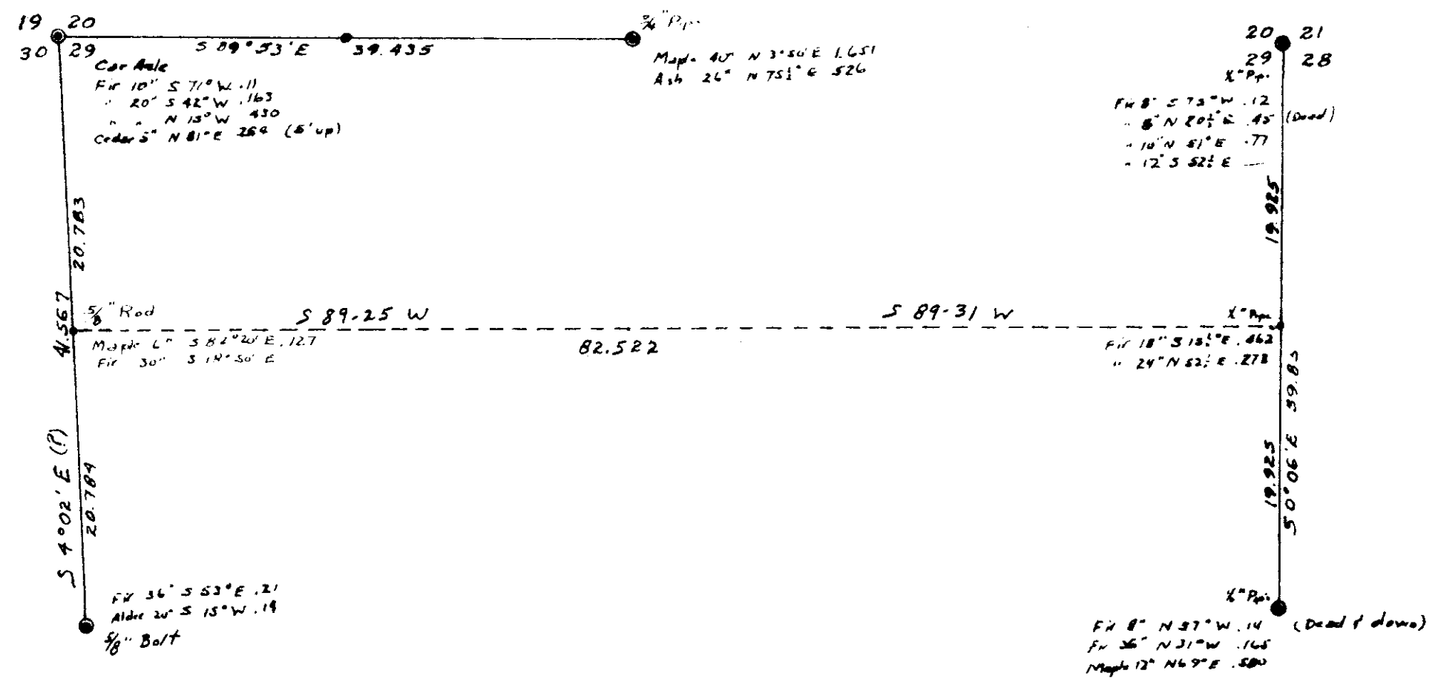

C.S. 362

14-8
29 & 30

00010