15-4
5.8

[redacted]
00001

COUNTY SURVEY 52
T. 15 S., R. 4 W., W.M.
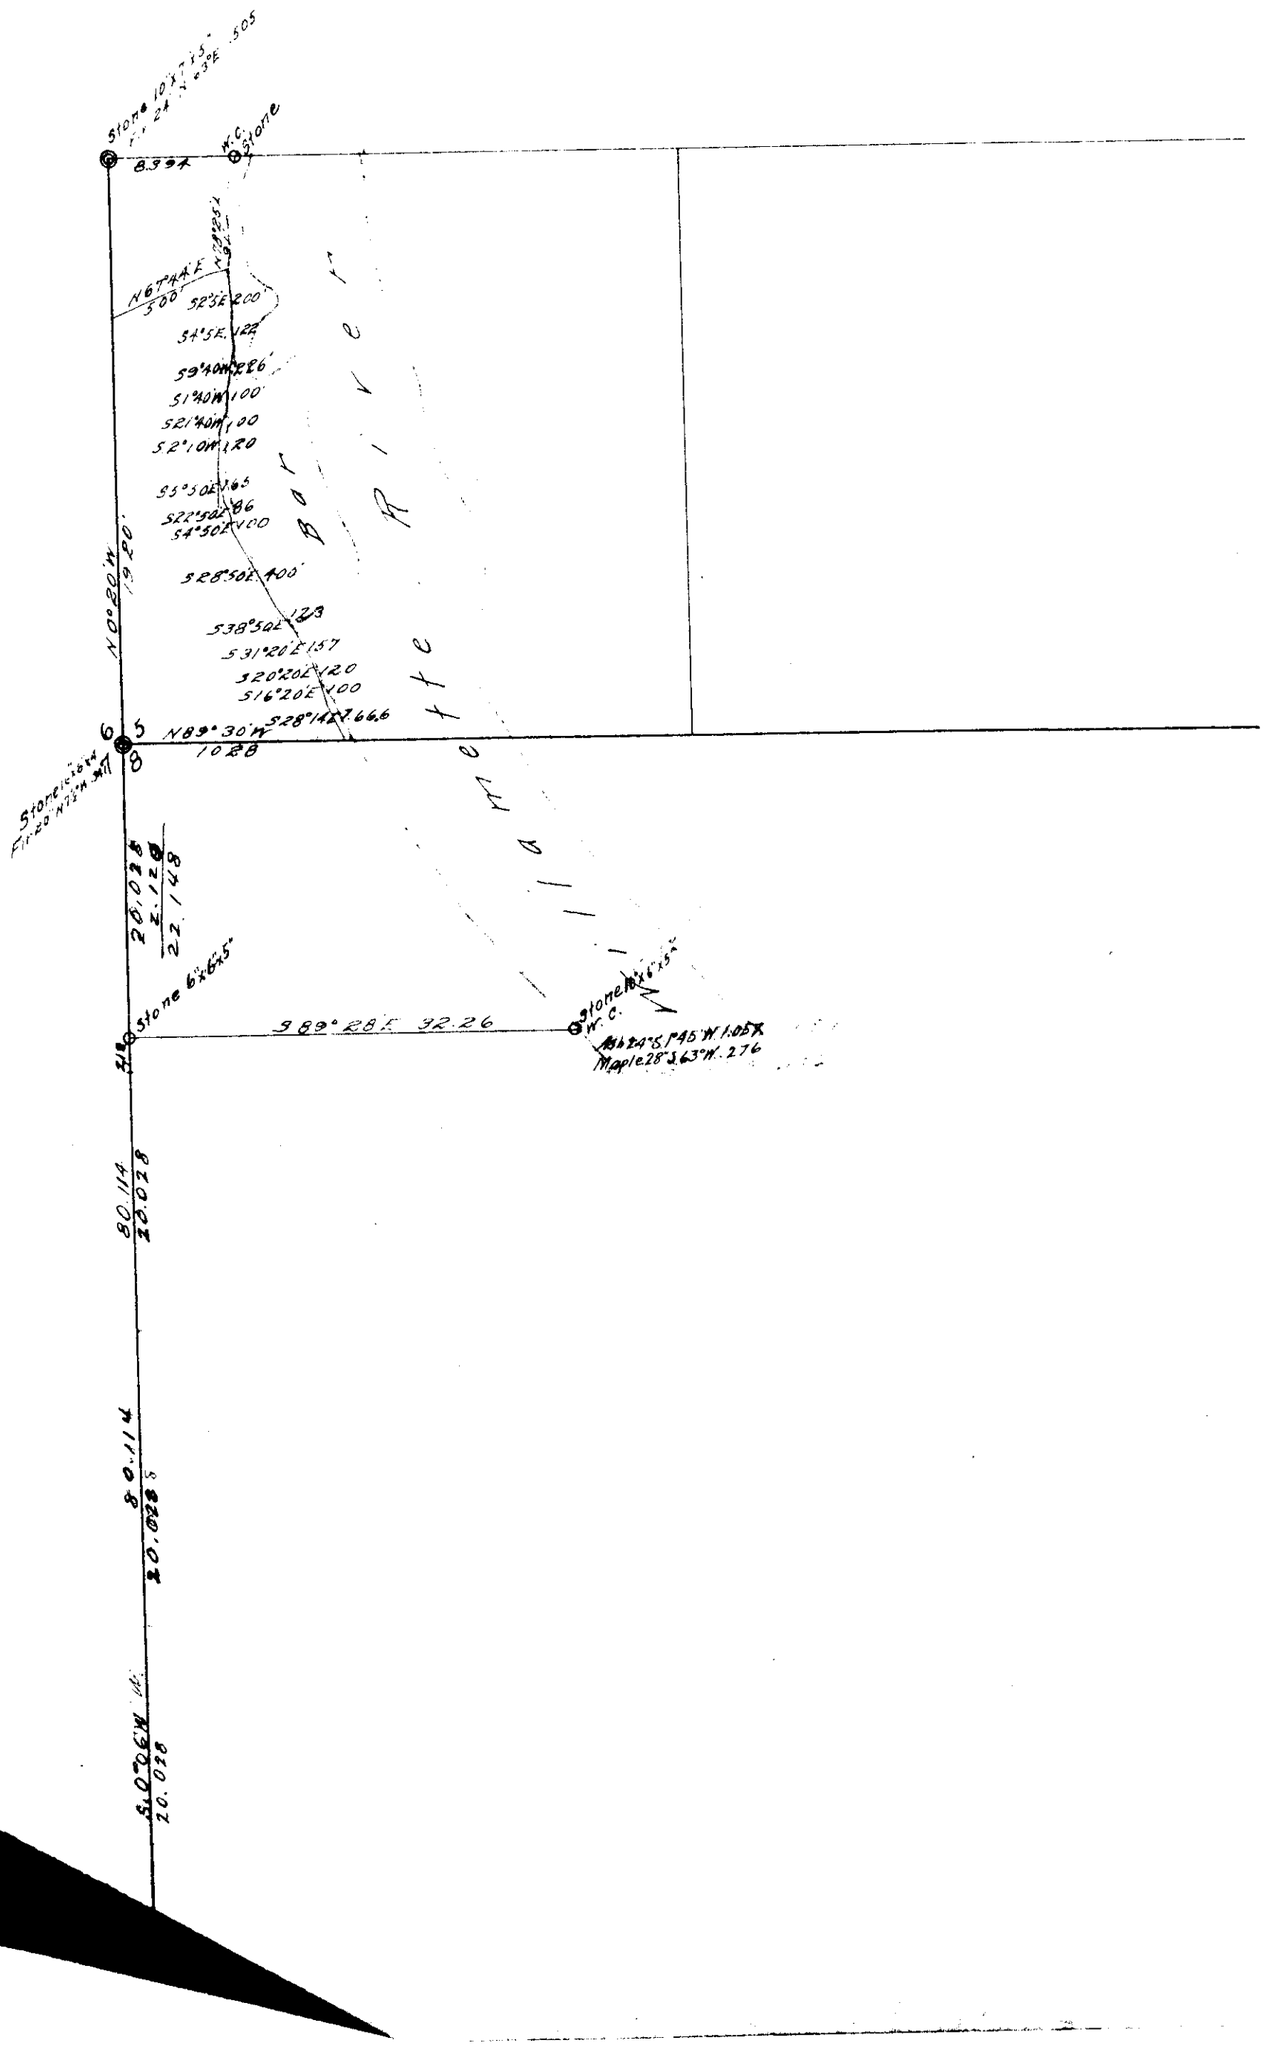
60