15-6 00002

3, 4

C.S. 307

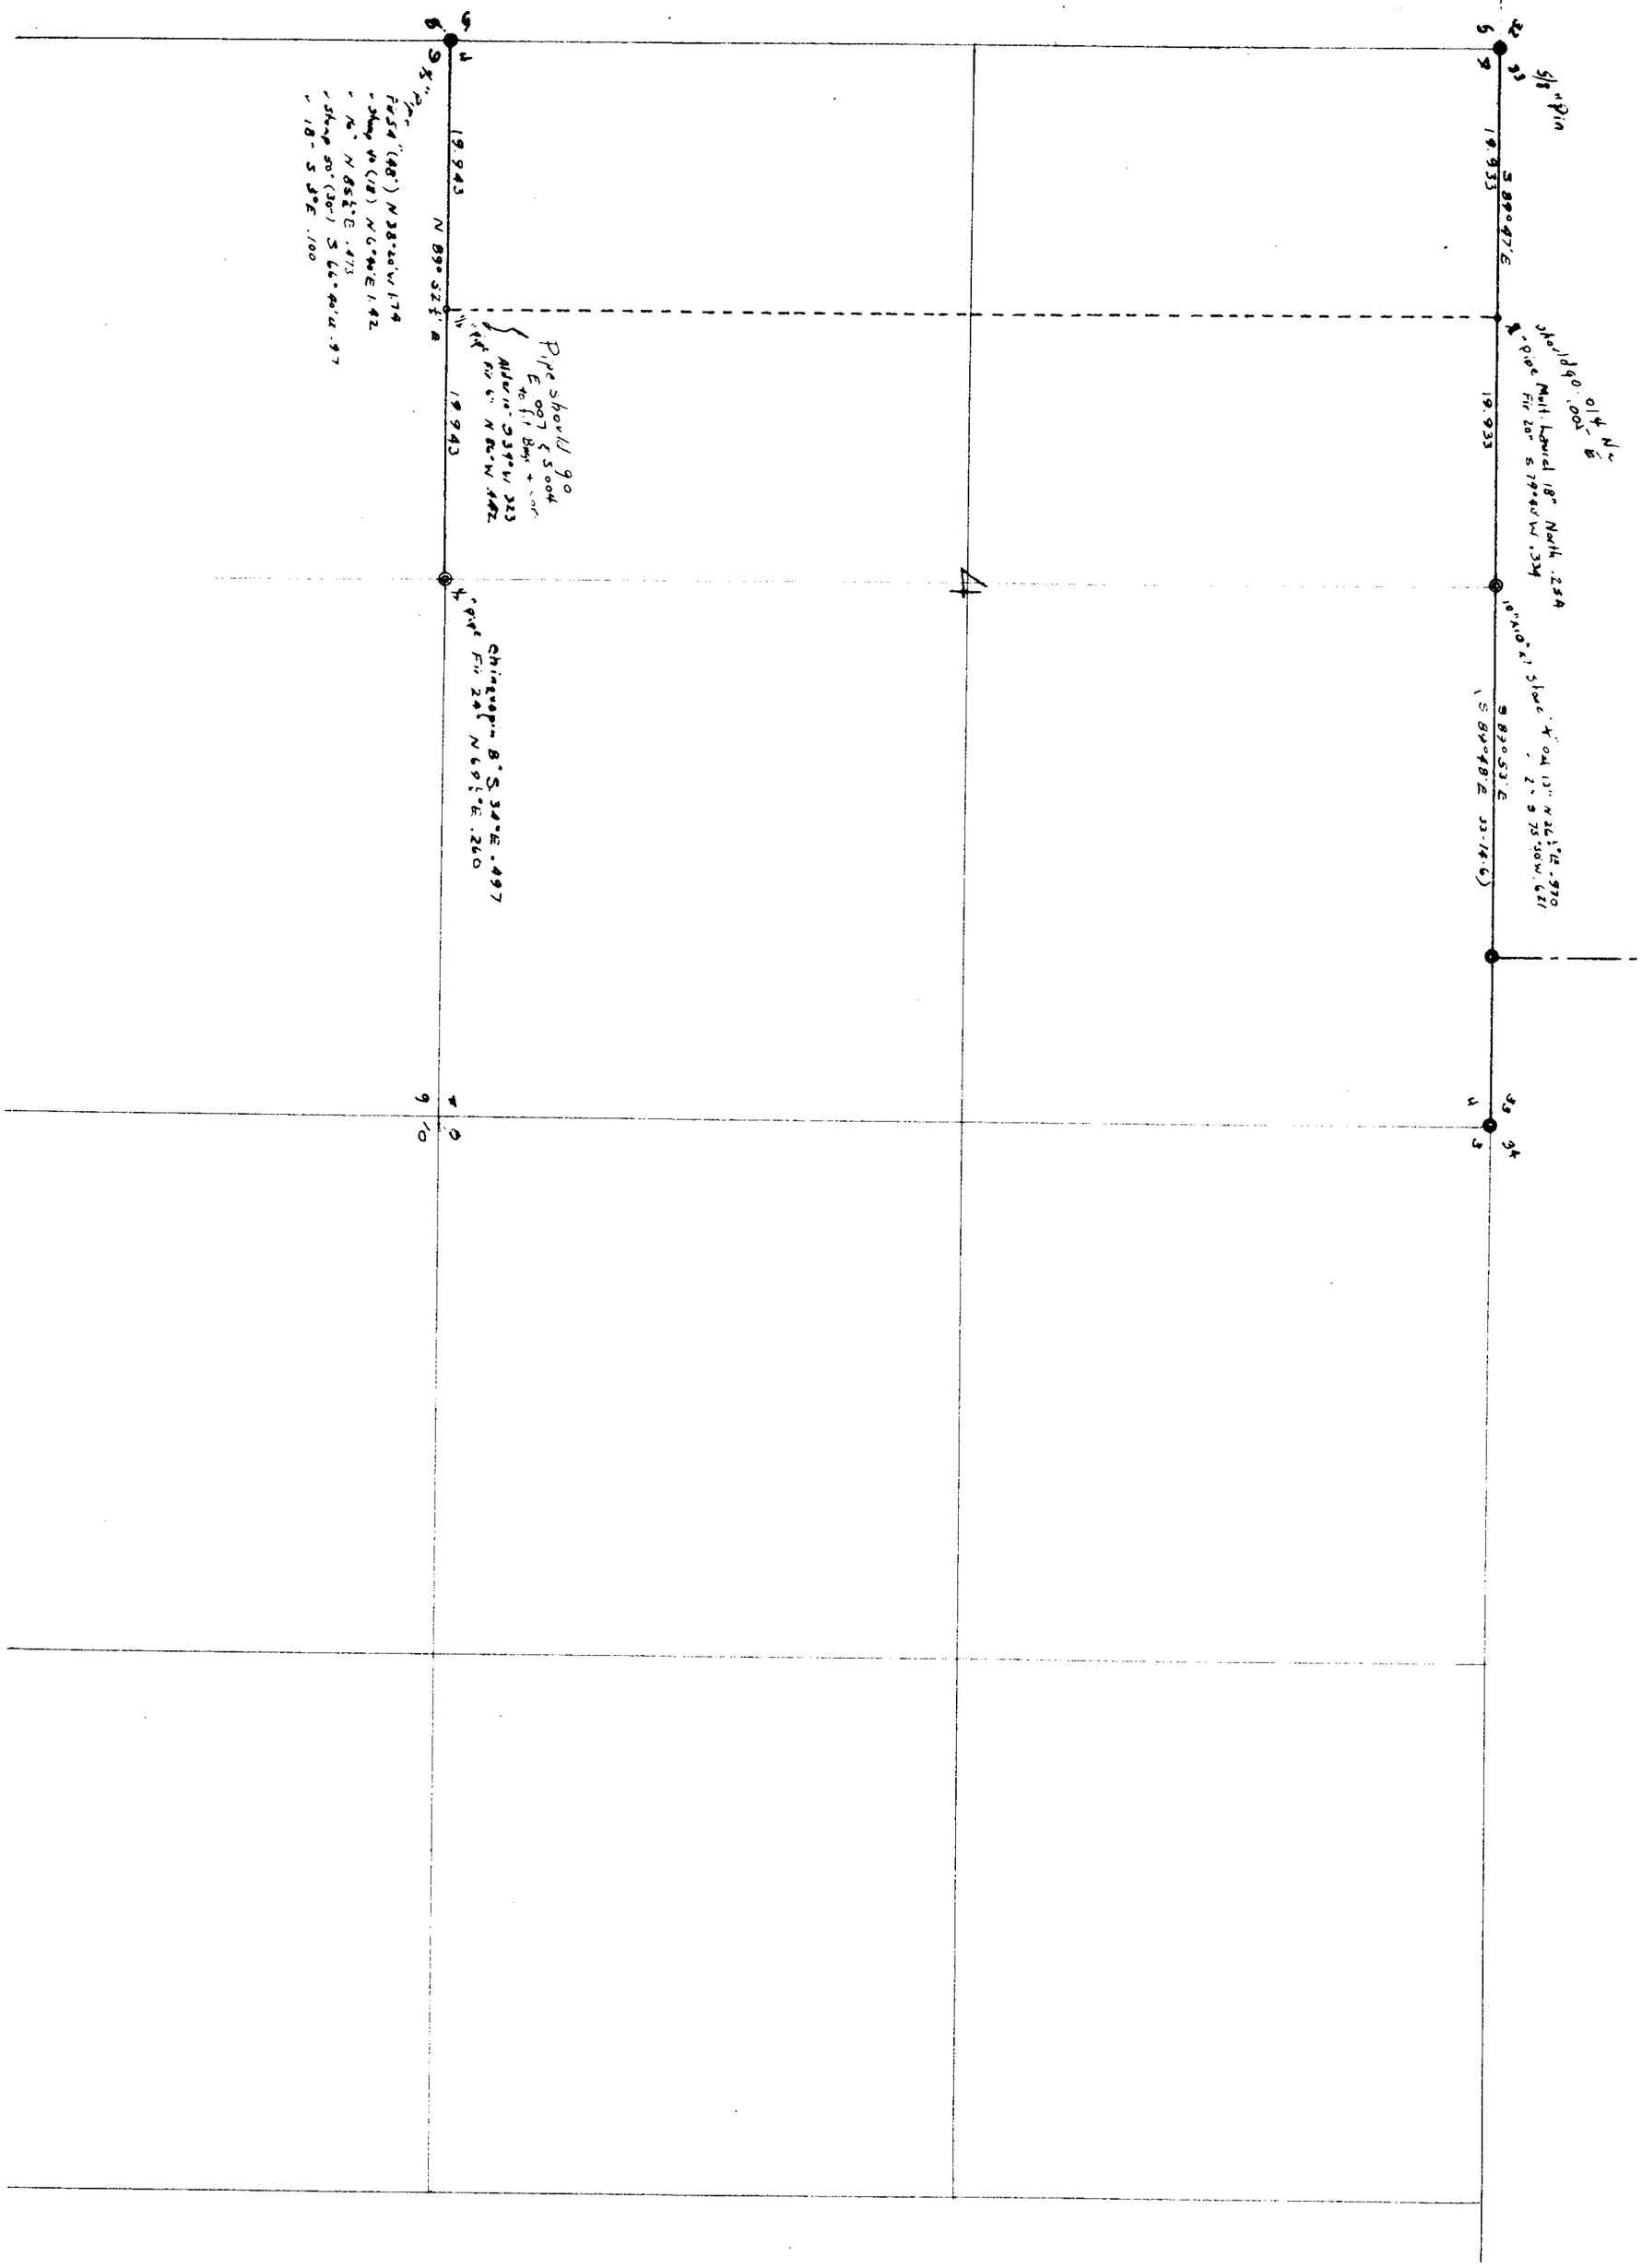

COUNTY SURVEY No. 307

Scale: 1-in. = 10 ch.