14-2-1

Bk 3
College Hill
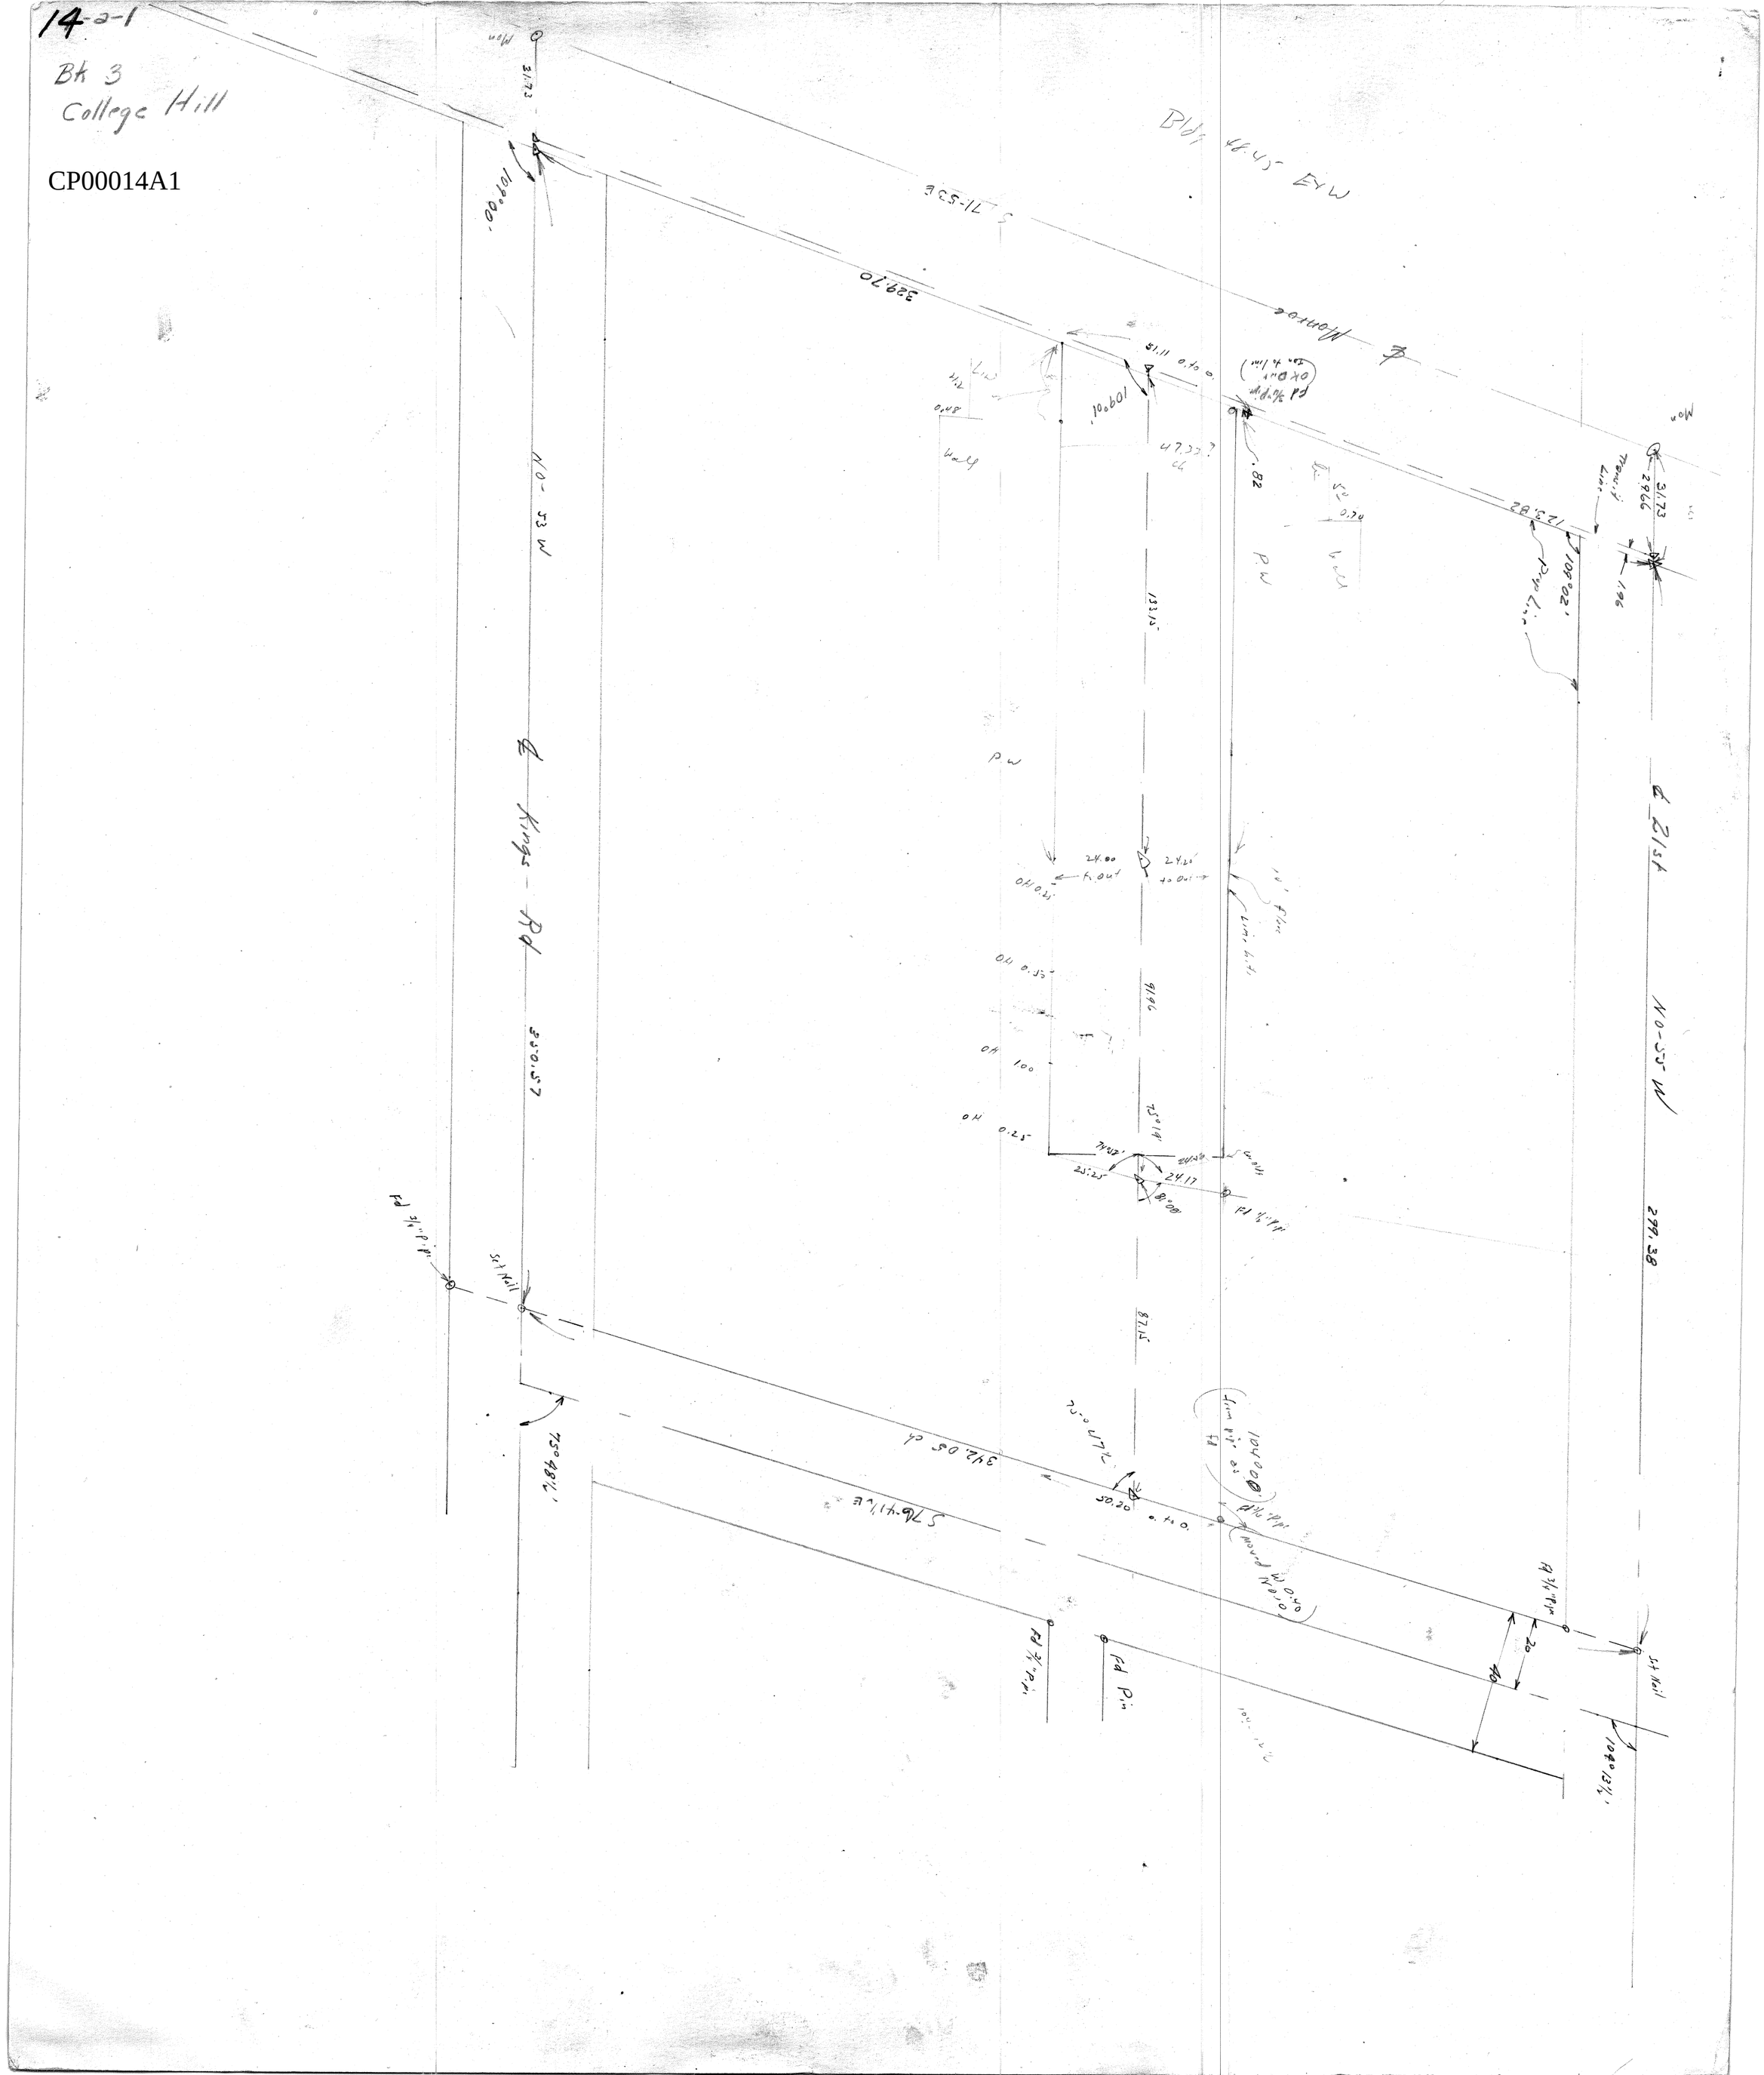
CP00014A1