16c 00016c

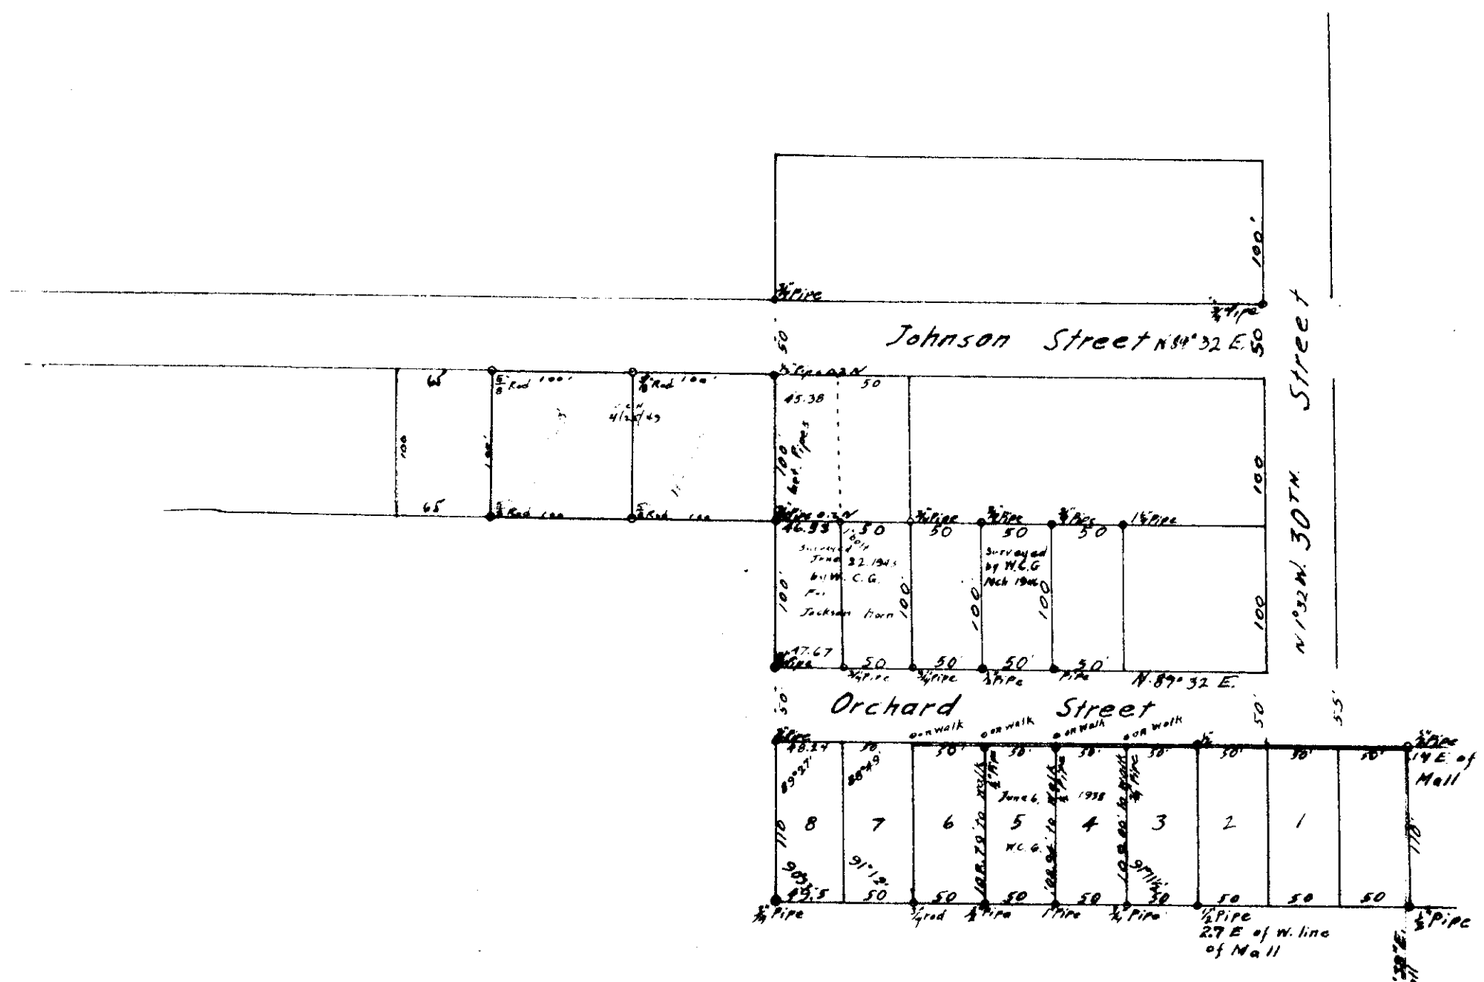

37