Benton County
Surveyor's Office
B.S. FILE NO CCR 20
FILING DATE 6-7-05
SIZE 18x24

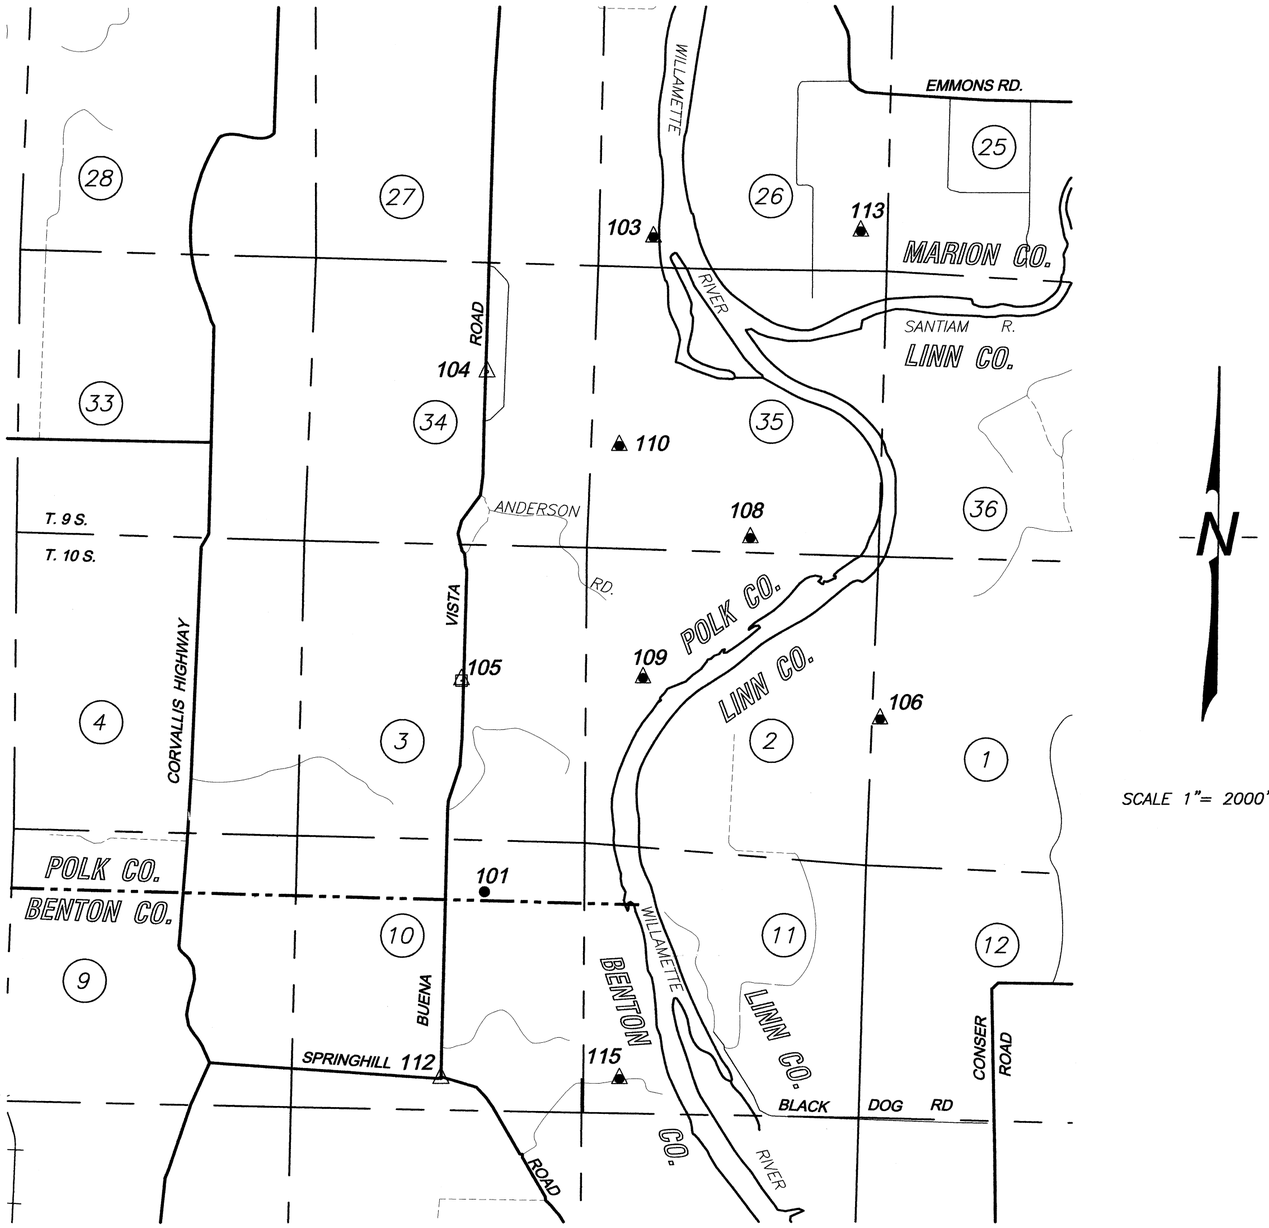

SCALE 1"= 2000'

LEGEND

- ▲ SET 6" SPIKE NAIL (REMOVED)
- △ SET "PK" NAIL MAPPING CONTROL POINT
- ● SET 5/8" IRON ROD WITH ALUMINUM CAP STAMPED "BV 2005"
- ⌂ FOUND HUB & TACK

REPORT OF SURVEY

LOCATED IN SECTIONS 26, 27, 34 & 35 OF TOWNSHIP 9 SOUTH, RANGE 4 WEST AND SECTIONS 2, 3, 10 & 11 OF TOWNSHIP 10 SOUTH, RANGE 4 WEST, OF THE WILLIMATTE MERIDIAN IN BENTON, LINN, MARION AND POLK COUNTIES, OREGON, FOR THE OREGON PARKS AND RECREATION DEPARTMENT.

NARRATIVE

THE PURPOSE OF THIS SURVEY IS TO REPORT THE MAPPING CONTROL ESTABLISHED FOR THE OREGON PARKS AND RECREATION DEPARTMENT PER ORS 209.250(5b). THE RESULTING CONTROL IS BY NO MEANS MEANT TO BE A DENSIFICATION OF ANY EXISTING GEODETIC CONTROL.

CONTROL WAS ESTABLISHED USING THE GLOBAL POSITIONING SYSTEM (GPS). COORDINATES ARE IN THE OREGON COORDINATE SYSTEM OF 1983(CORS96)(EPOCH 2002), NORTH ZONE AND THE NORTH AMERICAN VERTICAL DATUM OF 1988 GEOID03 AS BASED ON SINGLE POINT CONTROL CALCULATED BY THE NATIONAL GEODETIC SURVEY (NGS) ONLINE POSITIONING USER SERVICE (OPUS) FOR POINT NUMBER 101.

ALL 6" SPIKE NAILS WERE REMOVED BY LANDOWNERS REQUESTS AFTER AERIAL FLIGHTS WERE MADE.

MAPPING POINT CONTROL

NAME	LATITUDE	LONGITUDE	NORTHING	EASTING	ELEVATION	DESCRIPTION
101	44°43'13.964"N	123°09'37.431"W	395599.681	7510737.628	187.30	Set Iron Rod w/Alum. Cap
103	44°45'14.850"N	123°08'59.326"W	407745.419	7513889.021	275.95	Set Nail
104	44°44'49.252"N	123°09'41.080"W	405253.374	7510792.085	183.75	Set PK
105	44°43'52.461"N	123°09'45.160"W	399514.732	7510308.290	181.47	Fnd Hub & Tack
106	44°43'47.850"N	123°07'57.056"W	398792.344	7518093.160	177.15	Set Nail
108	44°44'20.326"N	123°08'31.947"W	402161.770	7515683.136	173.45	Set Nail
109	44°43'54.001"N	123°08'58.437"W	399559.794	7513684.643	180.67	Set Nail
110	44°44'36.421"N	123°09'06.422"W	403872.440	7513249.503	373.50	Set Nail
112	44°42'39.967"N	123°09'47.540"W	392182.594	7509894.641	189.17	Set PK
113	44°45'17.108"N	123°08'05.947"W	407848.031	7517746.378	177.85	Set Nail
114	44°43'18.130"N	123°09'27.208"W	395997.061	7511489.224	187.45	Set Nail
115	44°42'40.488"N	123°09'01.091"W	392125.041	7513248.975	180.66	Set Nail

6/6/5

REGISTERED
PROFESSIONAL
LAND SURVEYOR
William L. Baierski
OREGON
JANUARY 21, 1992
WILLIAM L. BAIERSKI
2531
RENEWAL DATE 12/31/05

OREGON PARKS AND RECREATION DEPARTMENT
725 SUMMER STREET. NE, SUITE C
SALEM OR, 97301-1271

LUCKIAMUTE LANDING

SEC. 25-27, 33-35 T9 S,; R. 4 W.; W.M.
SEC. 2, 3, 10 & 11, T. 10 S,; R. 4 W.; W.M.
BENTON, LINN, MARION & POLK COUNTIES, OREGON

DATE: APRIL 7, 2005 PAGE 1 / 1

Le Report.dwg